


FED. RD. DIVISION	STATE	PROJECT
2	OHIO	

291
646

40
54

CUYAHOGA COUNTY
CUY-71-17.83
CUY-176-12.76

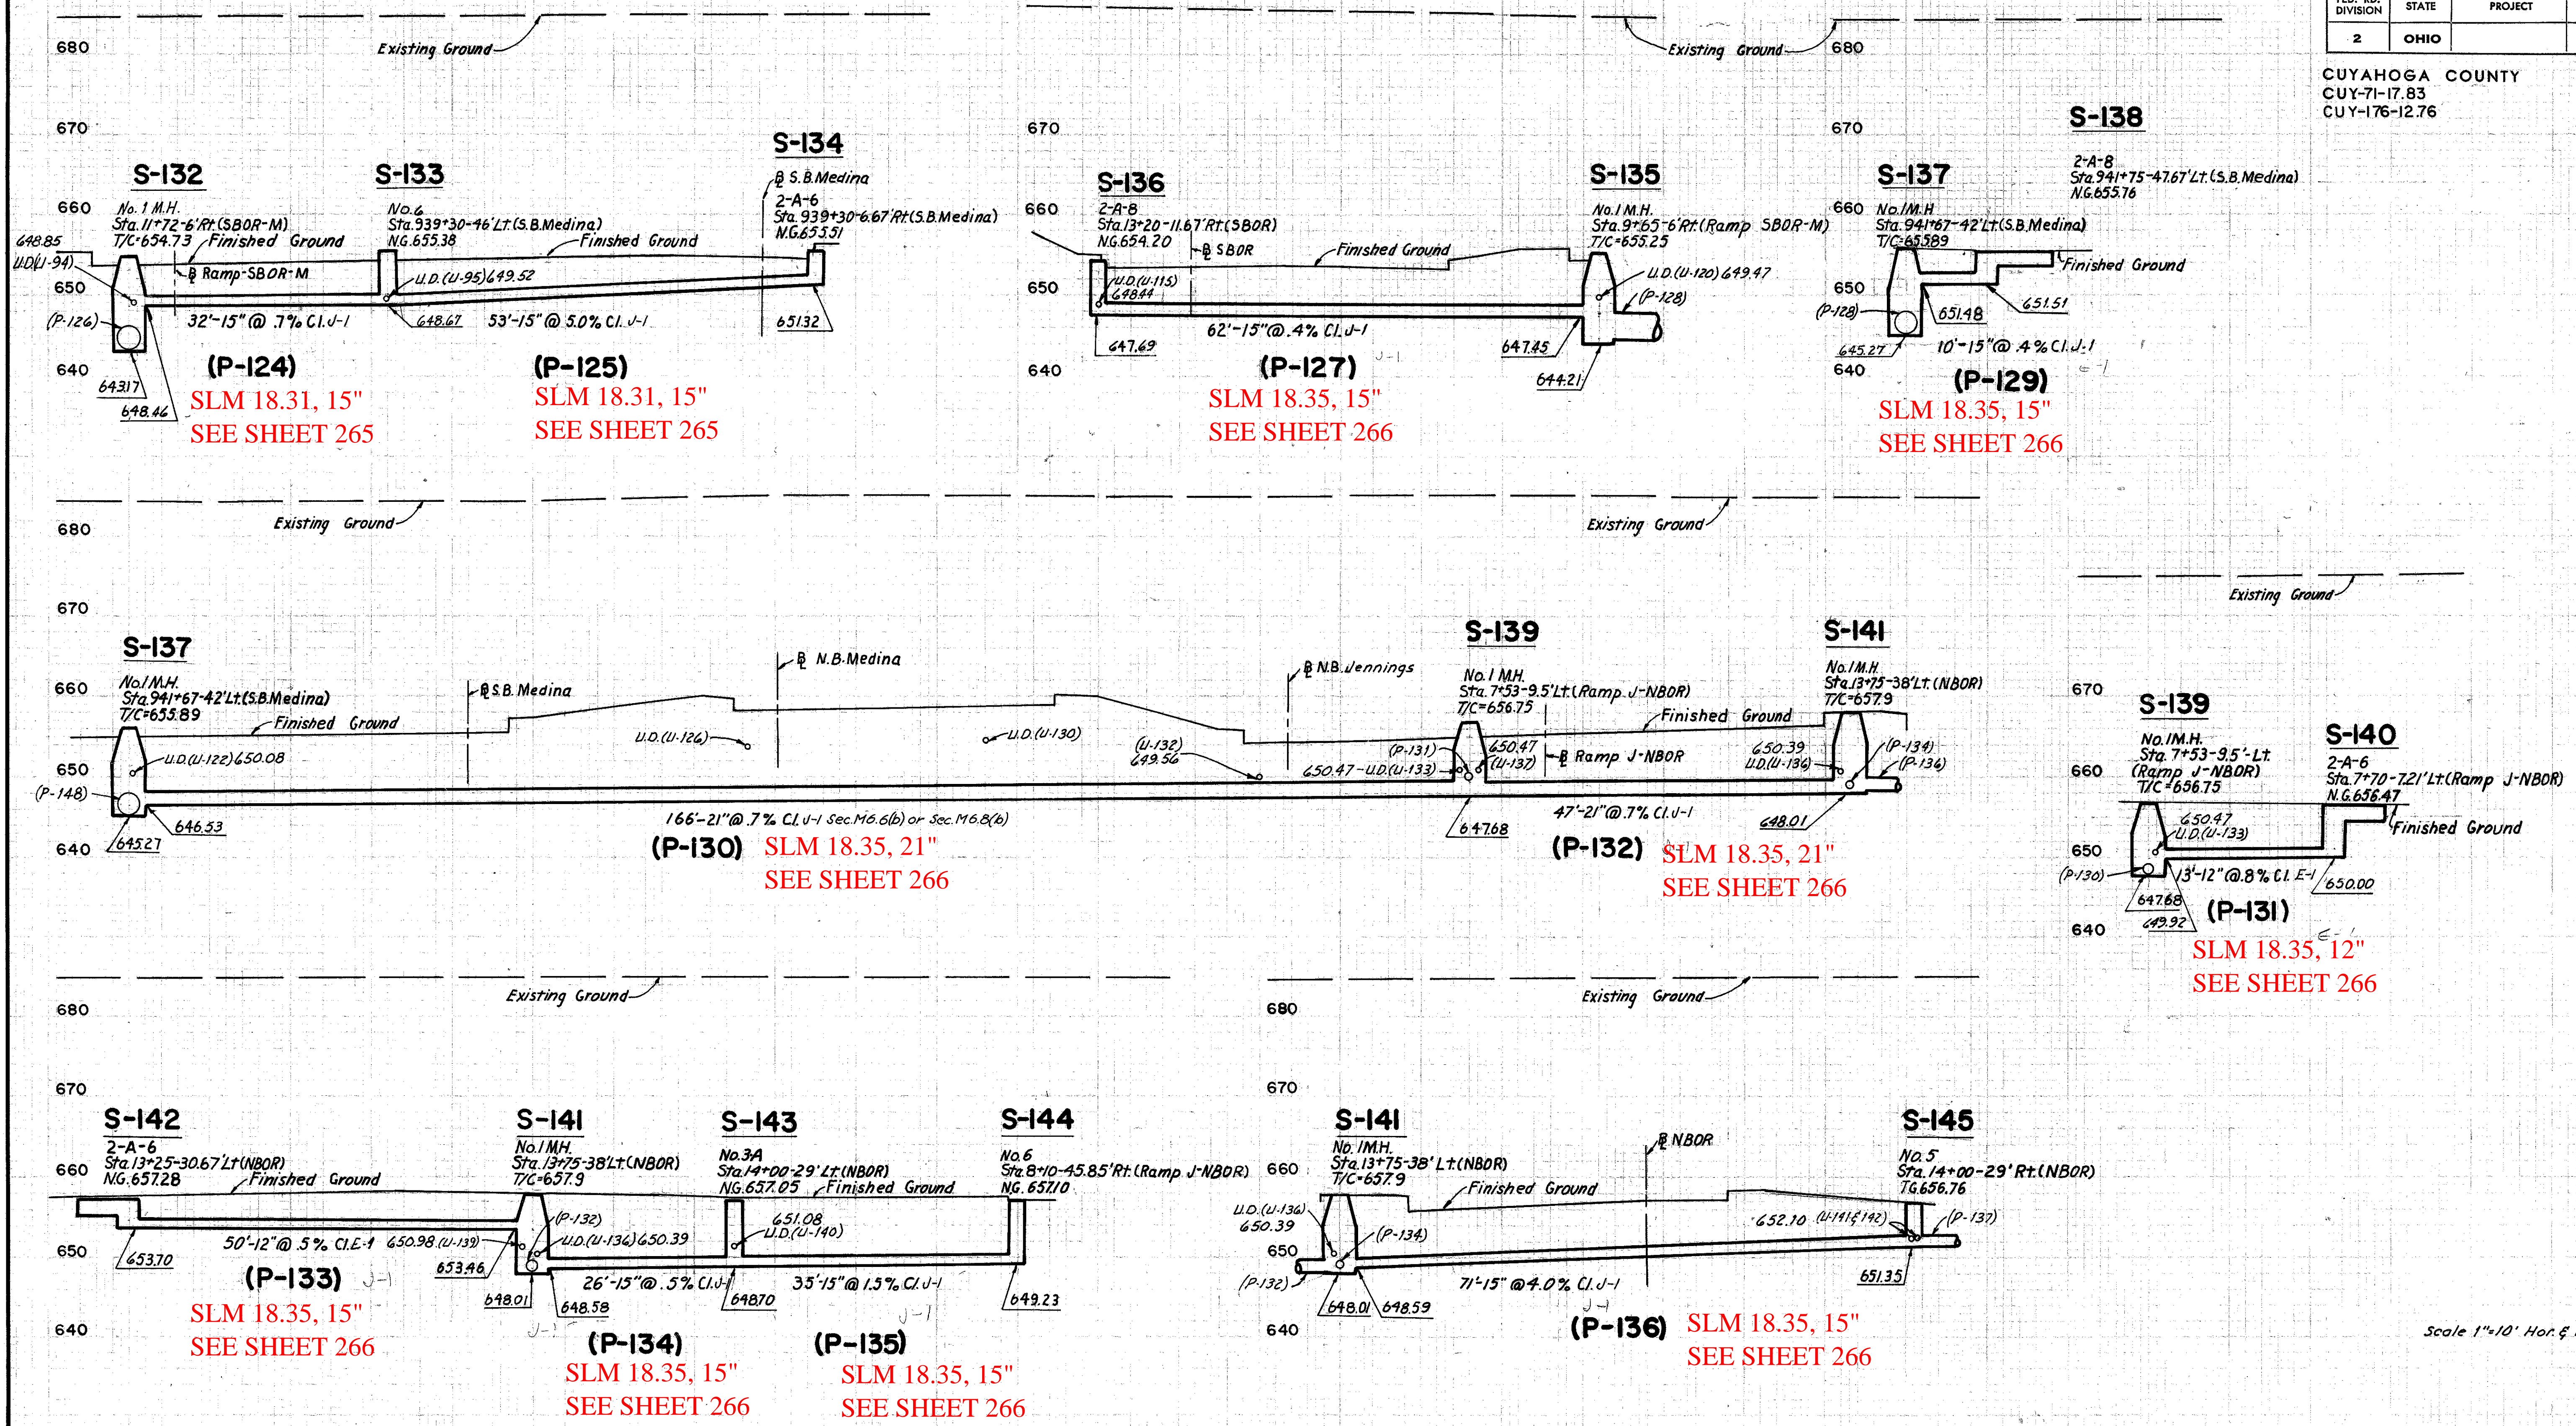

R.D.J. 9-18-64
J.M.C. 10-27-64

Scale 1"=10' Hor. & Vert.