


R.O.J. 9-21-64
J.M.D. 10-28-64

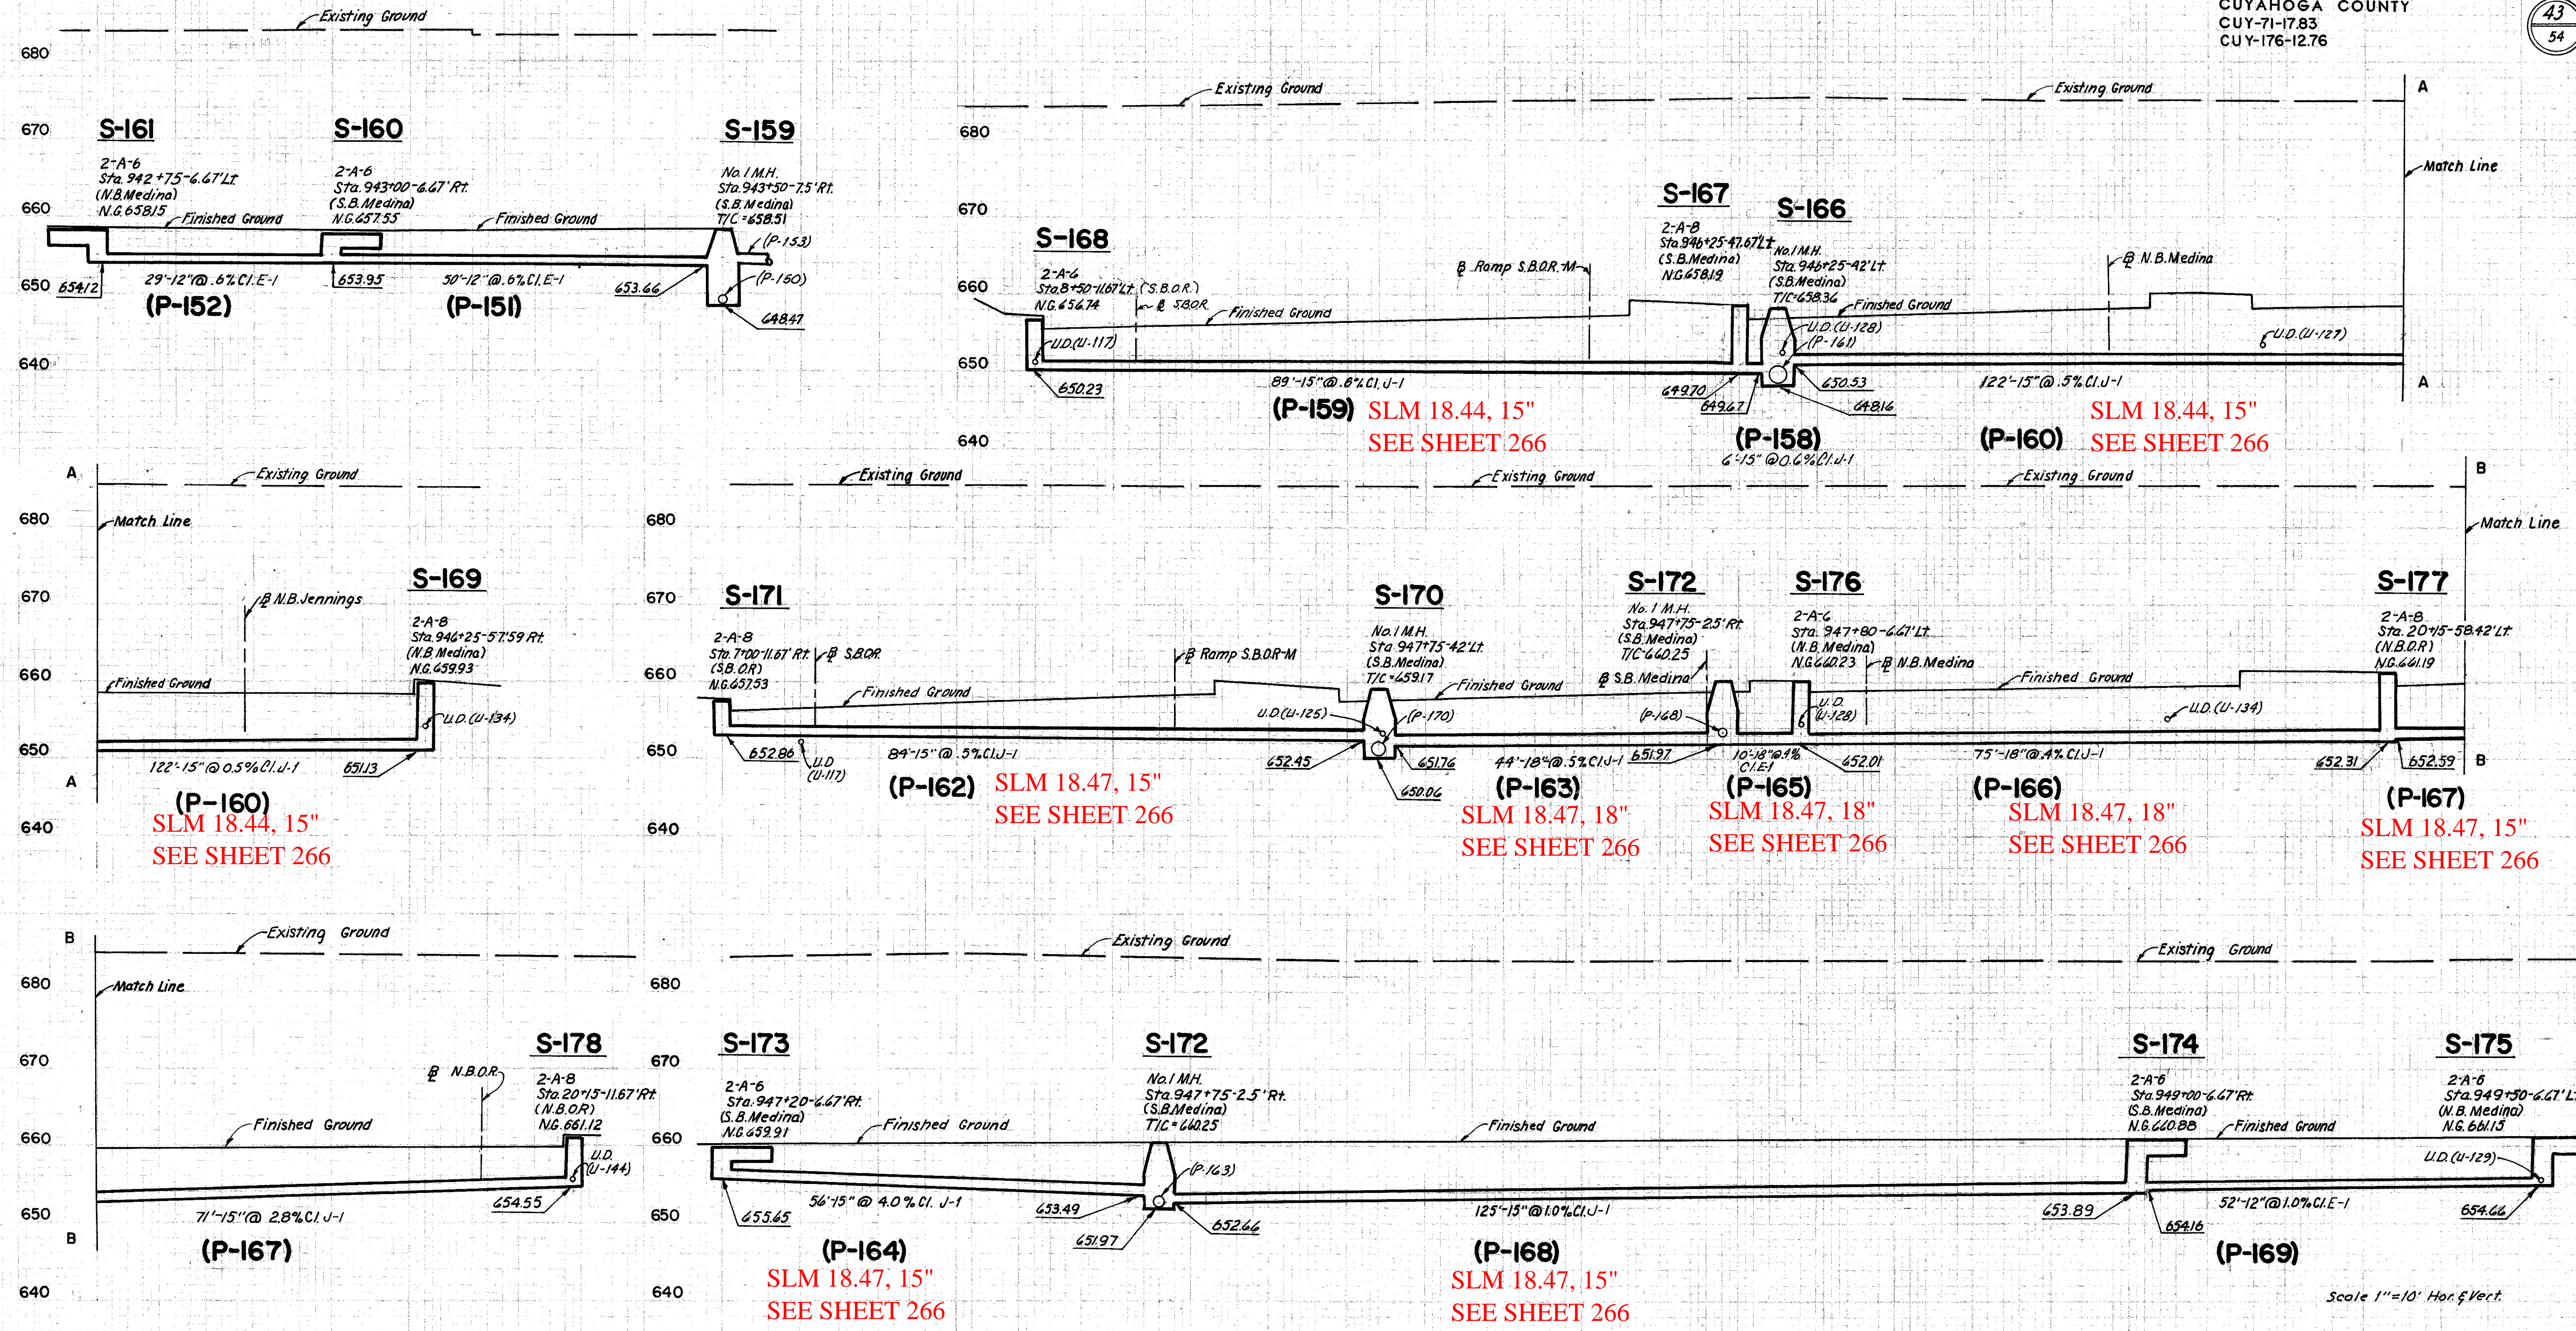

Scale 1"=10' Hor. & Vert.

P-157 & P-161 SEE SH. 44.