


|                   |       |         |
|-------------------|-------|---------|
| FED. RD. DIVISION | STATE | PROJECT |
| 2                 | OHIO  |         |

295  
646

CUYAHOGA COUNTY  
CUY-71-1783  
CUY-176-12.76

44  
54

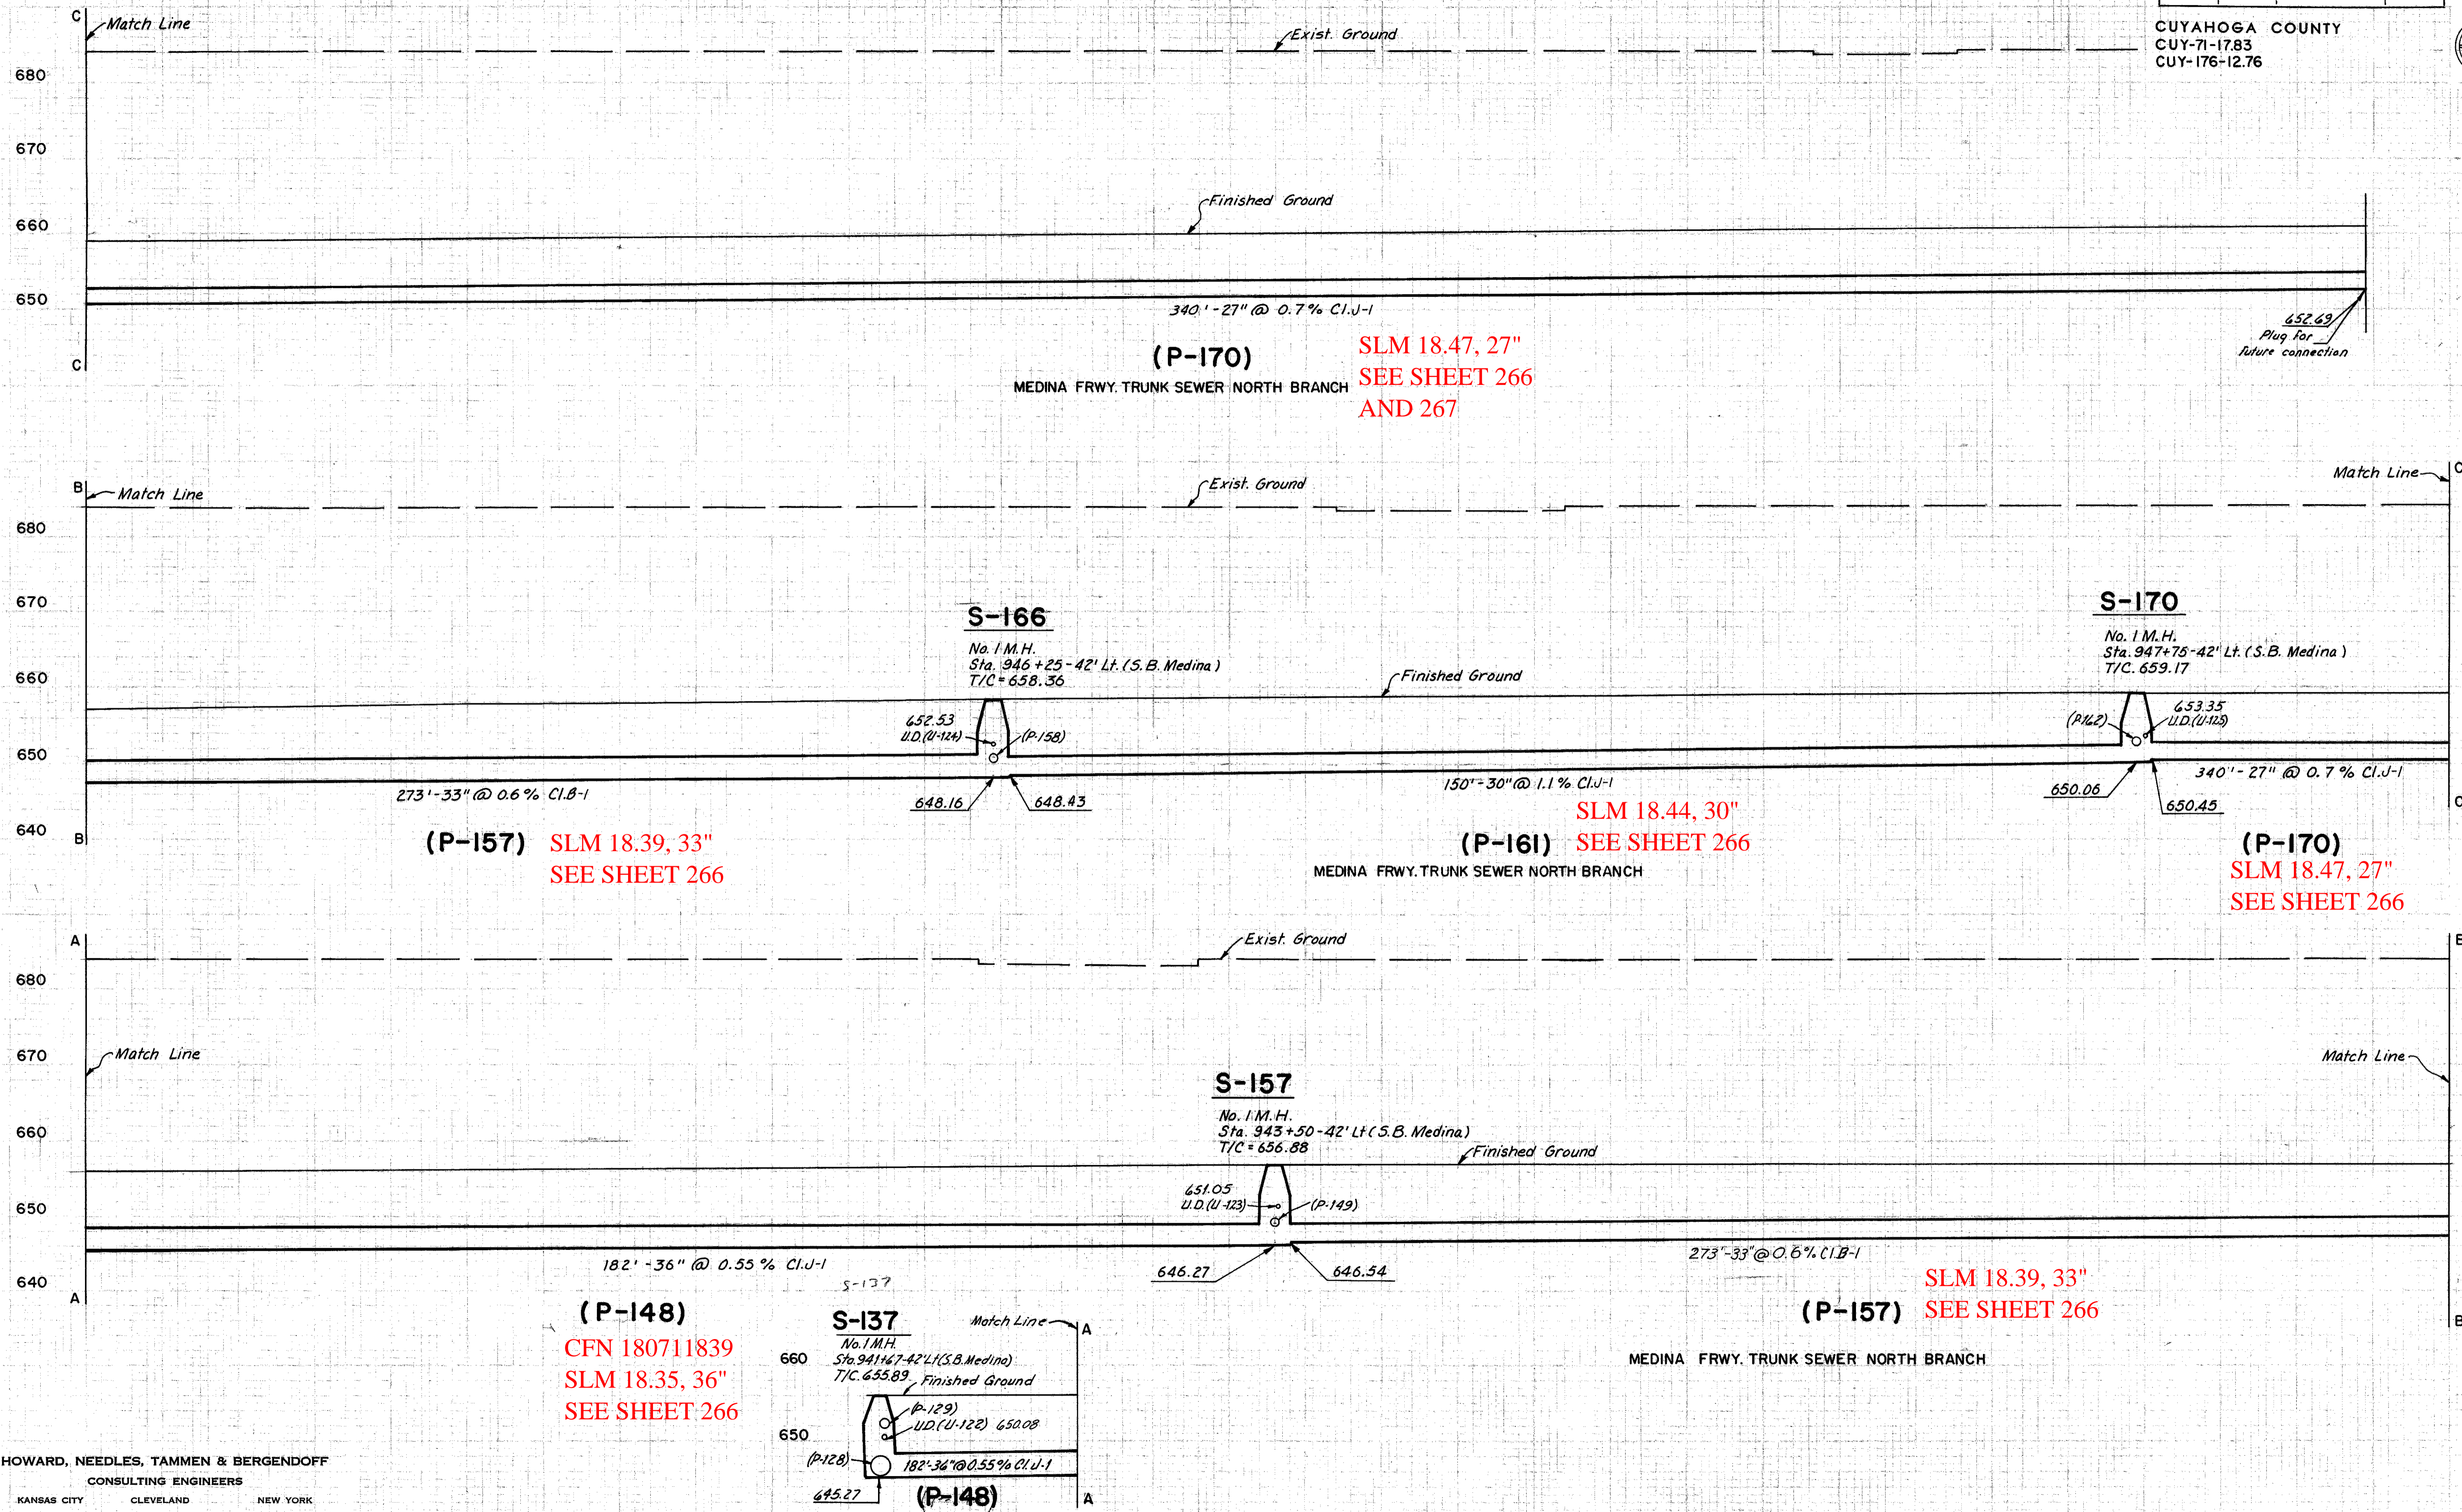

(P-157) SLM 18.39, 33"  
SEE SHEET 266

(P-161) SLM 18.44, 30"  
SEE SHEET 266

(P-170) SLM 18.47, 27"  
SEE SHEET 266

(P-148) CFN 180711839  
SLM 18.35, 36"  
SEE SHEET 266

(P-157) SLM 18.39, 33"  
SEE SHEET 266

HOWARD, NEEDLES, TAMMEN & BERGENDOFF  
CONSULTING ENGINEERS  
KANSAS CITY CLEVELAND NEW YORK