


FED. RD. DIVISION	STATE	PROJECT	
2	OHIO		

300  
646

49  
54

CUYAHOGA COUNTY  
CUY-71-1783  
CUY-176-12.76

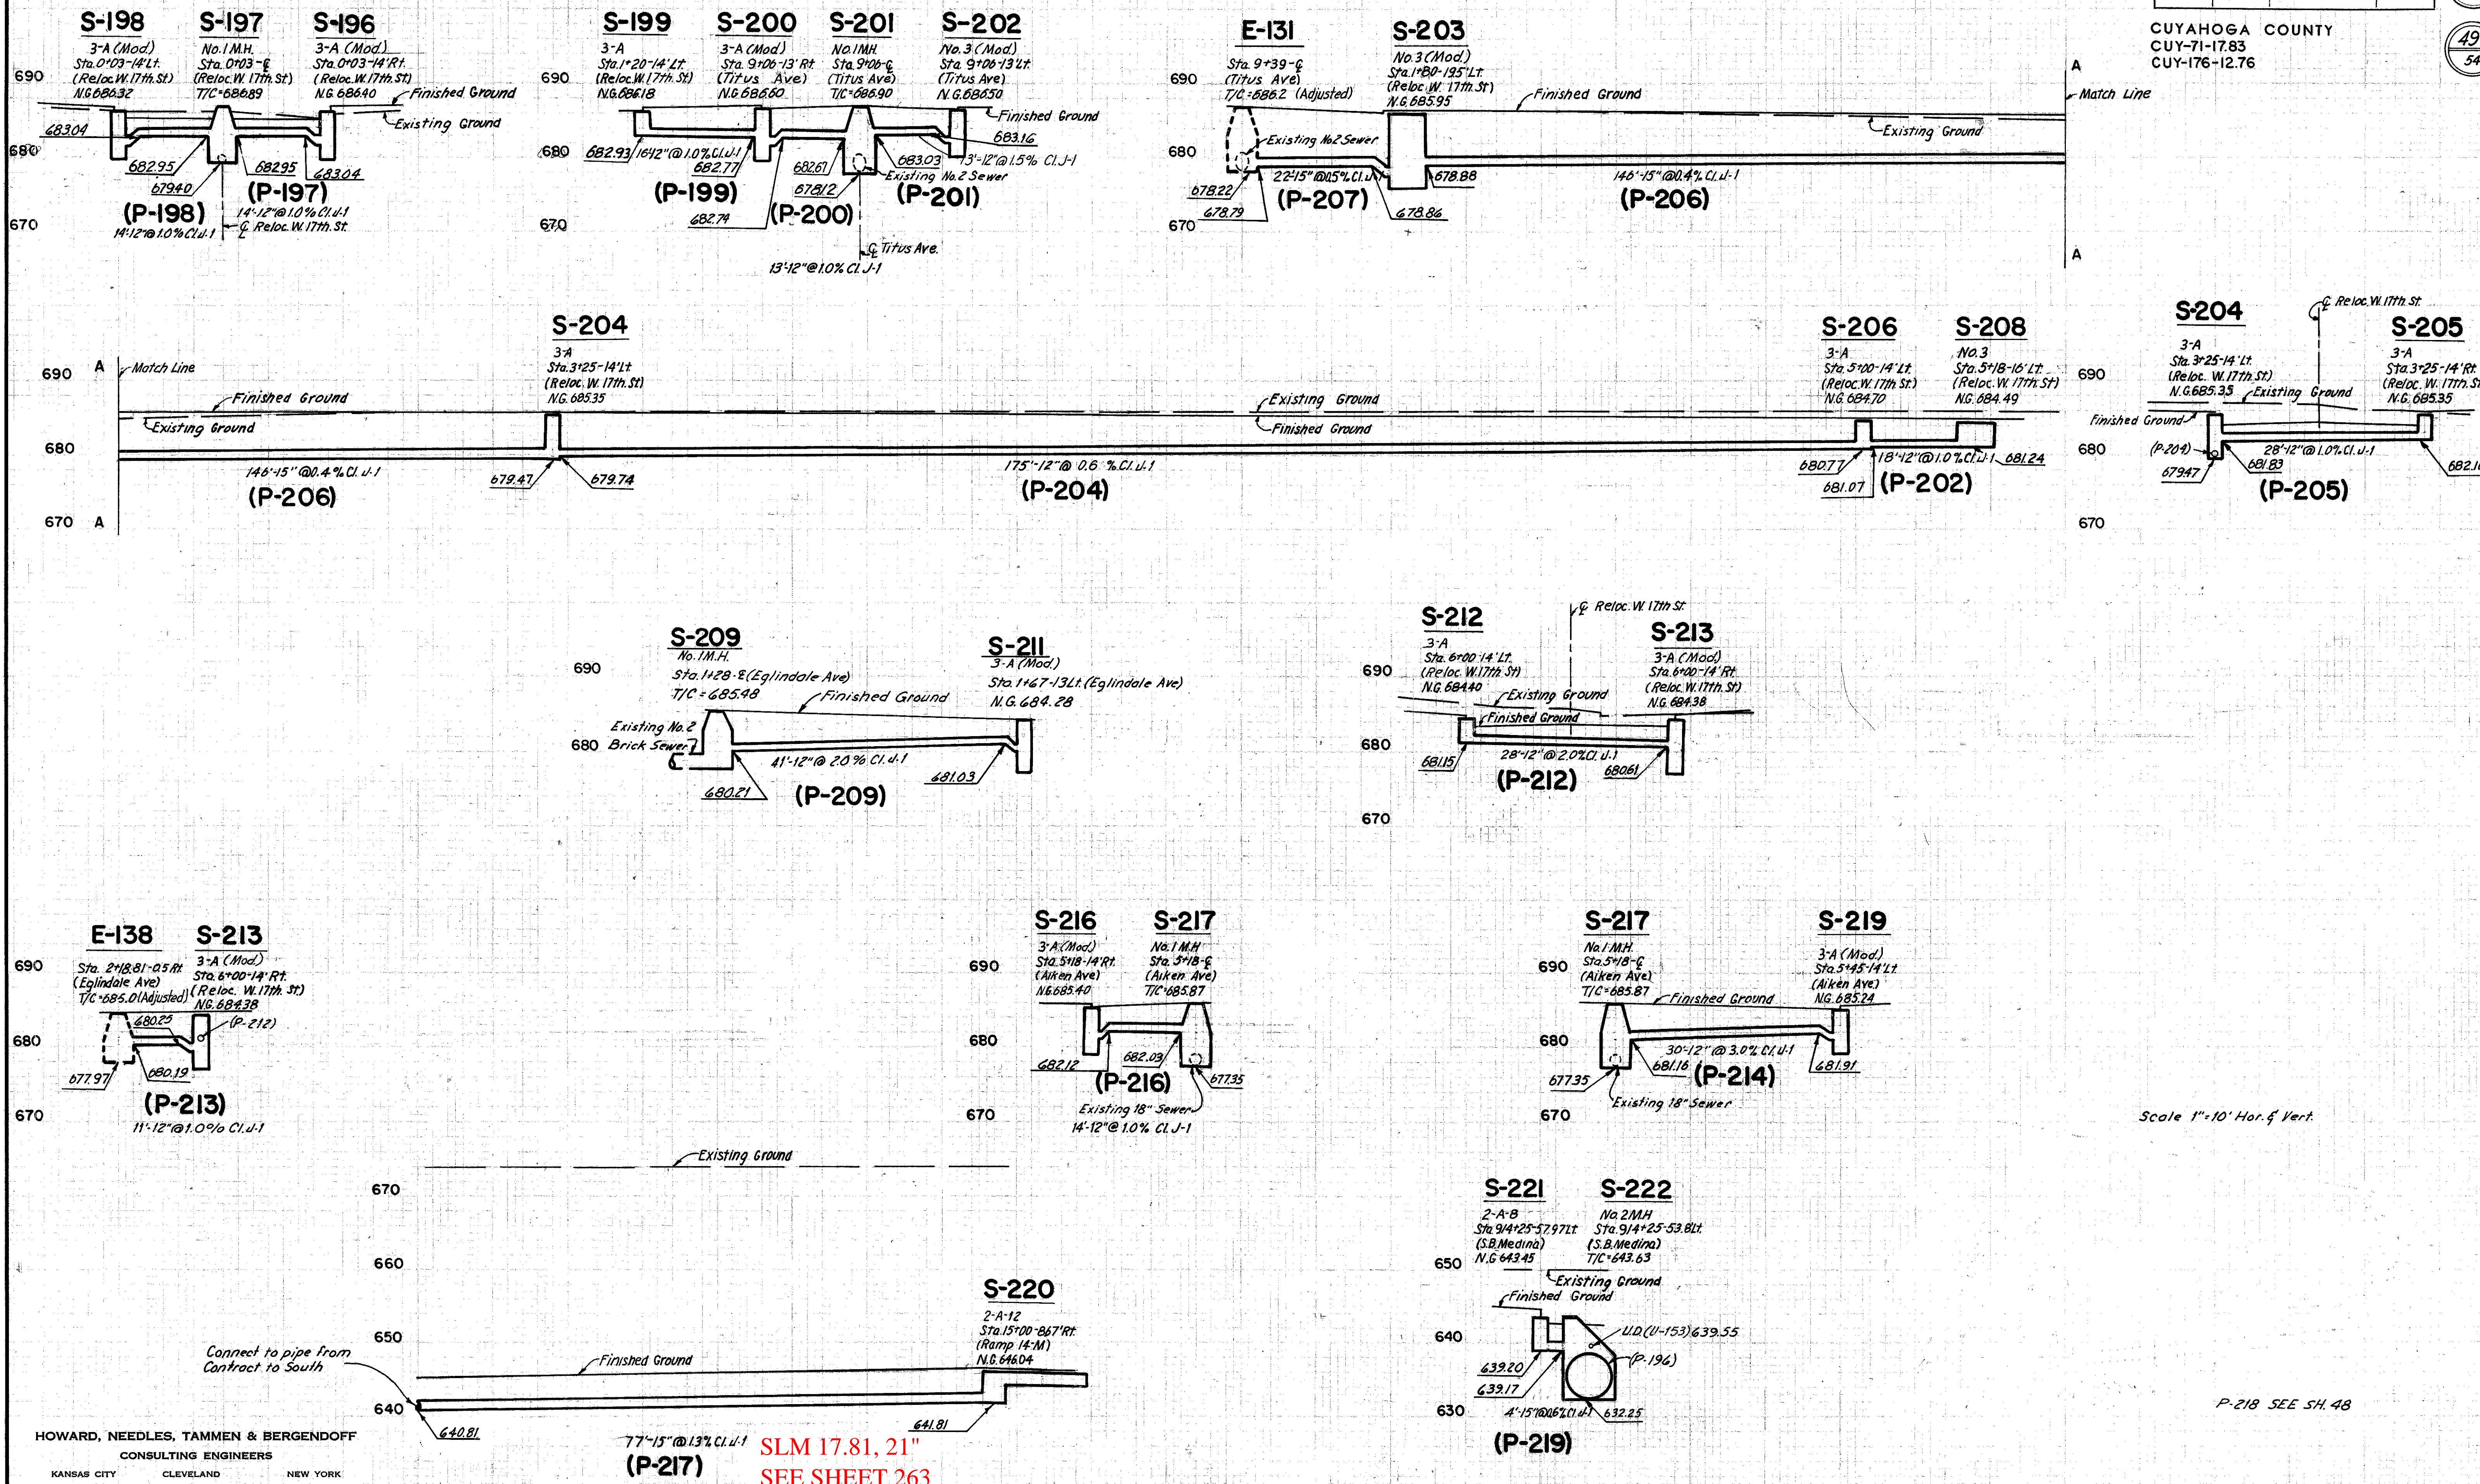

Scale 1"=10' Hor. & Vert.

P-218 SEE SH. 48

HOWARD, NEEDLES, TAMMEN & BERGENDOFF  
CONSULTING ENGINEERS  
KANSAS CITY CLEVELAND NEW YORK

77'-15" @ 1.3% C.I. U-1  
**(P-217)**  
SLM 17.81, 21"  
SEE SHEET 263