


FED. RD. DIVISION	STATE	PROJECT
2	OHIO	

278  
646

27  
54

CUYAHOGA COUNTY  
CUY-71-17.83  
CUY-176-12.76

R.D. 11 8-17-64  
JNO 10-20-64

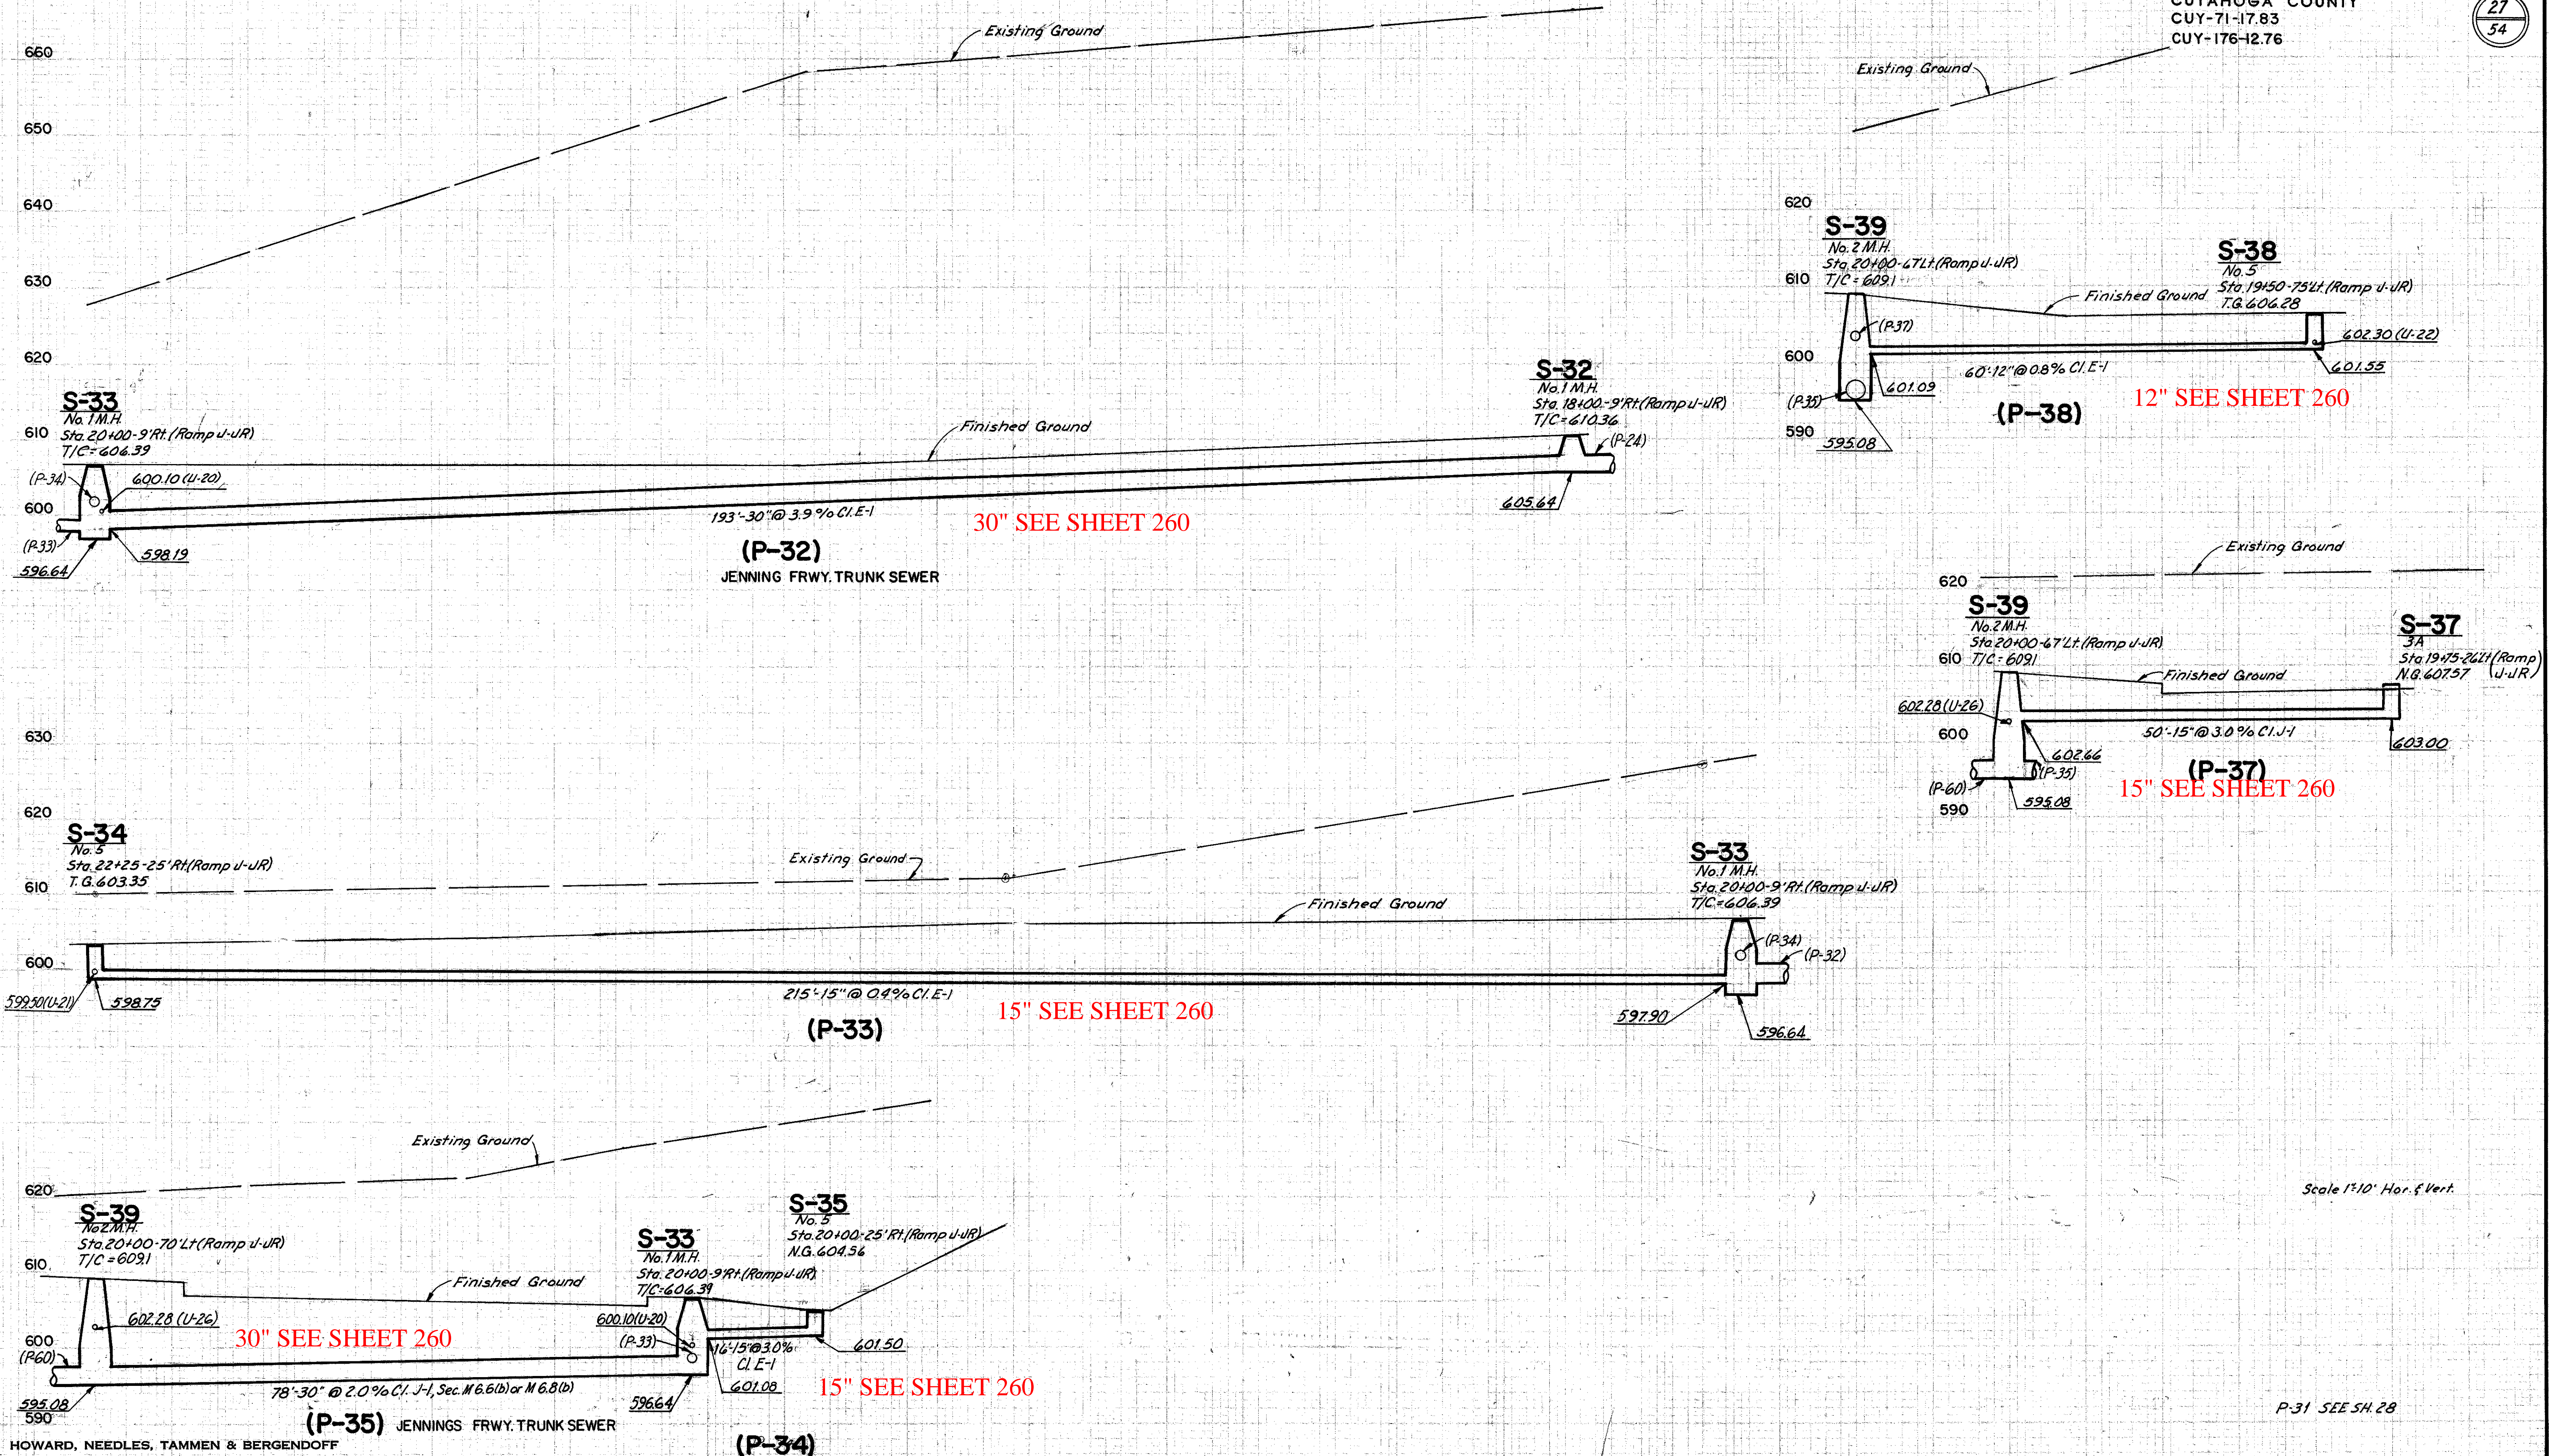

HOWARD, NEEDLES, TAMMEN & BERGENDOFF  
CONSULTING ENGINEERS  
KANSAS CITY CLEVELAND NEW YORK

P-31 SEE SH. 28