


FED. RD. DIVISION	STATE	PROJECT
2	OHIO	

280  
646

CUYAHOGA COUNTY  
CUY-71-1783  
CUY-176-12.76

29  
54

R.O.L. 8-18-64  
J.M.O. 10-21-64

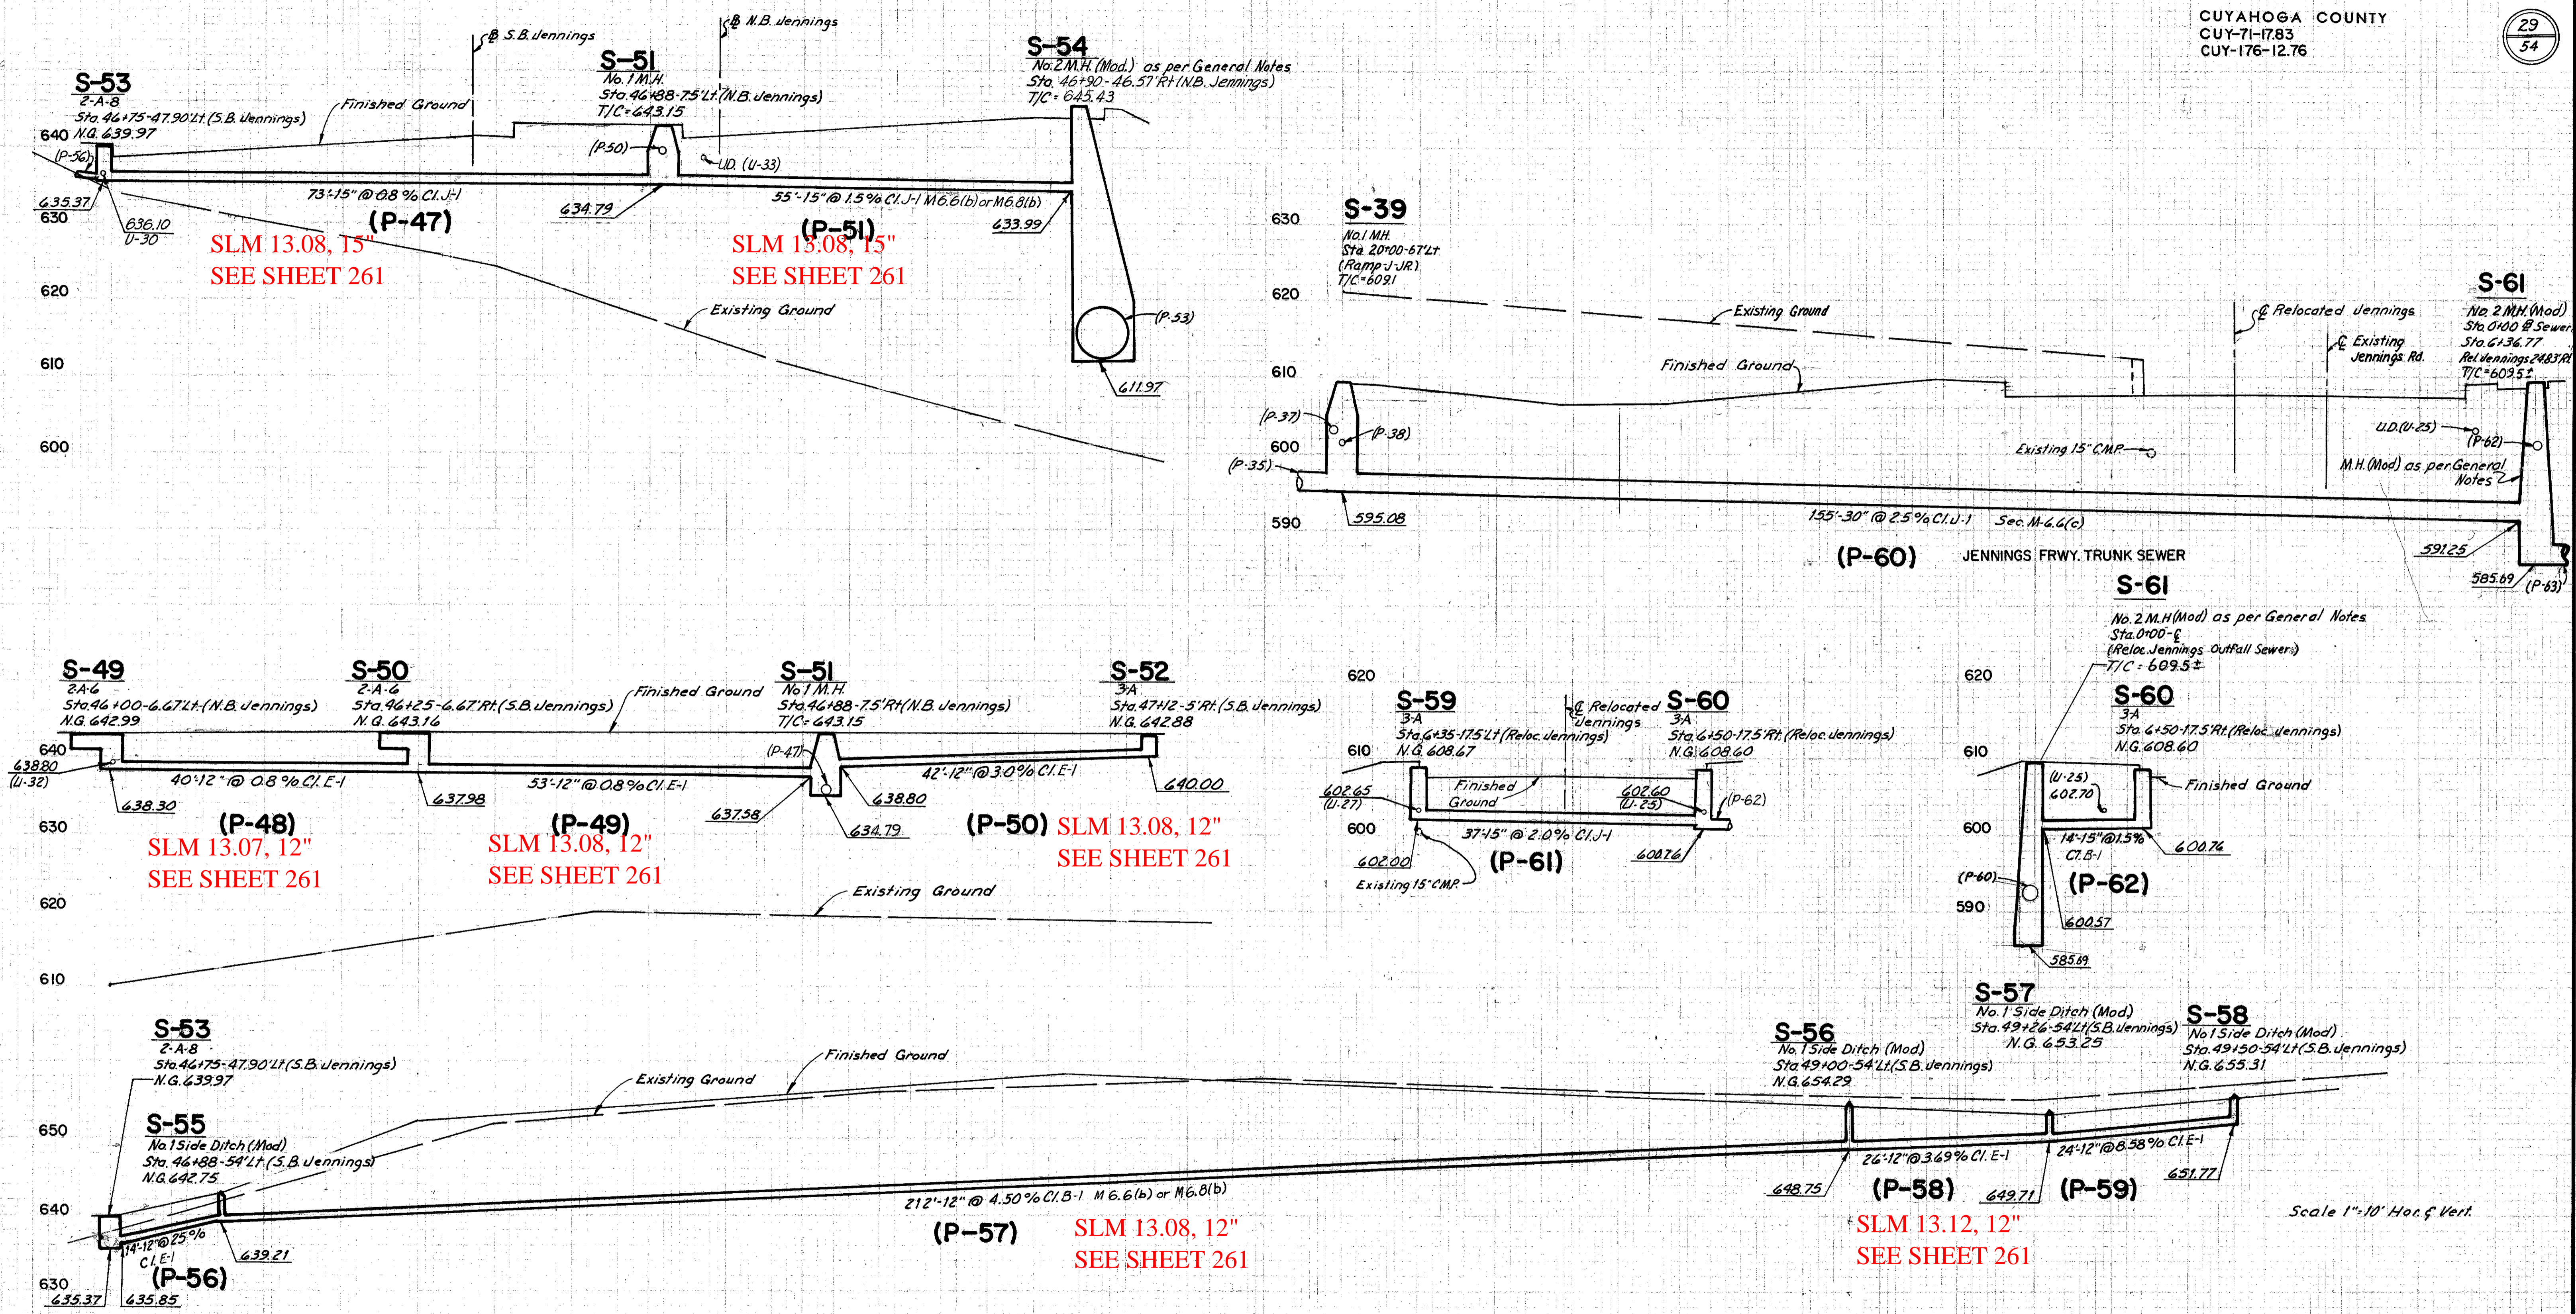

P-52 SEE SH. 30 & 31  
P-53 SEE SH. 31  
P-54 SEE SH. 32  
P-55 SEE SH. 32

HOWARD, NEEDLES, TAMMEN & BERGENDOFF  
CONSULTING ENGINEERS  
KANSAS CITY CLEVELAND NEW YORK