


SEEDING
END S Q.
WIDTH Yds.

112
302
CUYAHOGA COUNTY
MED-42-26.17
CUY-42-0.00

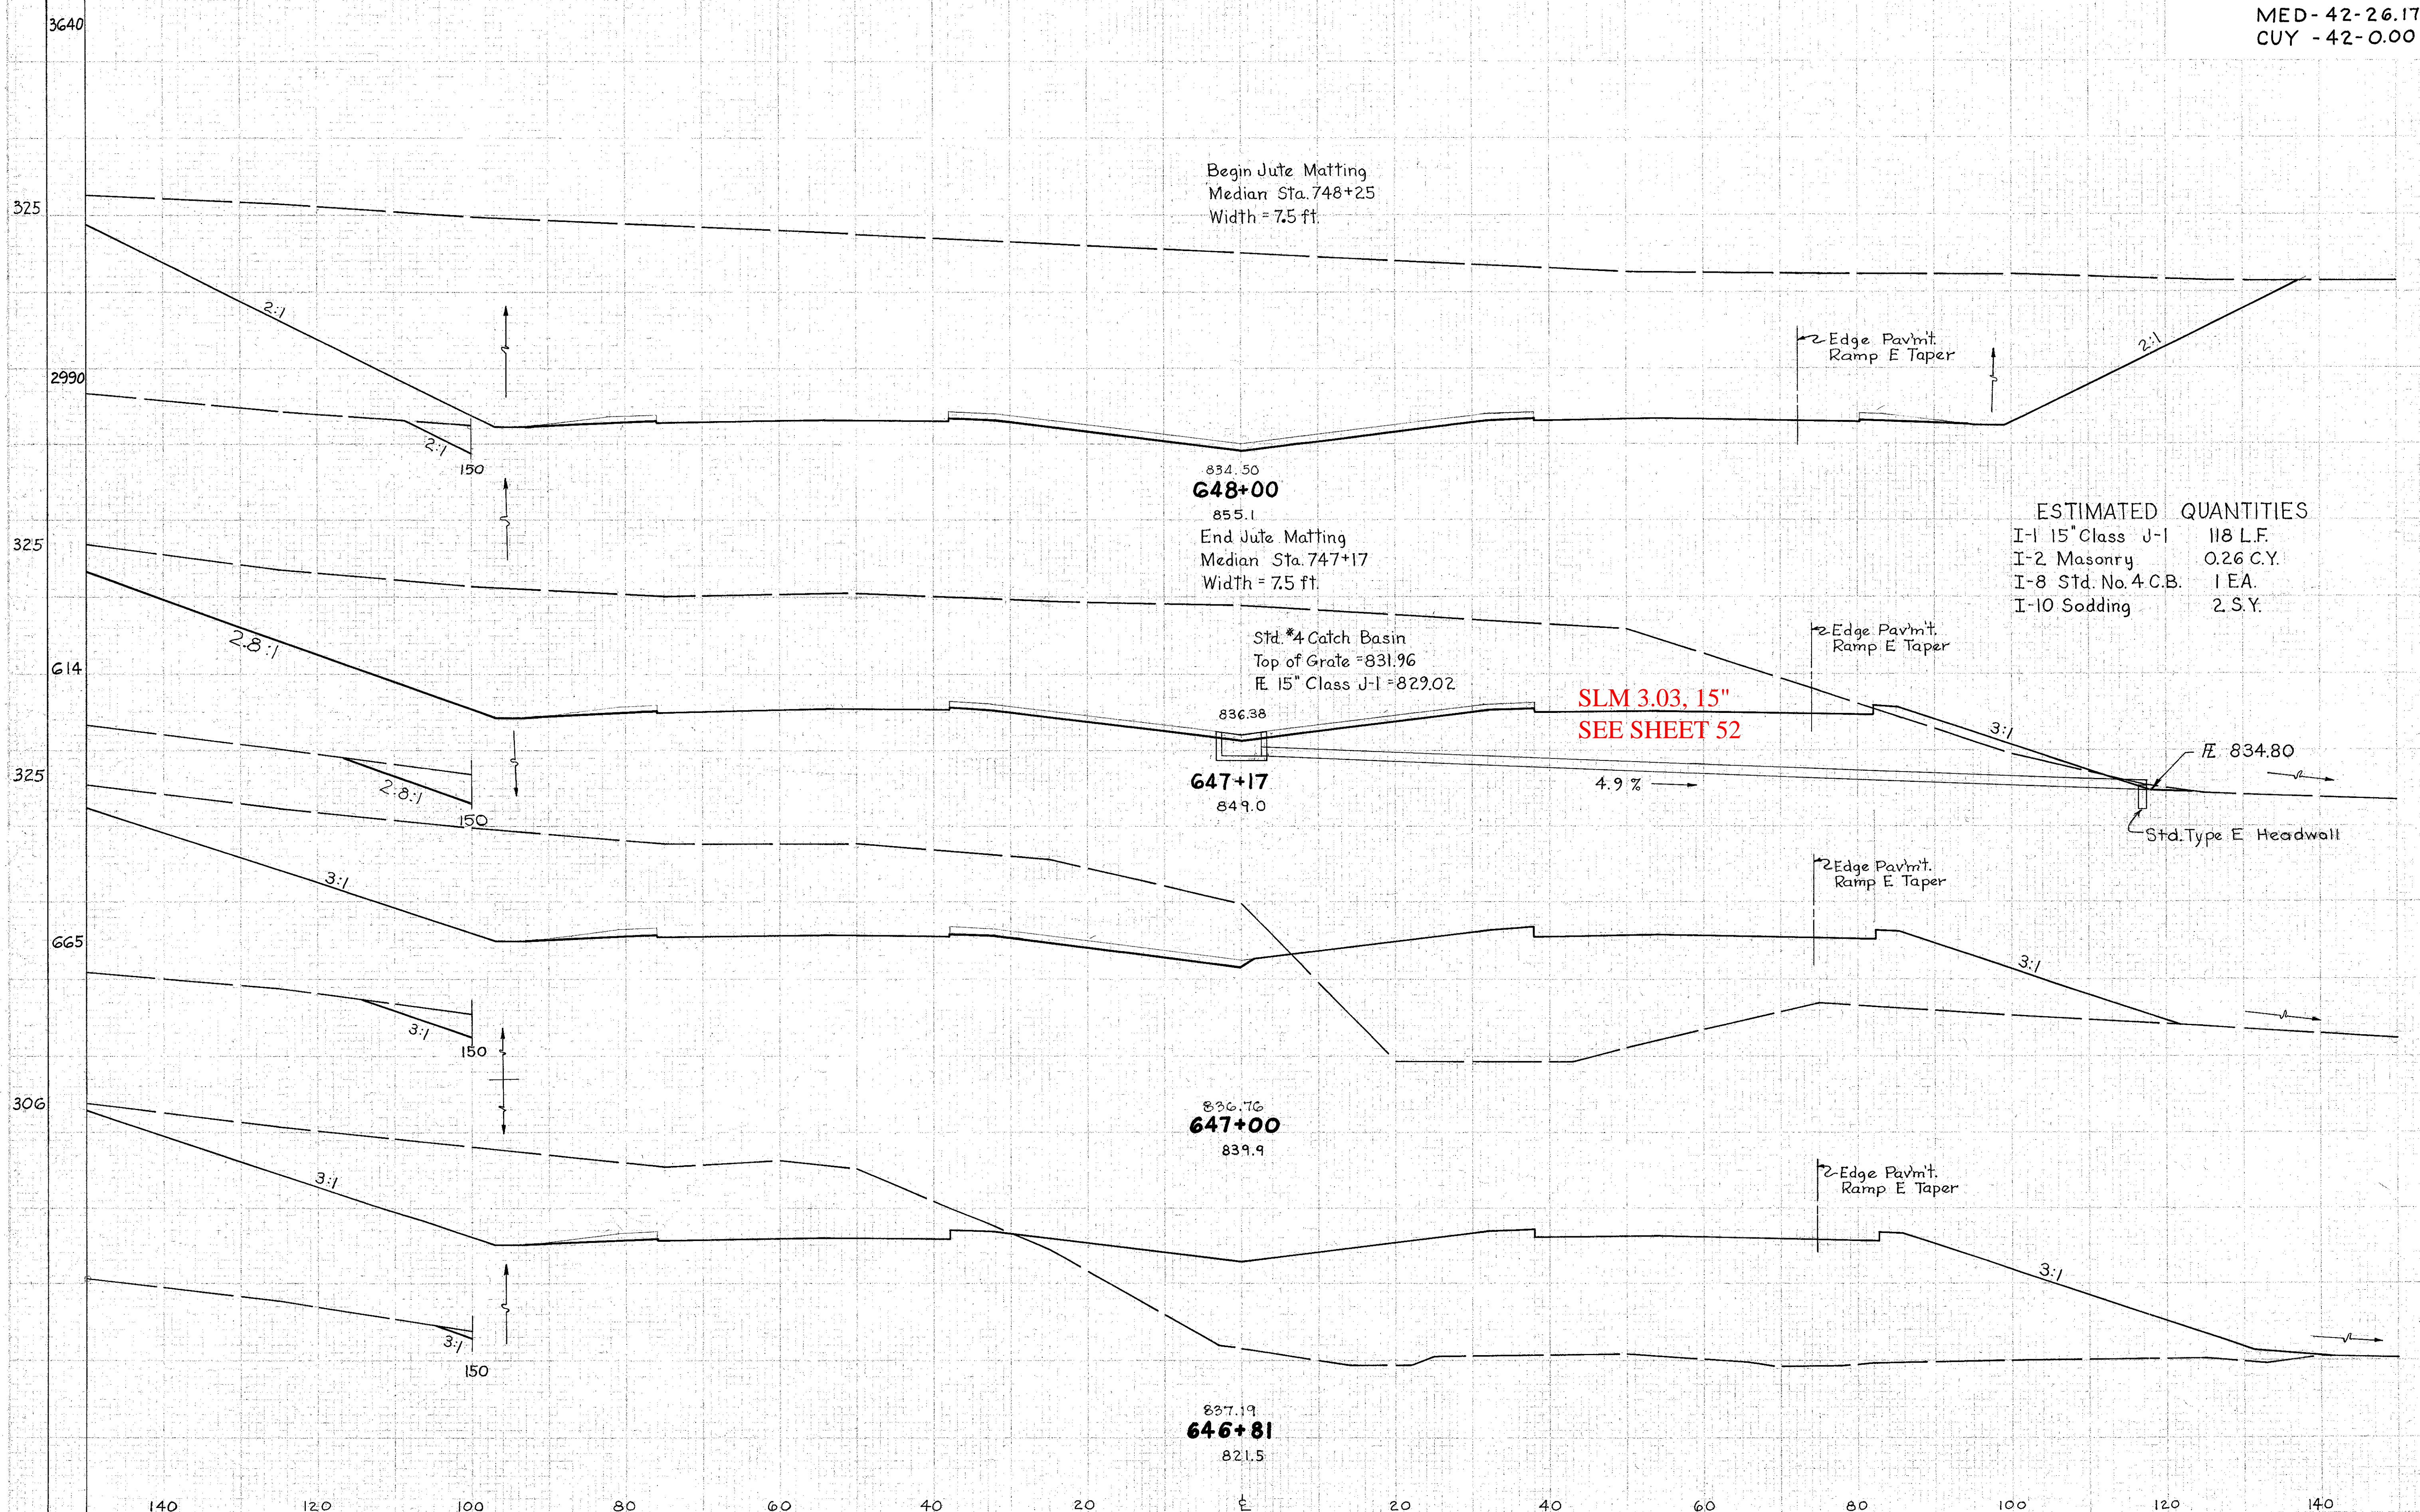

ESTIMATED QUANTITIES

I-1 15" Class J-1	118 L.F.
I-2 Masonry	0.26 C.Y.
I-8 Std. No. 4 C.B.	1 EA.
I-10 Sodding	2 S.Y.

END AREA		Cu. Yds.	
Cut	Fill	Cut	Fill
		27084	348
5688	94		
		13244	464
2929	108		
		1437	410
1639	1190		
		911	1044
947	1823		

Sta. 646+81 to 648+00