


SEEDING
END SQ.
WIDTH Yds.

2 OHIO I-71-5(15)233

118
302

CUYAHOGA COUNTY
MED-42-26.17
CUY-42-0.00

END AREA		Cu. Yds.	
Cut	Fill	Cut	Fill
47	3245	212	12762

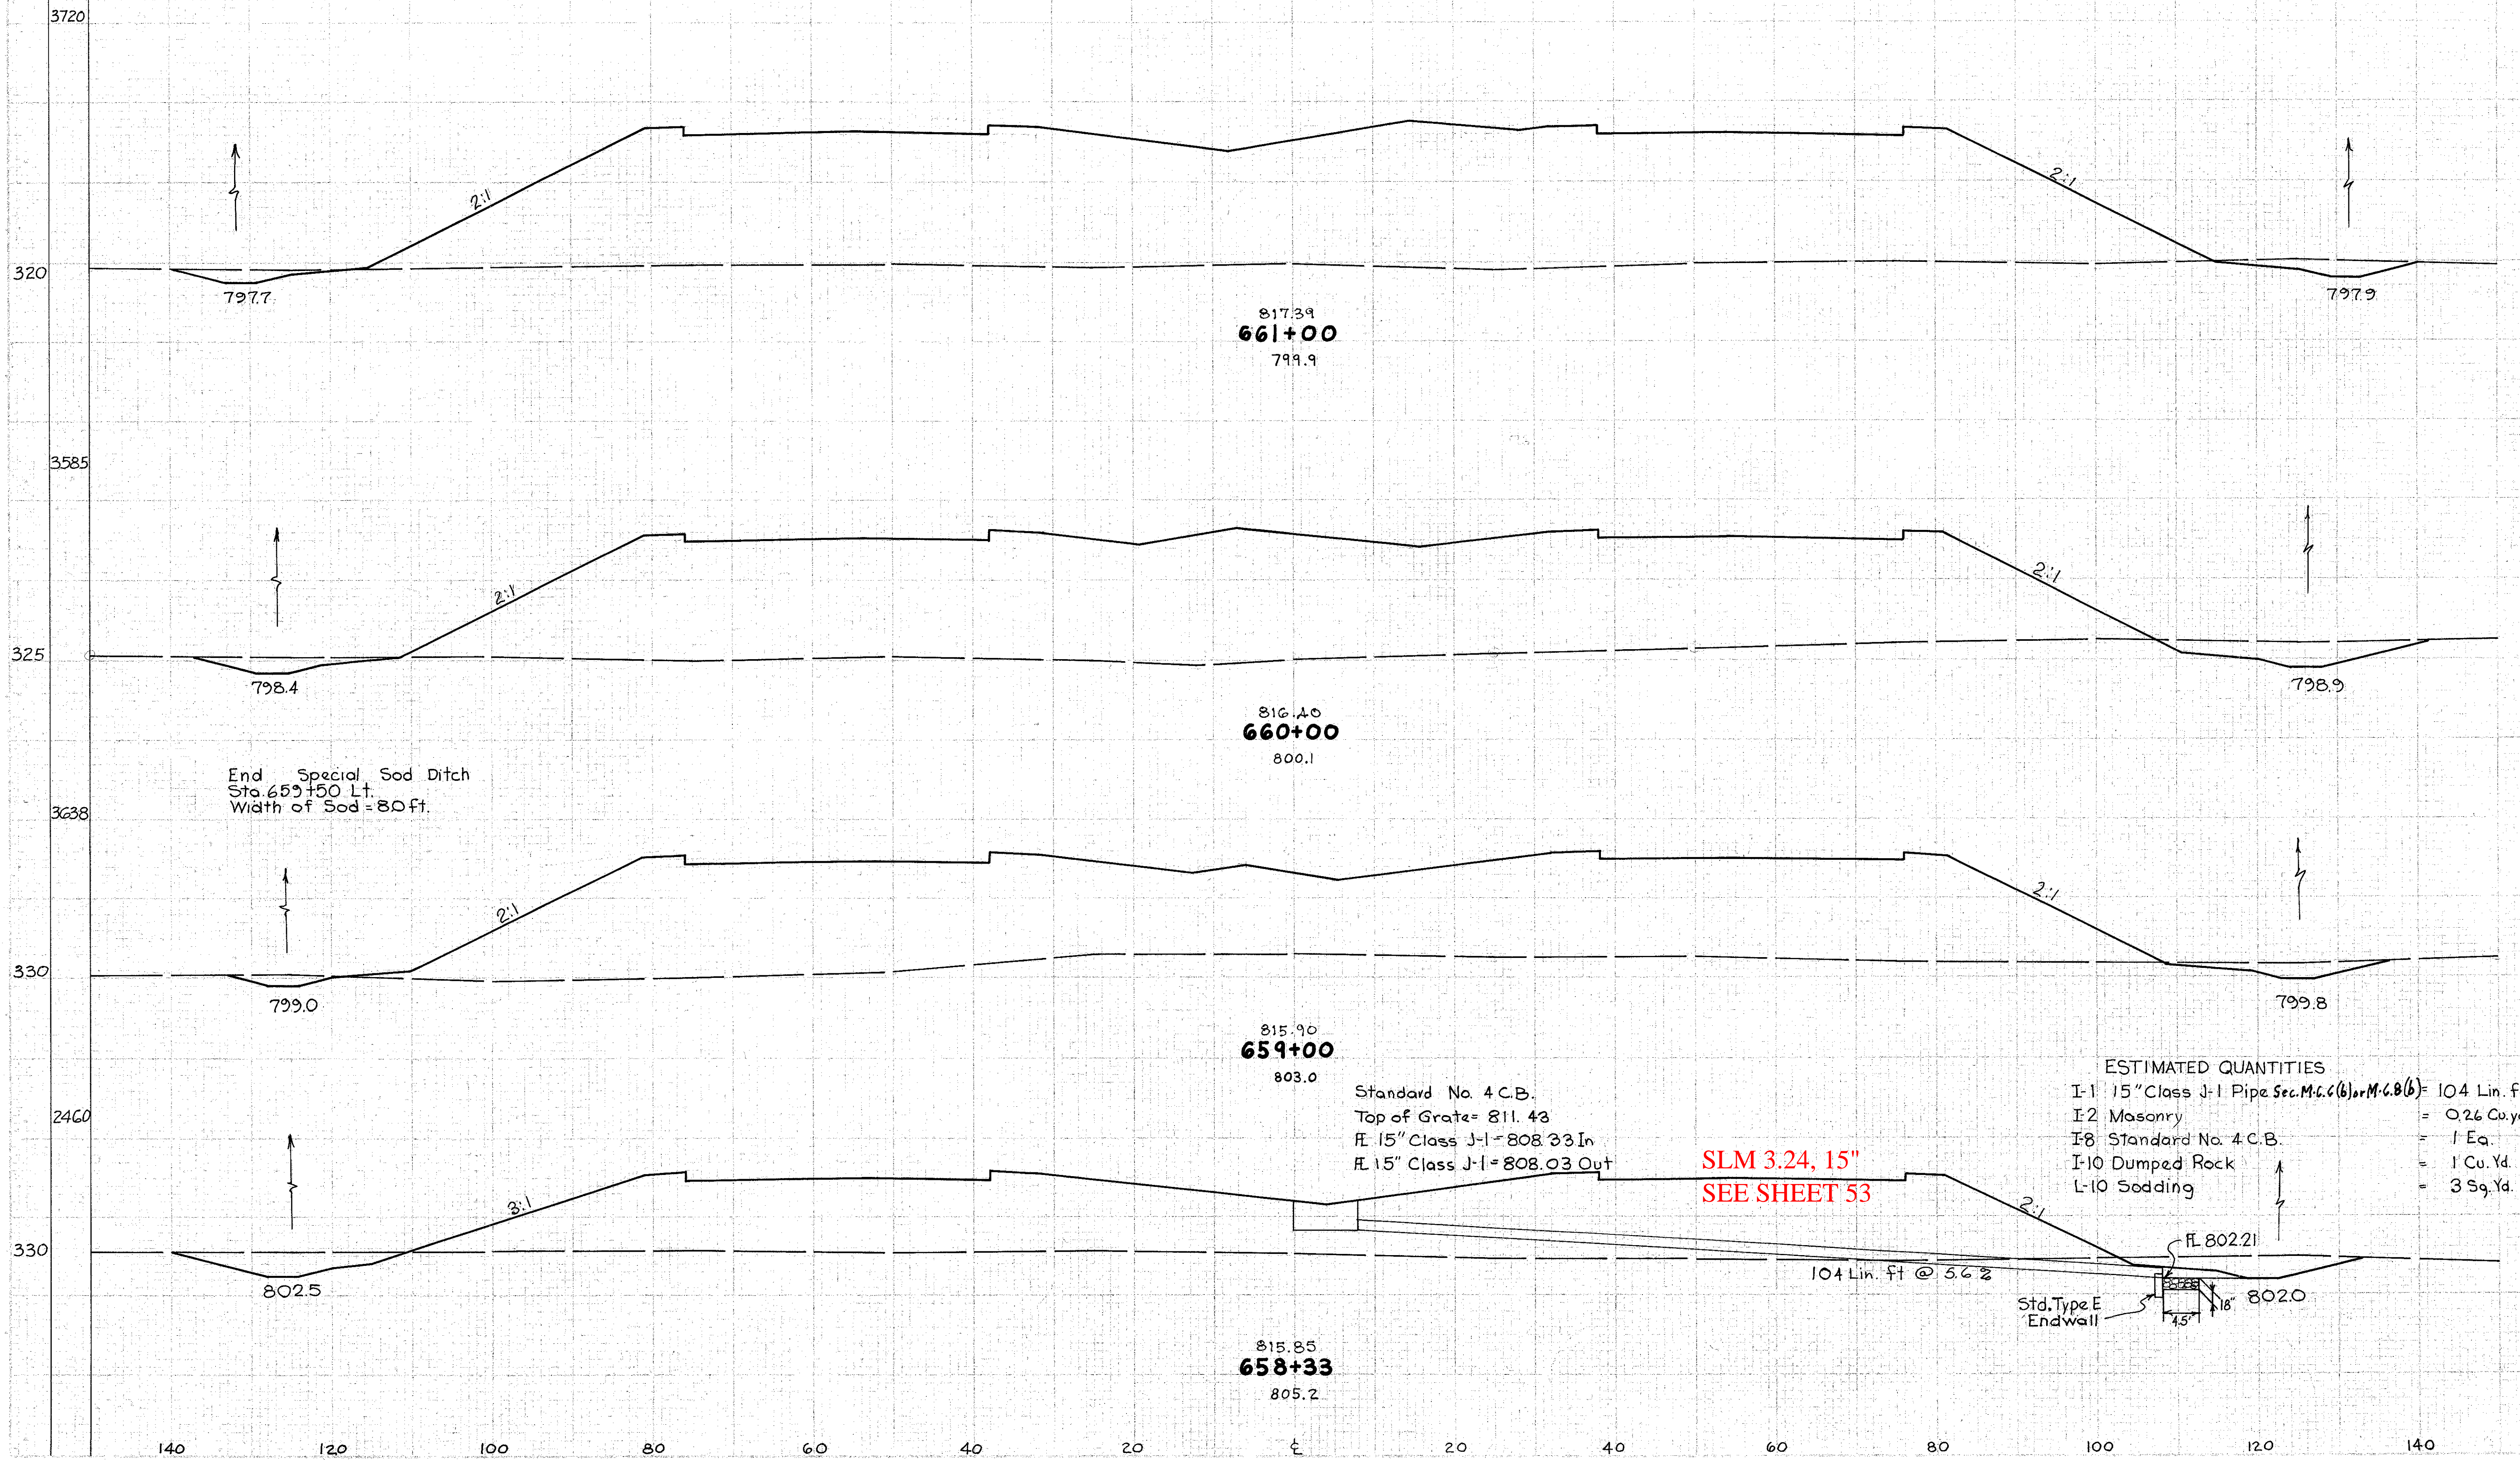


End Special Sod Ditch
Sta. 659+50 Lt.
Width of Sod = 80 ft.

Standard No. 4 C.B.
Top of Grate = 811.43
Fl. 15" Class J-1 = 808.33 In
Fl. 15" Class J-1 = 808.03 Out

SLM 3.24, 15"
SEE SHEET 53

ESTIMATED QUANTITIES

I-1 15" Class J-1 Pipe Sec. M.C. 6(b) or M.C. 8(b)	= 104 Lin. ft.
I-2 Masonry	= 0.26 Cu. yd.
I-8 Standard No. 4 C.B.	= 1 Ea.
I-10 Dumped Rock	= 1 Cu. Yd.
L-10 Sodding	= 3 Sq. Yd.

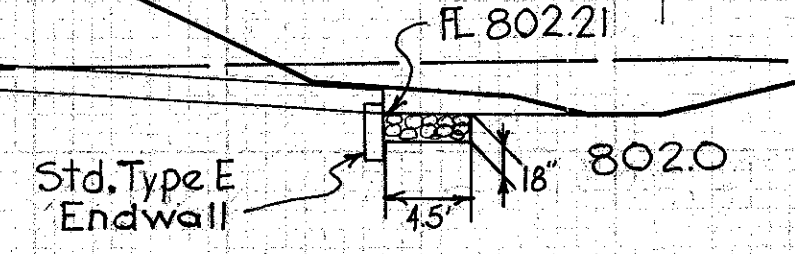

Sta. 658+33 to 661+00