


FED. RD. DIVISION	STATE	PROJECT

ESTIMATED QUANTITIES

E-3 Channel Excavation	151 C.Y.
I-1 54" Class A-1 pipe Sec. M 6.6 (d)	296 L.F.
I-10 Dumped Rock	12 C.Y.
L-10 Sodding	20 S.Y.
I-10 Riprap	50 S.Y.

CUYAHOGA COUNTY
MED-42-26.17
CUY-42-000

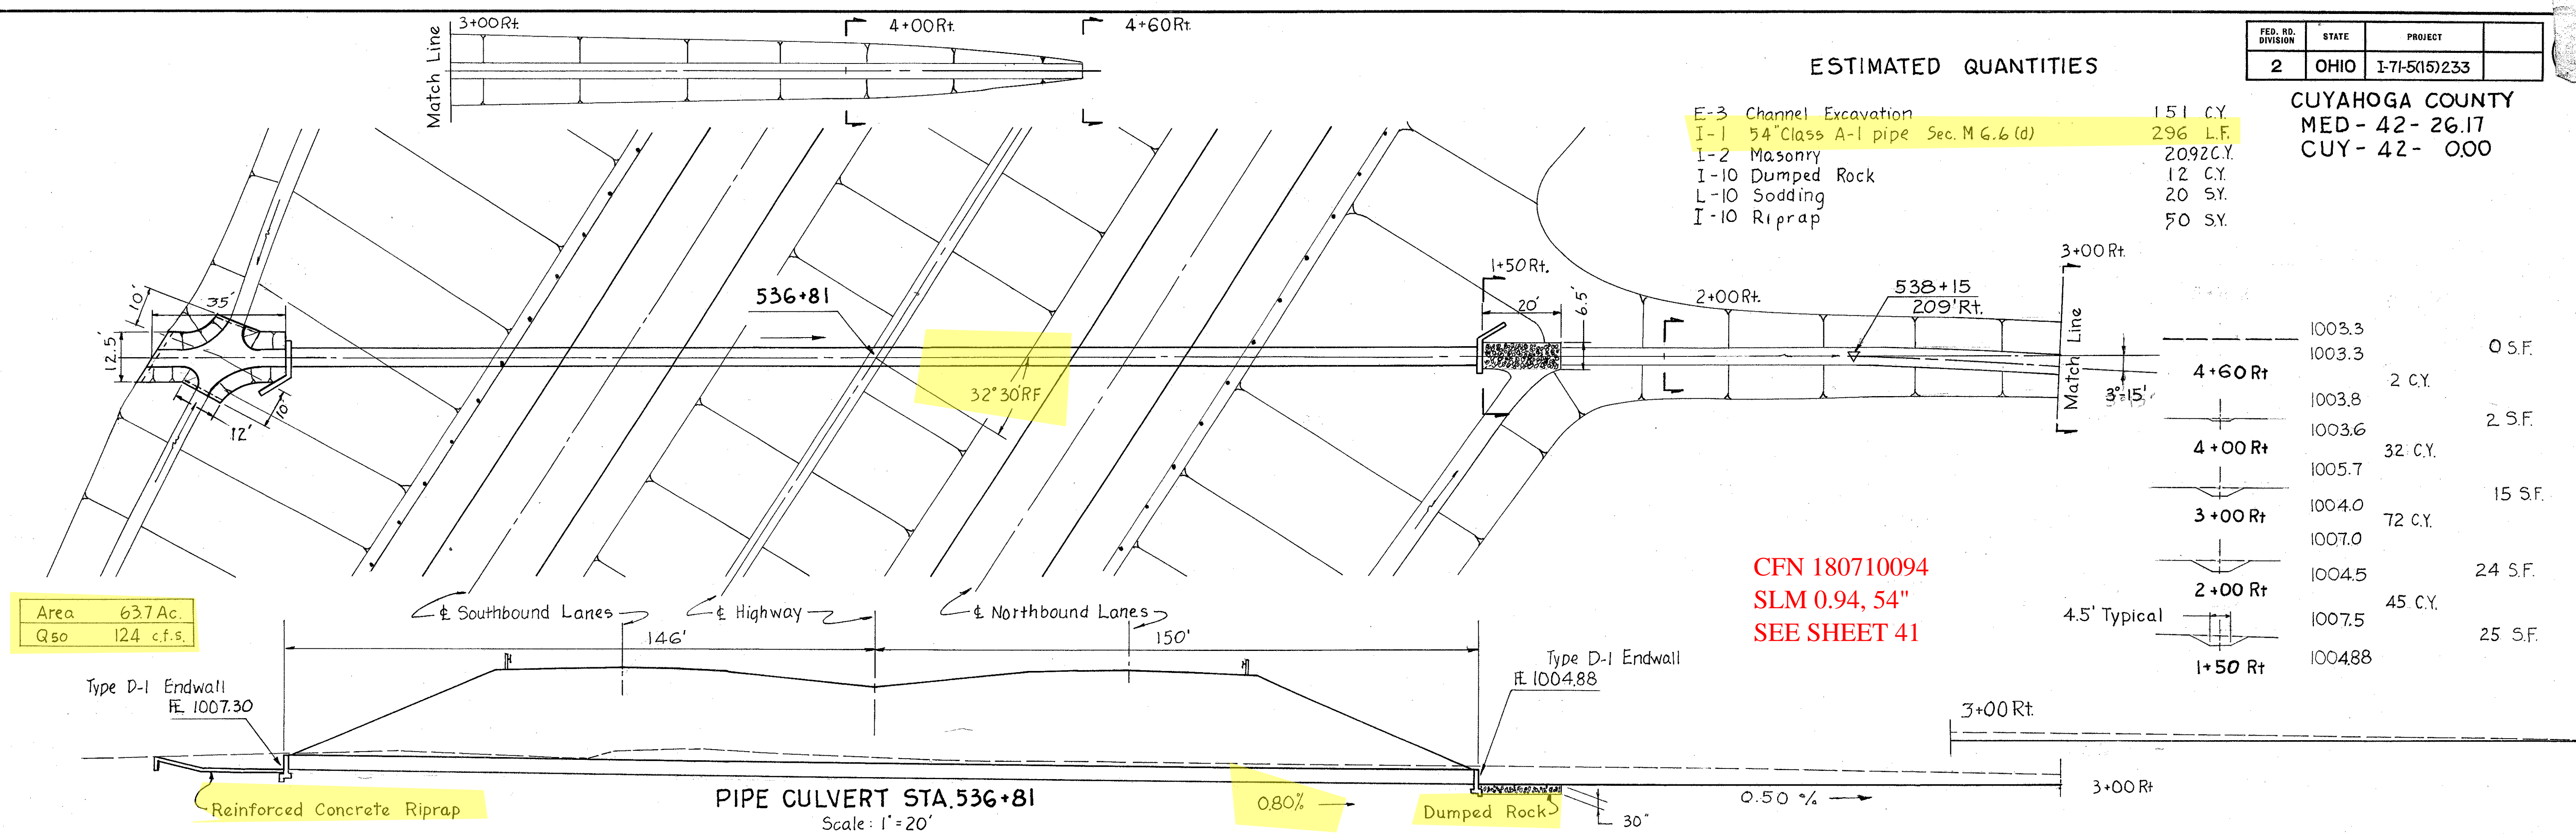

Area 637 Ac.
Q50 124 c.f.s.

CFN 180710094
SLM 0.94, 54"
SEE SHEET 41


1003.3		0 S.F.
1003.3	4+60 Rt	2 C.Y.
1003.8		2 S.F.
1003.6	4+00 Rt	32 C.Y.
1005.7		15 S.F.
1004.0	3+00 Rt	72 C.Y.
1007.0		24 S.F.
1004.5	2+00 Rt	45 C.Y.
1007.5		25 S.F.
1004.88	1+50 Rt	

PIPE CULVERT STA. 536+81
Scale: 1"=20'

ESTIMATED QUANTITIES

E-3 Channel Excavation	144 C.Y.
I-1 60" Class A-1 Pipe Sec. M 6.6 (a)	220 L.F.
I-2 Masonry	24.54 C.Y.
L-10 Sodding	22 S.Y.

CFN 180710005
SLM 0.05, 60"
SEE SHEET 36

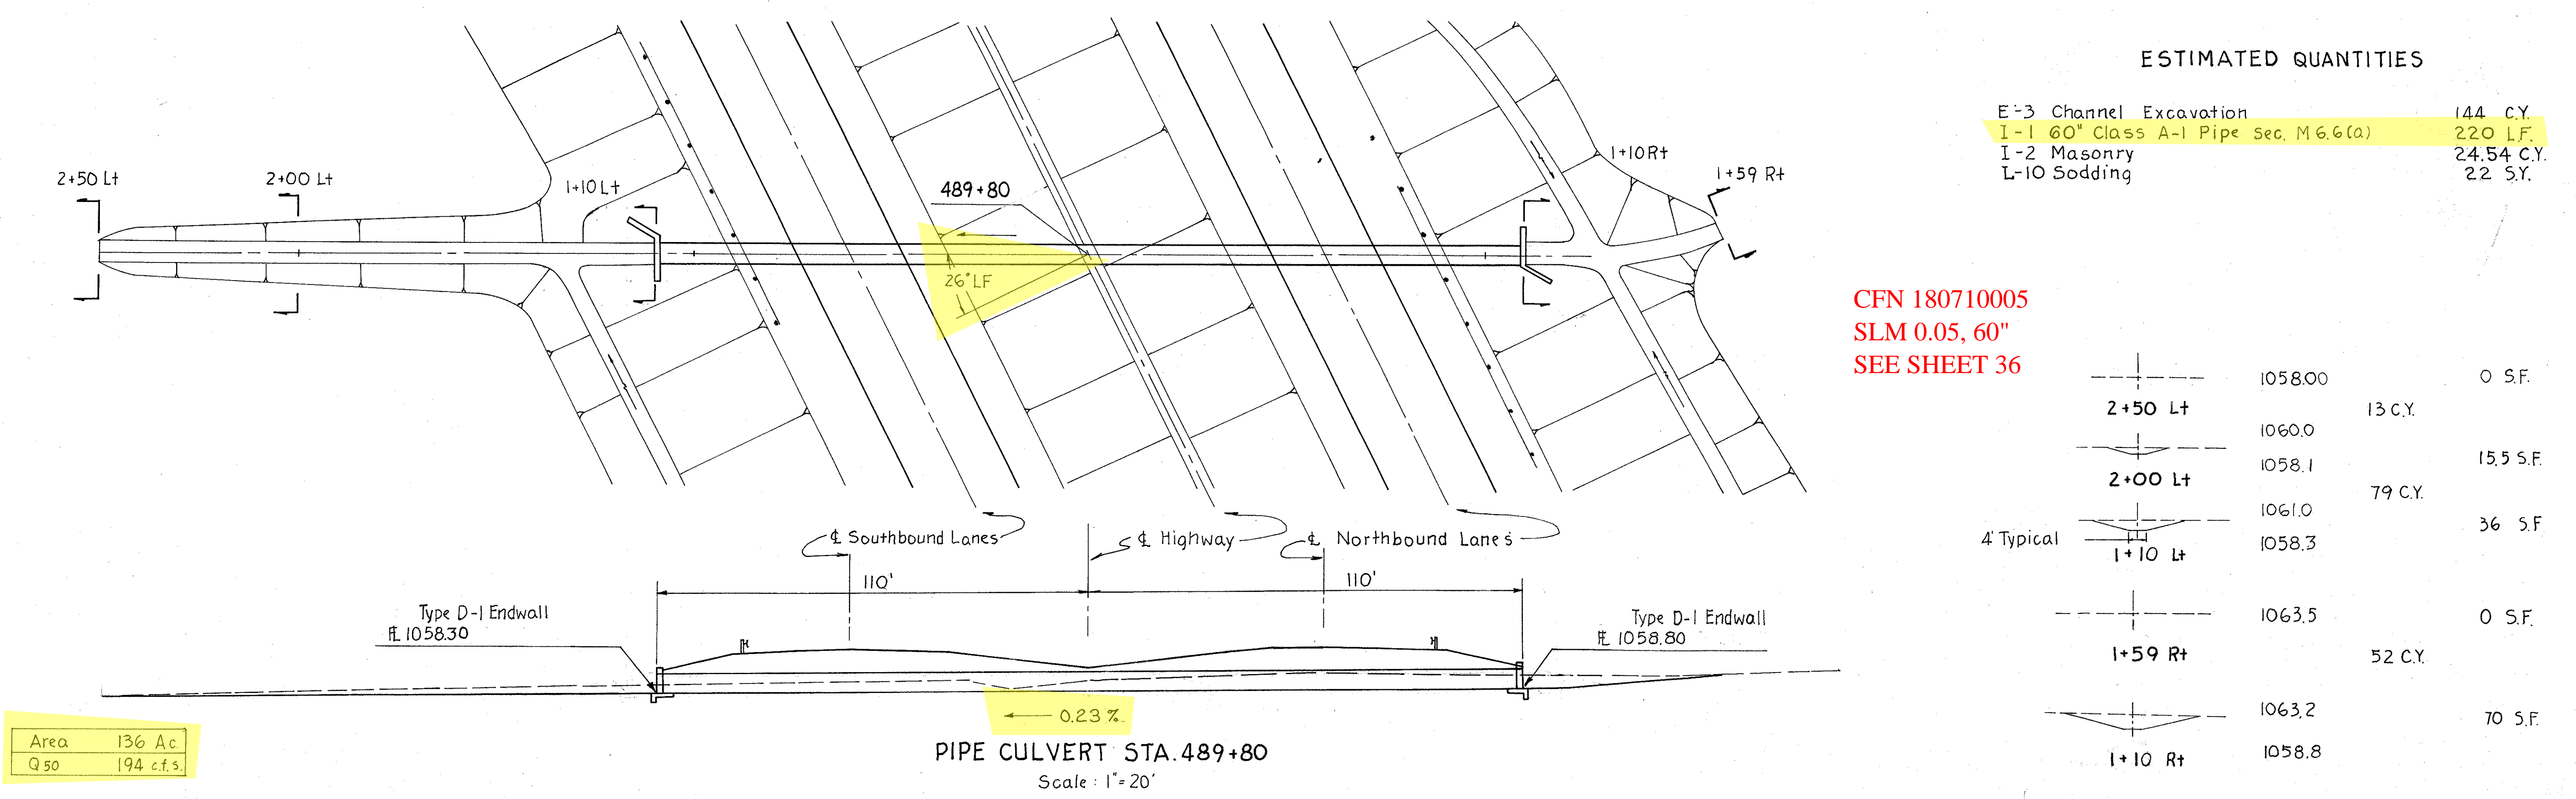

Area 136 Ac.
Q50 194 c.f.s.

1058.00		0 S.F.
1060.0	2+50 Lt	13 C.Y.
1058.1		15.5 S.F.
1061.0	2+00 Lt	79 C.Y.
1058.3		36 S.F.
1058.3	1+10 Lt	
1063.5		0 S.F.
1063.2	1+59 Rt	52 C.Y.
1058.8	1+10 Rt	70 S.F.

PIPE CULVERT STA. 489+80
Scale: 1"=20'