


CUYAHOGA COUNTY
MED-42-26.17
CUY-42-000

ESTIMATED QUANTITIES

I-1	12" Class J-1 Pipe	90 L.F.
	15" Class J-1 Pipe	314 L.F.
	18" Class J-1 Pipe	96 L.F.
	21" Class J-1 Pipe	118 L.F.
	24" Class J-1 Pipe	56 L.F.
	27" Class J-1 Pipe	430 L.F.
I-8	Std. No. 4 C.B.	3 Ea.
	Std. No. 5 C.B.	2 Ea.
	Std. No. 6 C.B.	3 Ea.

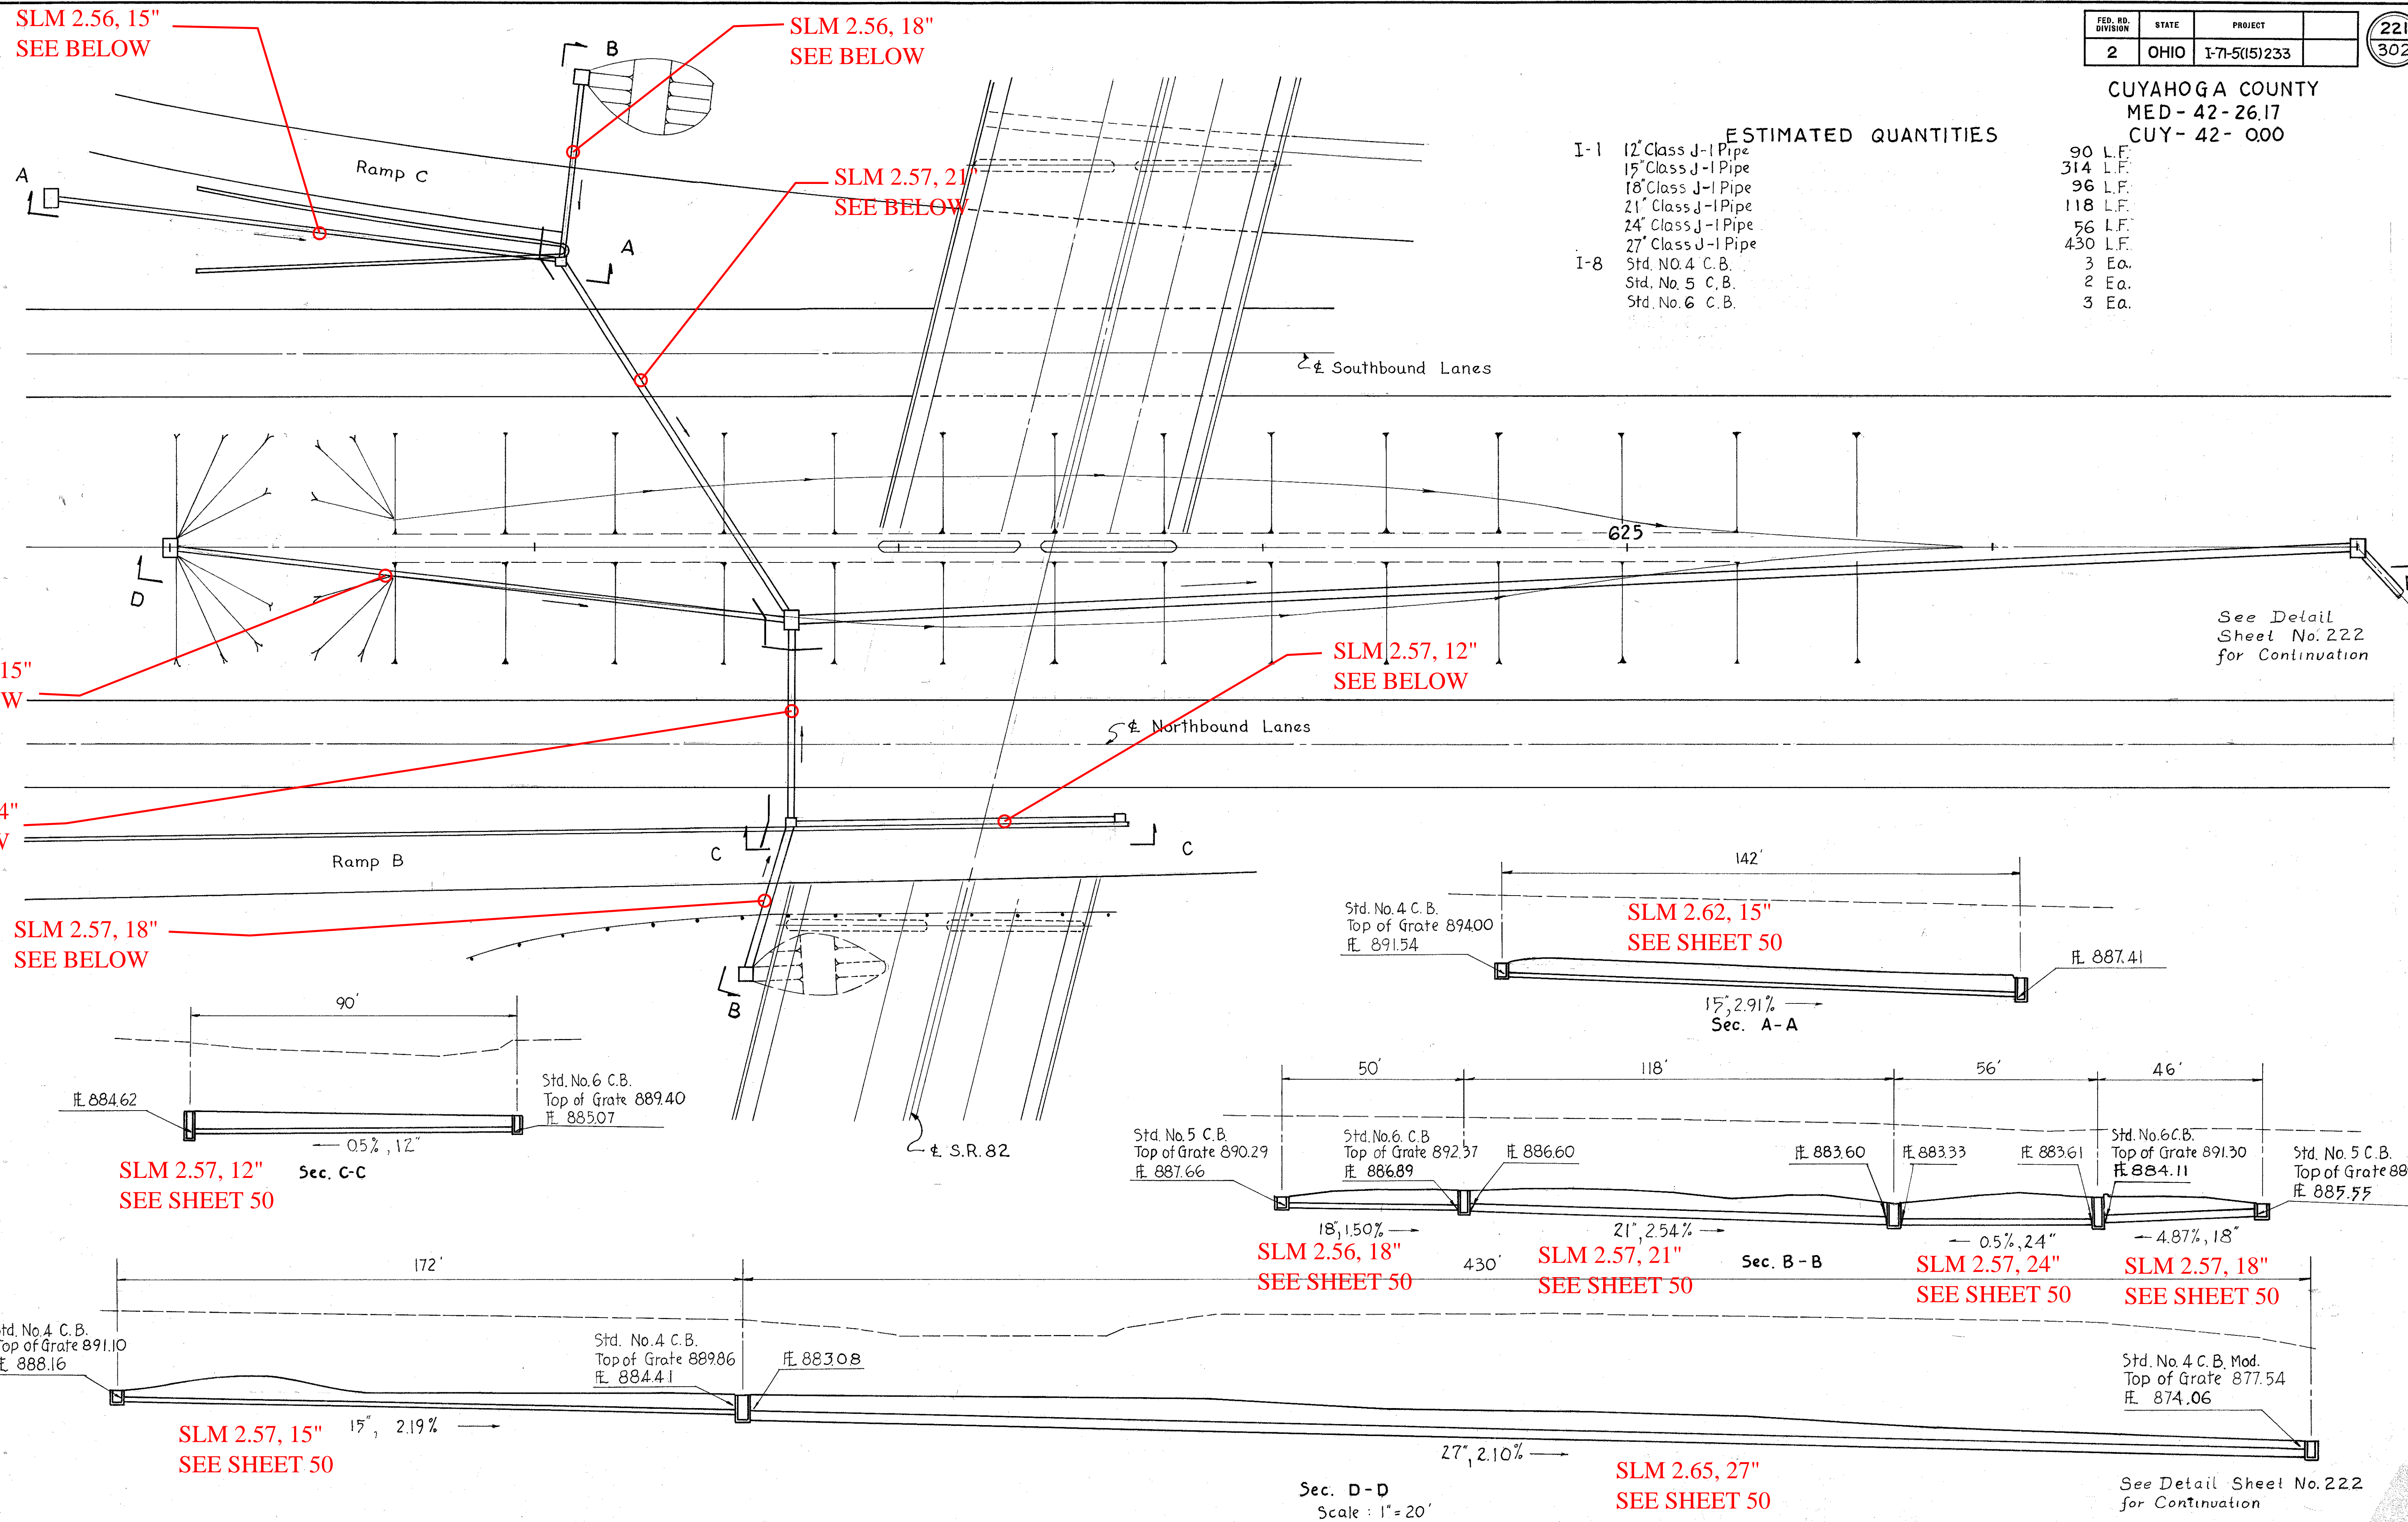

SLM 2.56, 15"
SEE BELOW

SLM 2.56, 18"
SEE BELOW

SLM 2.57, 21"
SEE BELOW

SLM 2.57, 15"
SEE BELOW

SLM 2.57, 12"
SEE BELOW

SLM 2.57, 24"
SEE BELOW

SLM 2.57, 18"
SEE BELOW

SLM 2.62, 15"
SEE SHEET 50

SLM 2.57, 12"
SEE SHEET 50

SLM 2.56, 18"
SEE SHEET 50

SLM 2.57, 21"
SEE SHEET 50

SLM 2.57, 24"
SEE SHEET 50

SLM 2.57, 18"
SEE SHEET 50

SLM 2.57, 15"
SEE SHEET 50

SLM 2.65, 27"
SEE SHEET 50

Sec. D-D
Scale: 1" = 20'

See Detail Sheet No. 222
for Continuation