


CUYAHOGA COUNTY  
MED - 42-26.17  
CUY - 42-000

ESTIMATED QUANTITIES

I-1	27" Class J-1	146 L.F.
	30" Class J-1	360 L.F.
I-8	Std. No. 4 C.B. Mod.	1 Ea.
	Std. No. 5 C.B. Mod.	1 Ea.

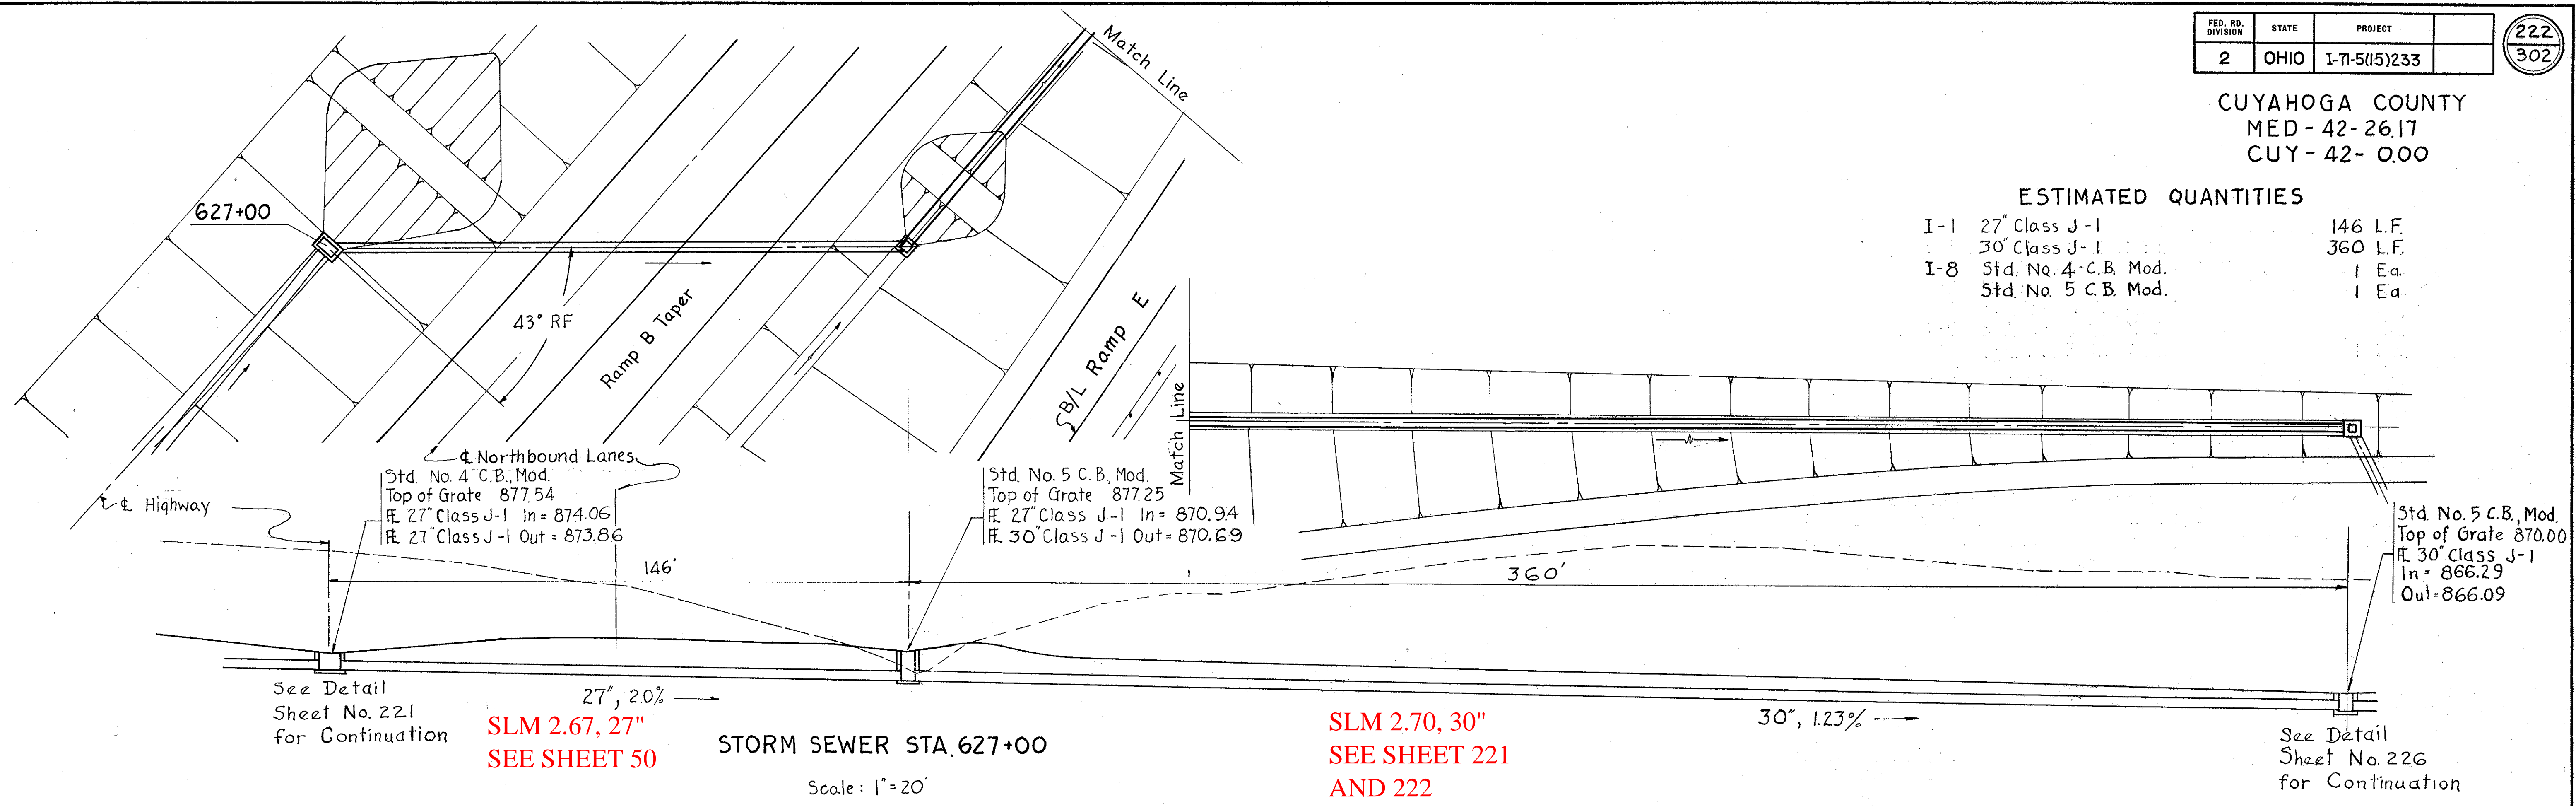


SLM 2.67, 27"  
SEE SHEET 50

SLM 2.70, 30"  
SEE SHEET 221  
AND 222

ESTIMATED QUANTITIES

I-1	12" Class B-1 Pipe	15 L.F.
	15" Class B-1 Pipe	200 L.F.
	18" Class B-1 Pipe	142 L.F.
I-2	Masonry	030 C.Y.
I-8	Std. No. 4 C.B.	2 Ea.
	Std. No. 6 C.B.	4 Ea.
I-10	Dumped Rock	3 C.Y.
L-10	Sodding	3 S.Y.

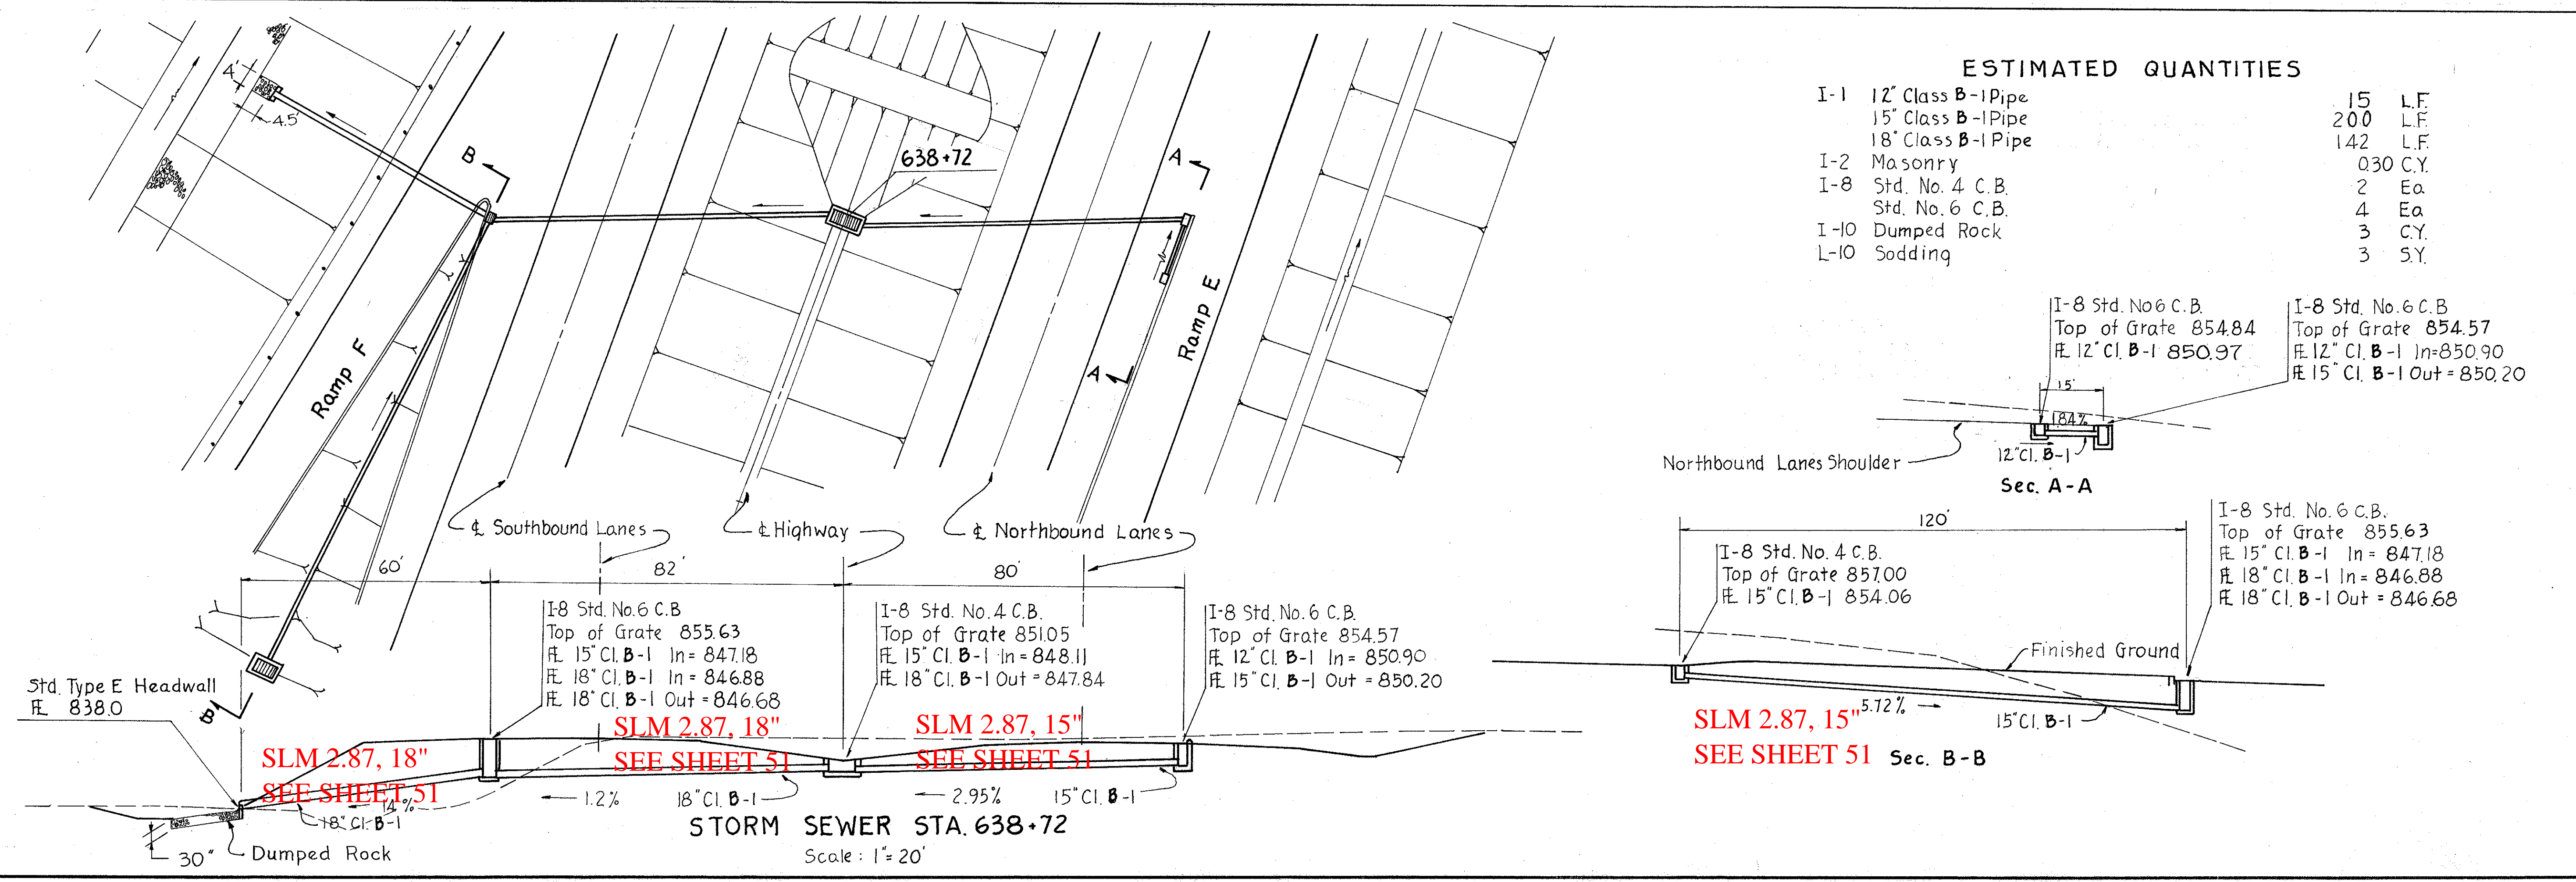

SLM 2.87, 18"  
SEE SHEET 51

SLM 2.87, 18"  
SEE SHEET 51

SLM 2.87, 15"  
SEE SHEET 51

SLM 2.87, 15"  
SEE SHEET 51

