


SEE 2001 CUY-71-00 PLANS FOR
MODIFICATIONS TO STORM SEWER

COUNTY LINE
SLM 0.00=MM 228.71

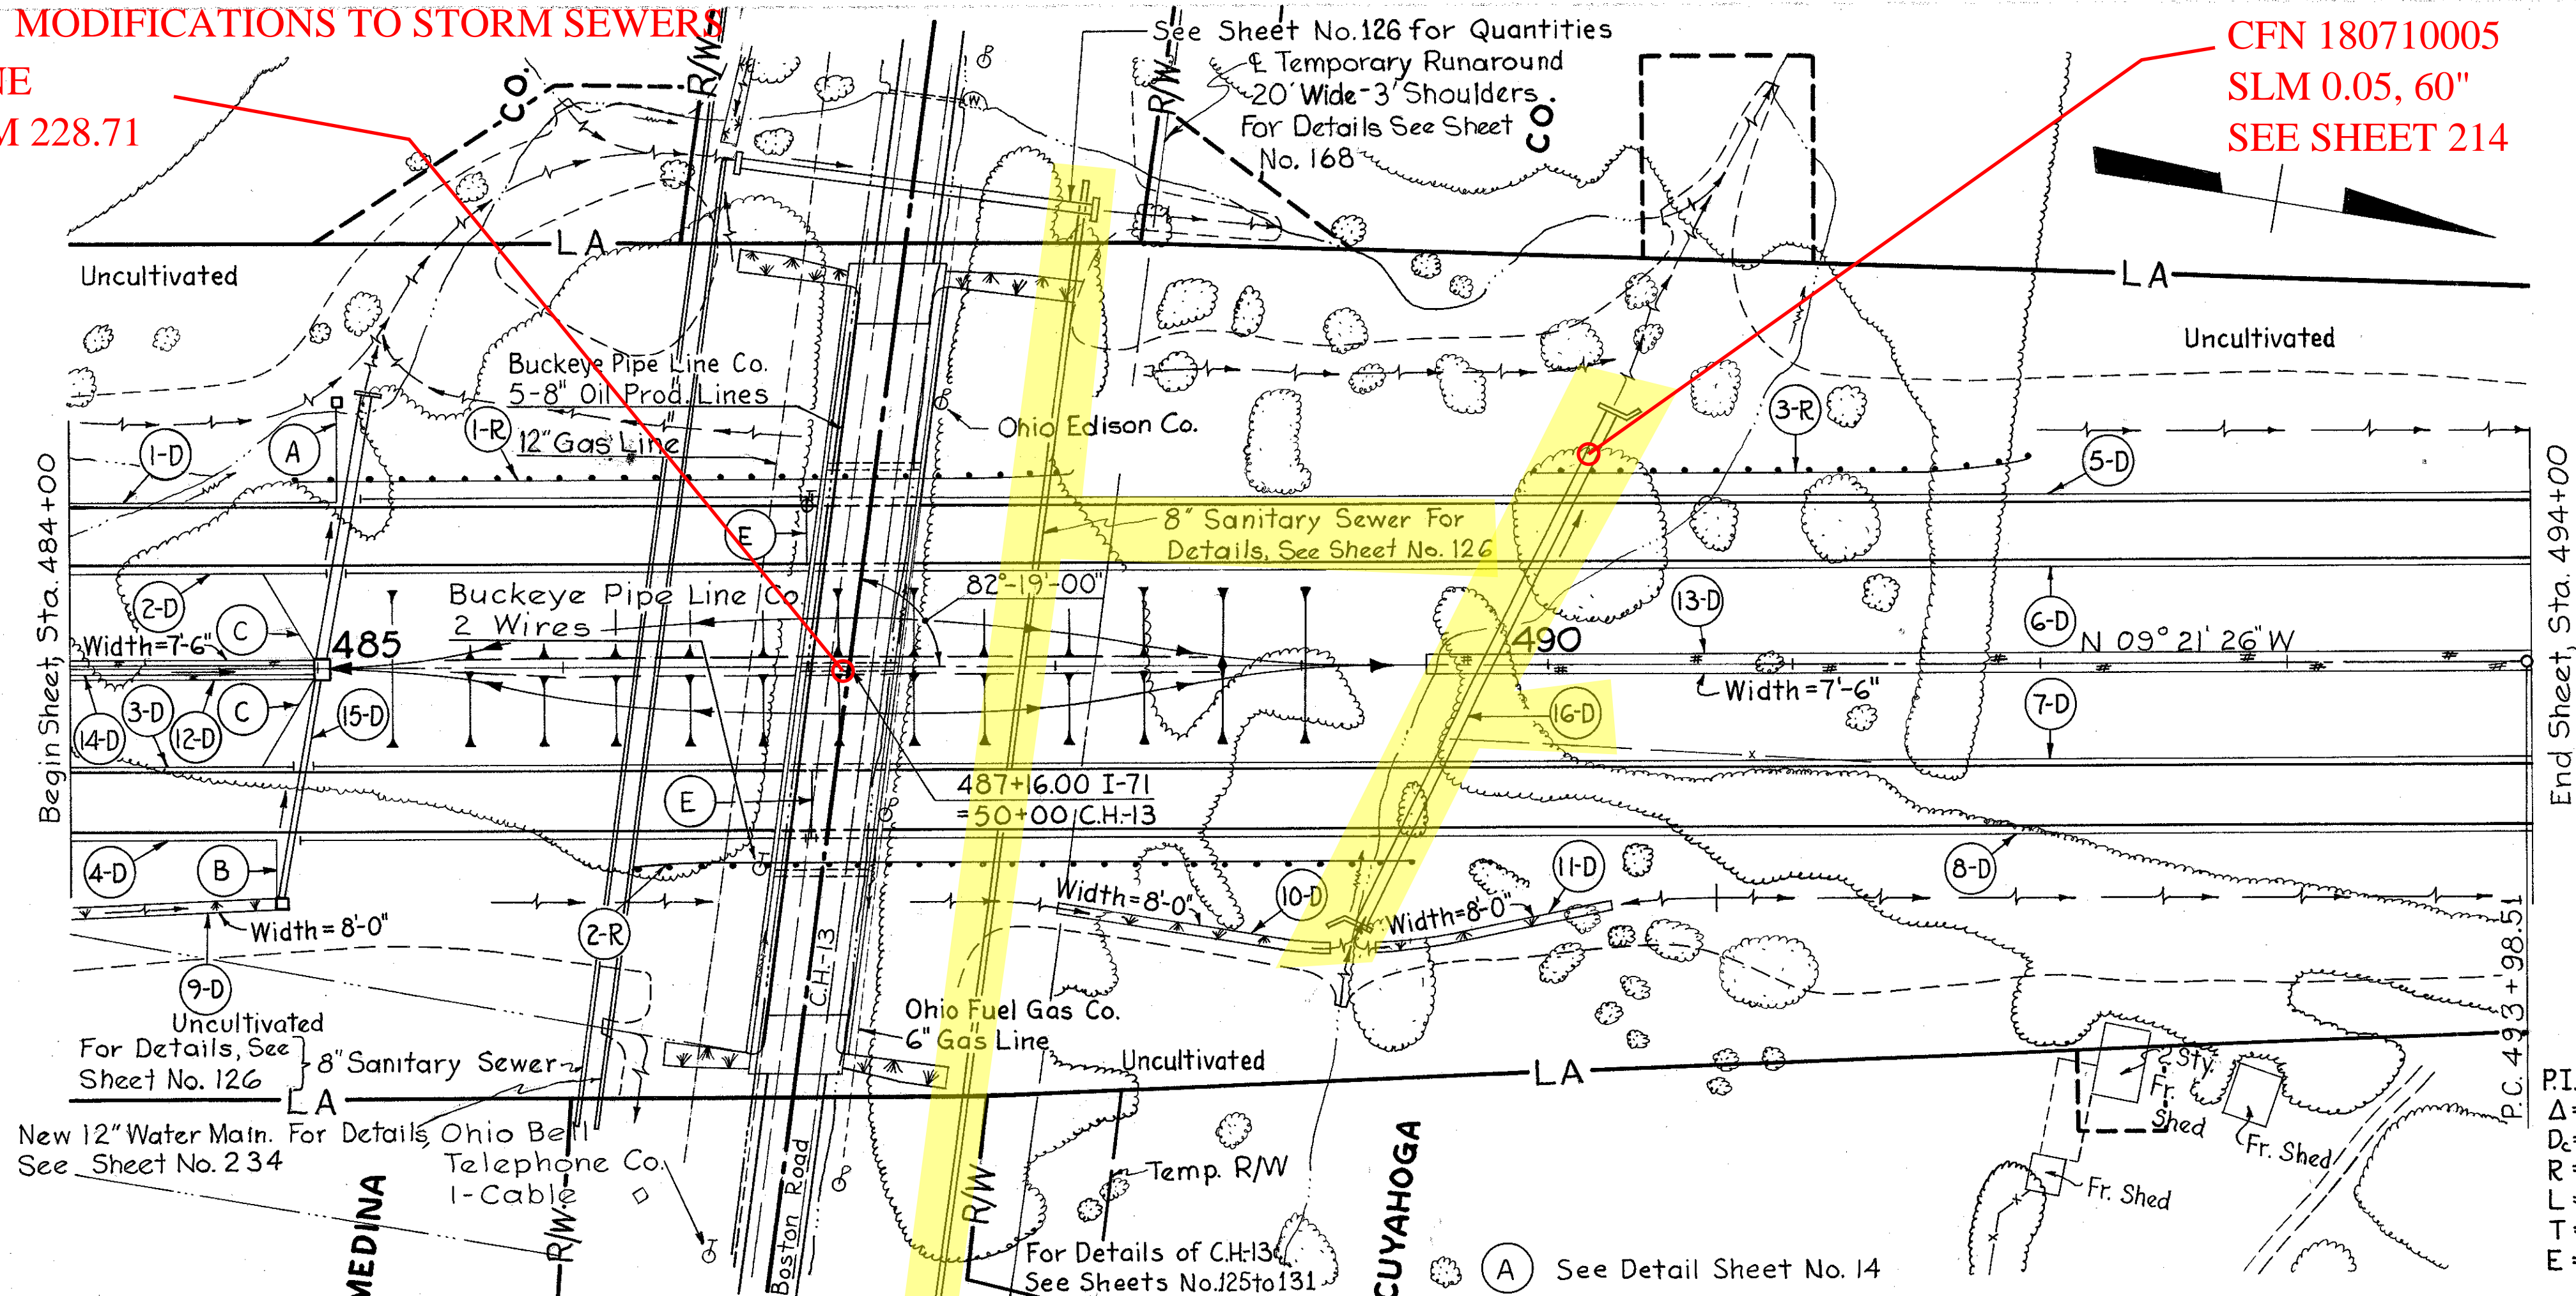


CFN 180710005
SLM 0.05, 60"
SEE SHEET 214

MEDINA AND CUYAHOGA COUNTIES
MED-42-26.17
CUY-42-0.00

2	OHIO	I-71-5(15)233
---	------	---------------

36
302

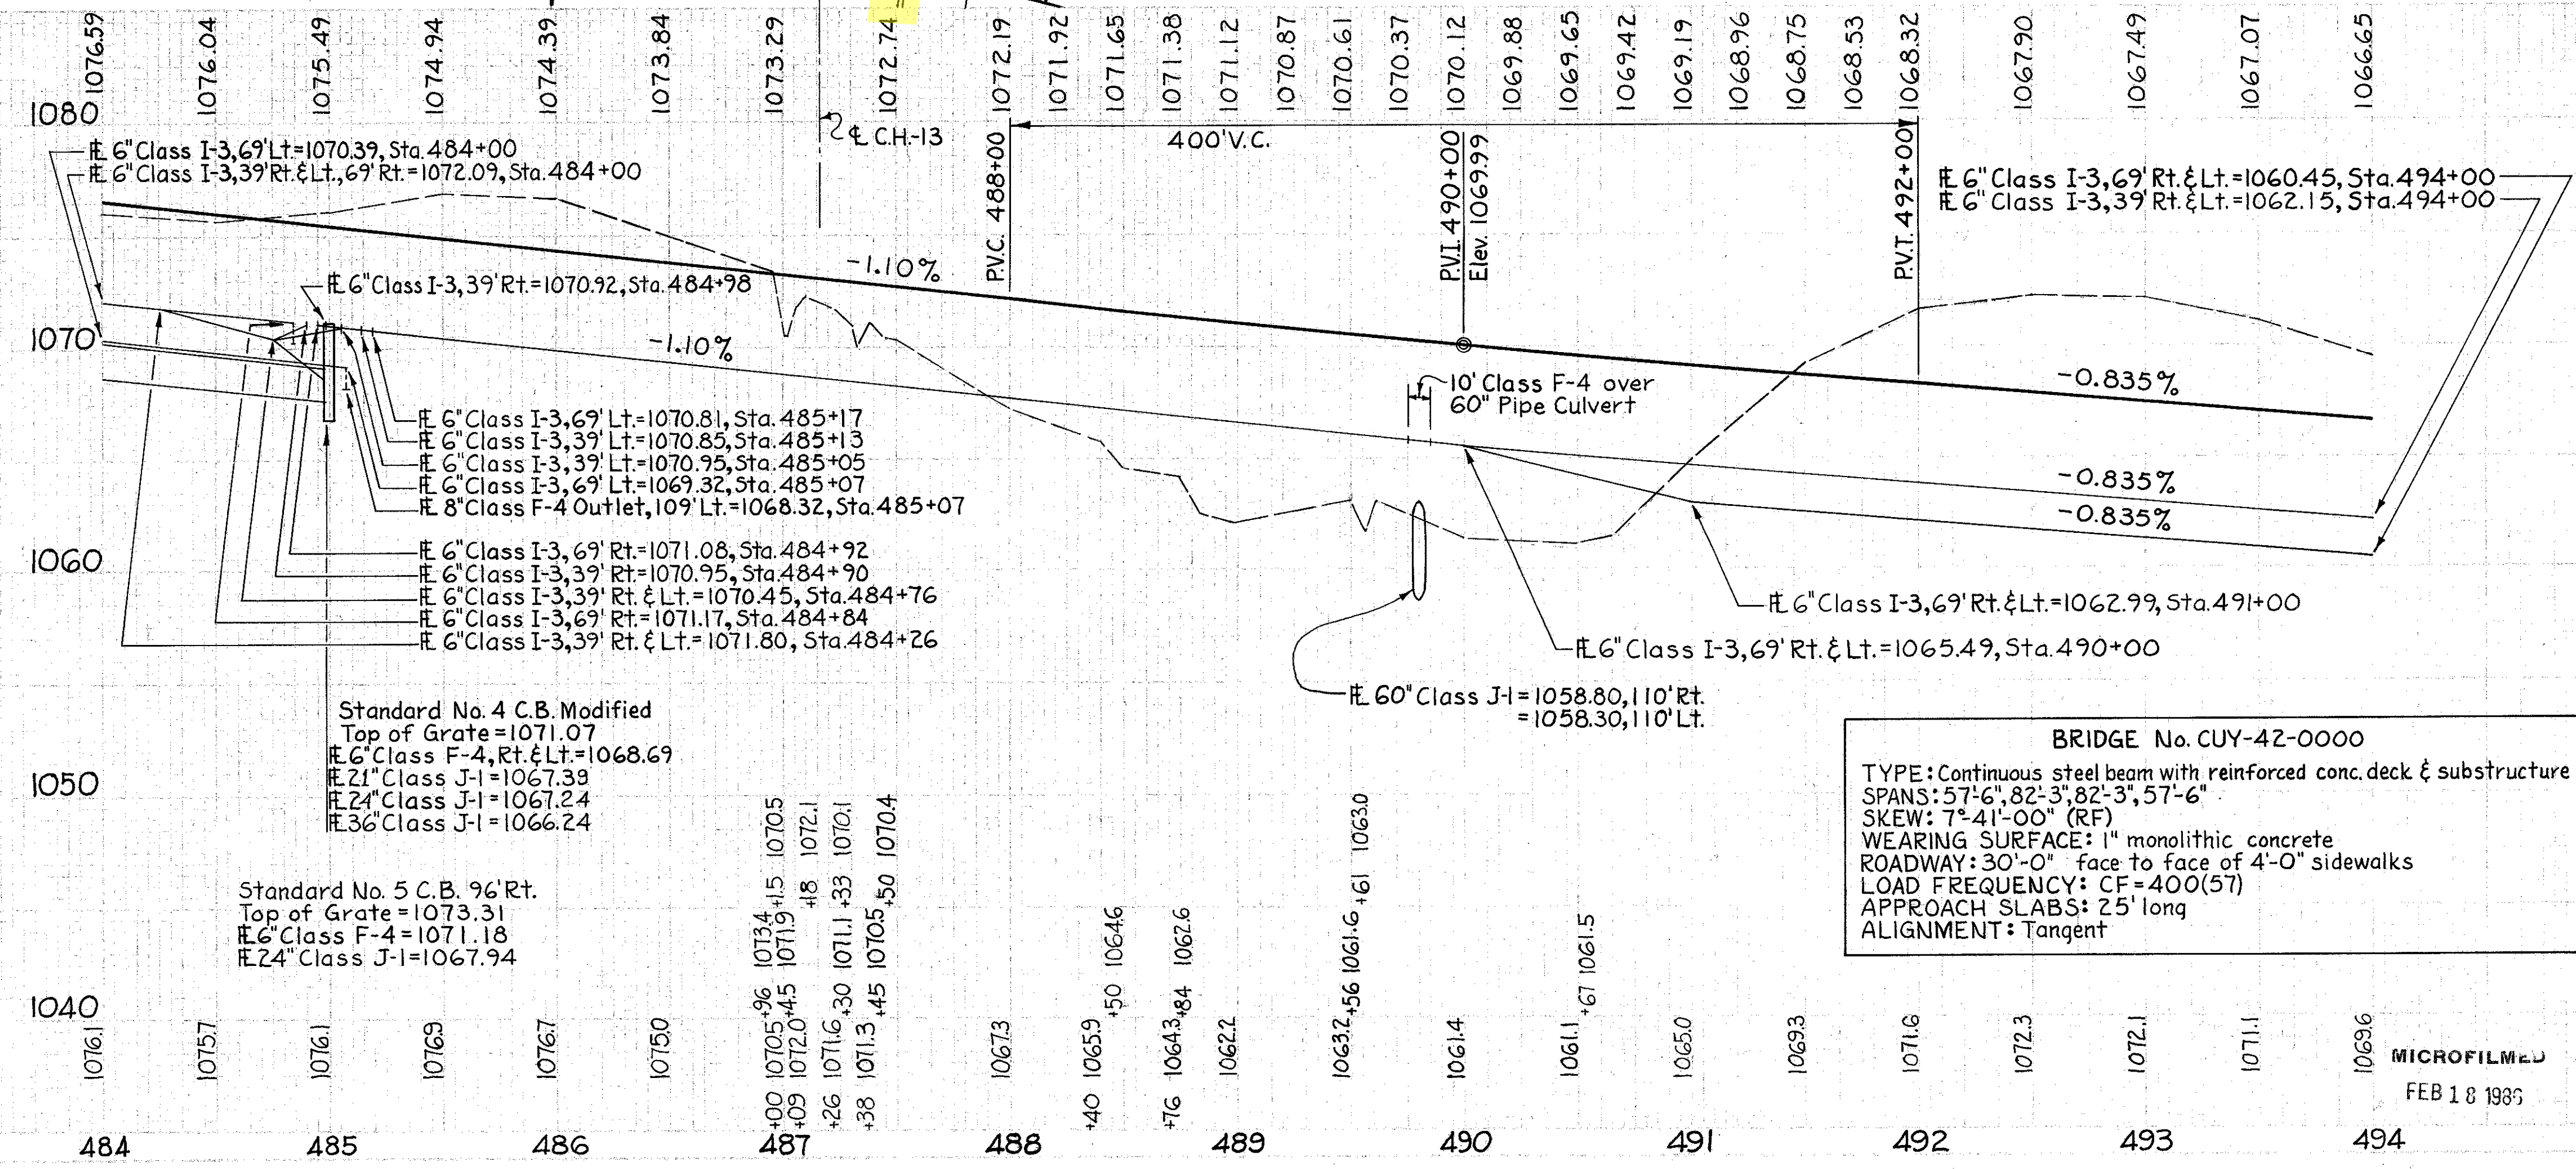

BRIDGE No. CUY-42-0000
TYPE: Continuous steel beam with reinforced conc. deck & substructure
SPANS: 57'-6", 82'-3", 82'-3", 57'-6"
SKEW: 7°-41'-00" (RF)
WEARING SURFACE: 1" monolithic concrete
ROADWAY: 30'-0" face to face of 4'-0" sidewalks
LOAD FREQUENCY: CF=400(57)
APPROACH SLABS: 25' long
ALIGNMENT: Tangent

ESTIMATED QUANTITIES

REF NO.	STATION TO STATION	CLASS	QUANTITY	UNIT	SEE SHEET NO.
1-D	484+00 to 485+07	Class A-1 Pipe	220	Lin. Ft.	
2-D	484+00 to 485+03	Class J-1 Pipe	96	116	
