SEE 2001 CUY-71-0.00 PLANS FOR MODIFICATIONS TO STORM SEWERS

CFN 180710073
SLM 0.72, 36"
SEE SHEET 216

CFN 180710072
SLM 0.72, 36"
SEE SHEET 216

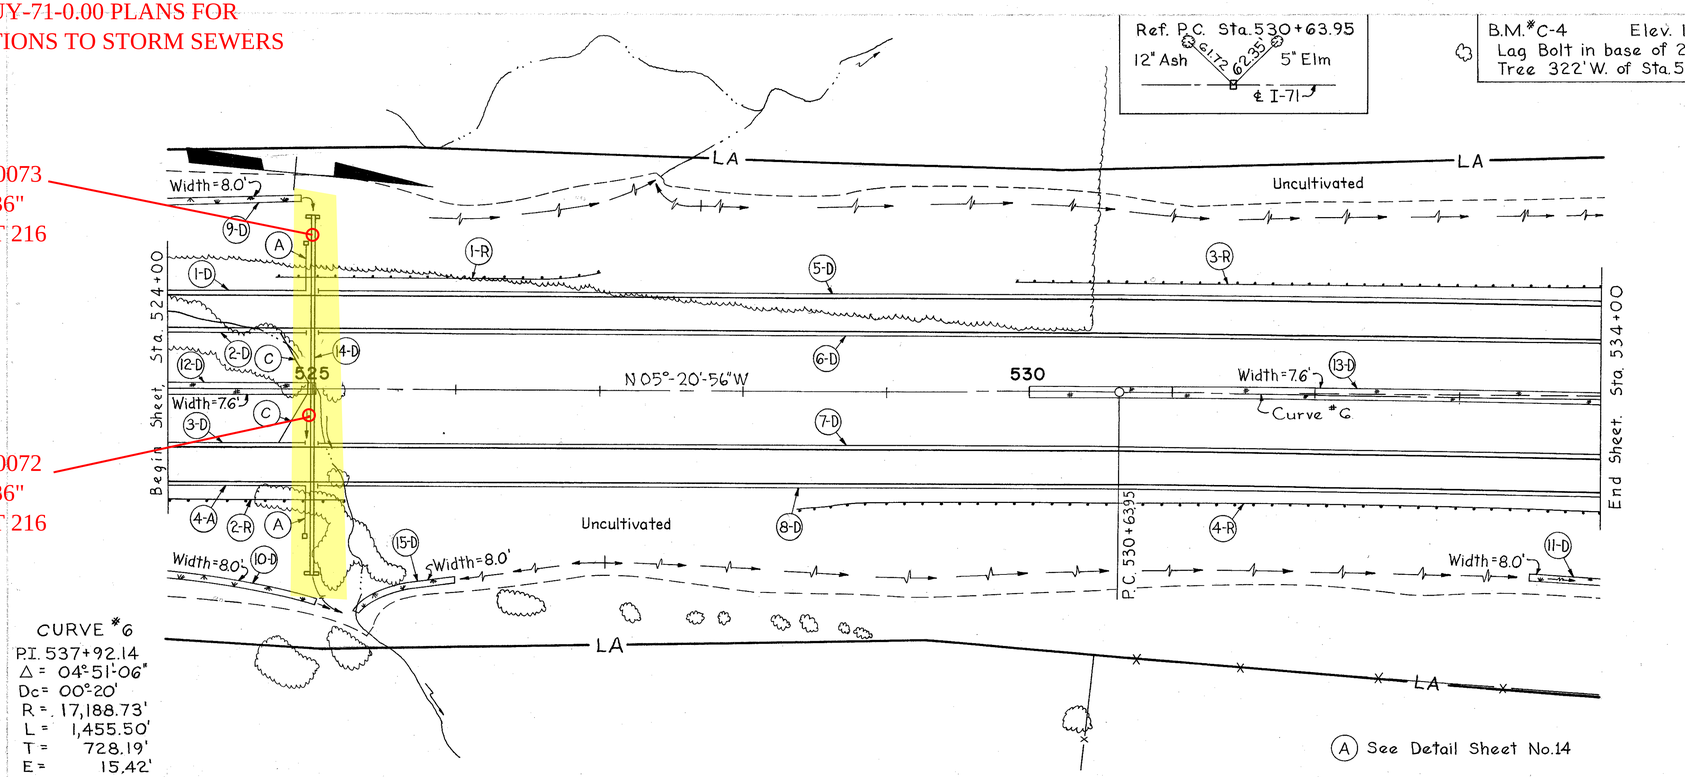

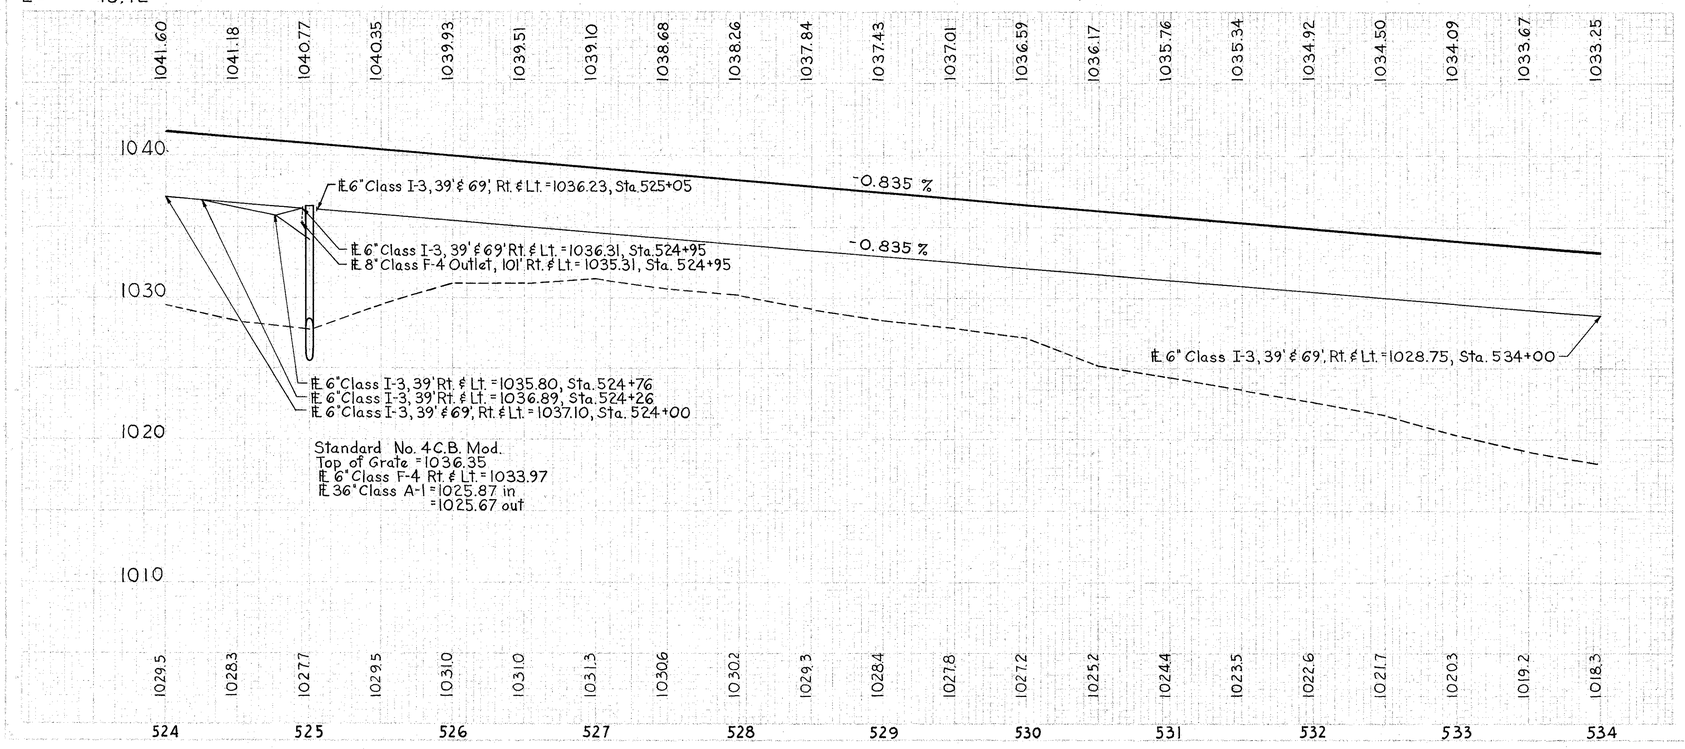

CUYAHOGA COUNTY
MED- 42-26.17
CUY- 42-0.00

DISTRICT	STATE	ROUTE		SHEET	TOTAL SHEETS
2	OHIO	I-71-5(15)233		40	302

ESTIMATED QUANTITIES

REF. NO.	STATION TO STATION	SIDE	Class A-1 Pipe Sec. M6.6(b) M6.8(b) 36" Lin. ft.	Class I-1 Pipe I-3, Pipe 6" Shallow Lin. ft.	Class F-4 Pipe 6" Lin. ft.	Class F-4 Pipe 8" Lin. ft.	I-2 Masonry Headwall Type E Cu. Yd.	I-5 Pipe Specials 6"-90° Bend Each	I-5 Pipe Specials 6"-60° Wye Each	I-8 Std. No. 4 C.B. Each	I-15 Guard Rail Lin. ft.	L-10 Sodding Sq. Yd.	L-120 Jute Matting Sq. Yd.	E-3 Channel Excav. Cu. Yd.	SEE SHEET NO.
1-D	524+00 to 524+95	Lt.		117		10		1							
2-D	524+00 to 524+95	Lt.		129	10				1						
3-D	524+00 to 524+95	Rt.		129	10				1						
4-D	524+00 to 524+95	Rt.		117				1							
5-D	525+05 to 534+00	Lt.		895											
6-D	525+05 to 534+00	Lt.		895											
7-D	525+05 to 534+00	Rt.		895											
8-D	525+05 to 534+00	Rt.		895											
9-D	524+00 to 525+32	Lt.													
10-D	524+00 to 526+00	Rt.													
11-D	533+50 to 534+00	Rt.													
12-D	524+00 to 525+00	Med.													
13-D	530+00 to 534+00	Med.													
14-D	525+00									1					
15-D	525+25 to 526+00	Rt.	2.52				10.02								
1-R	524+75 to 570+00	Lt.									225				
2-R	524+00 to 525+25	Rt.									125				
3-R	529+91 to 534+00	Lt.									409				
4-R	528+41 to 534+00	Rt.									539				
										1	1,318	322	416	5	216
TOTAL			2.52	4,072	20	20	10.02	2	2	1	1,318	322	416	5	

Sta. 524+00 to Sta. 534+00