


CUYAHOGA COUNTY
MED-42-26.17
CUY-42-0.00

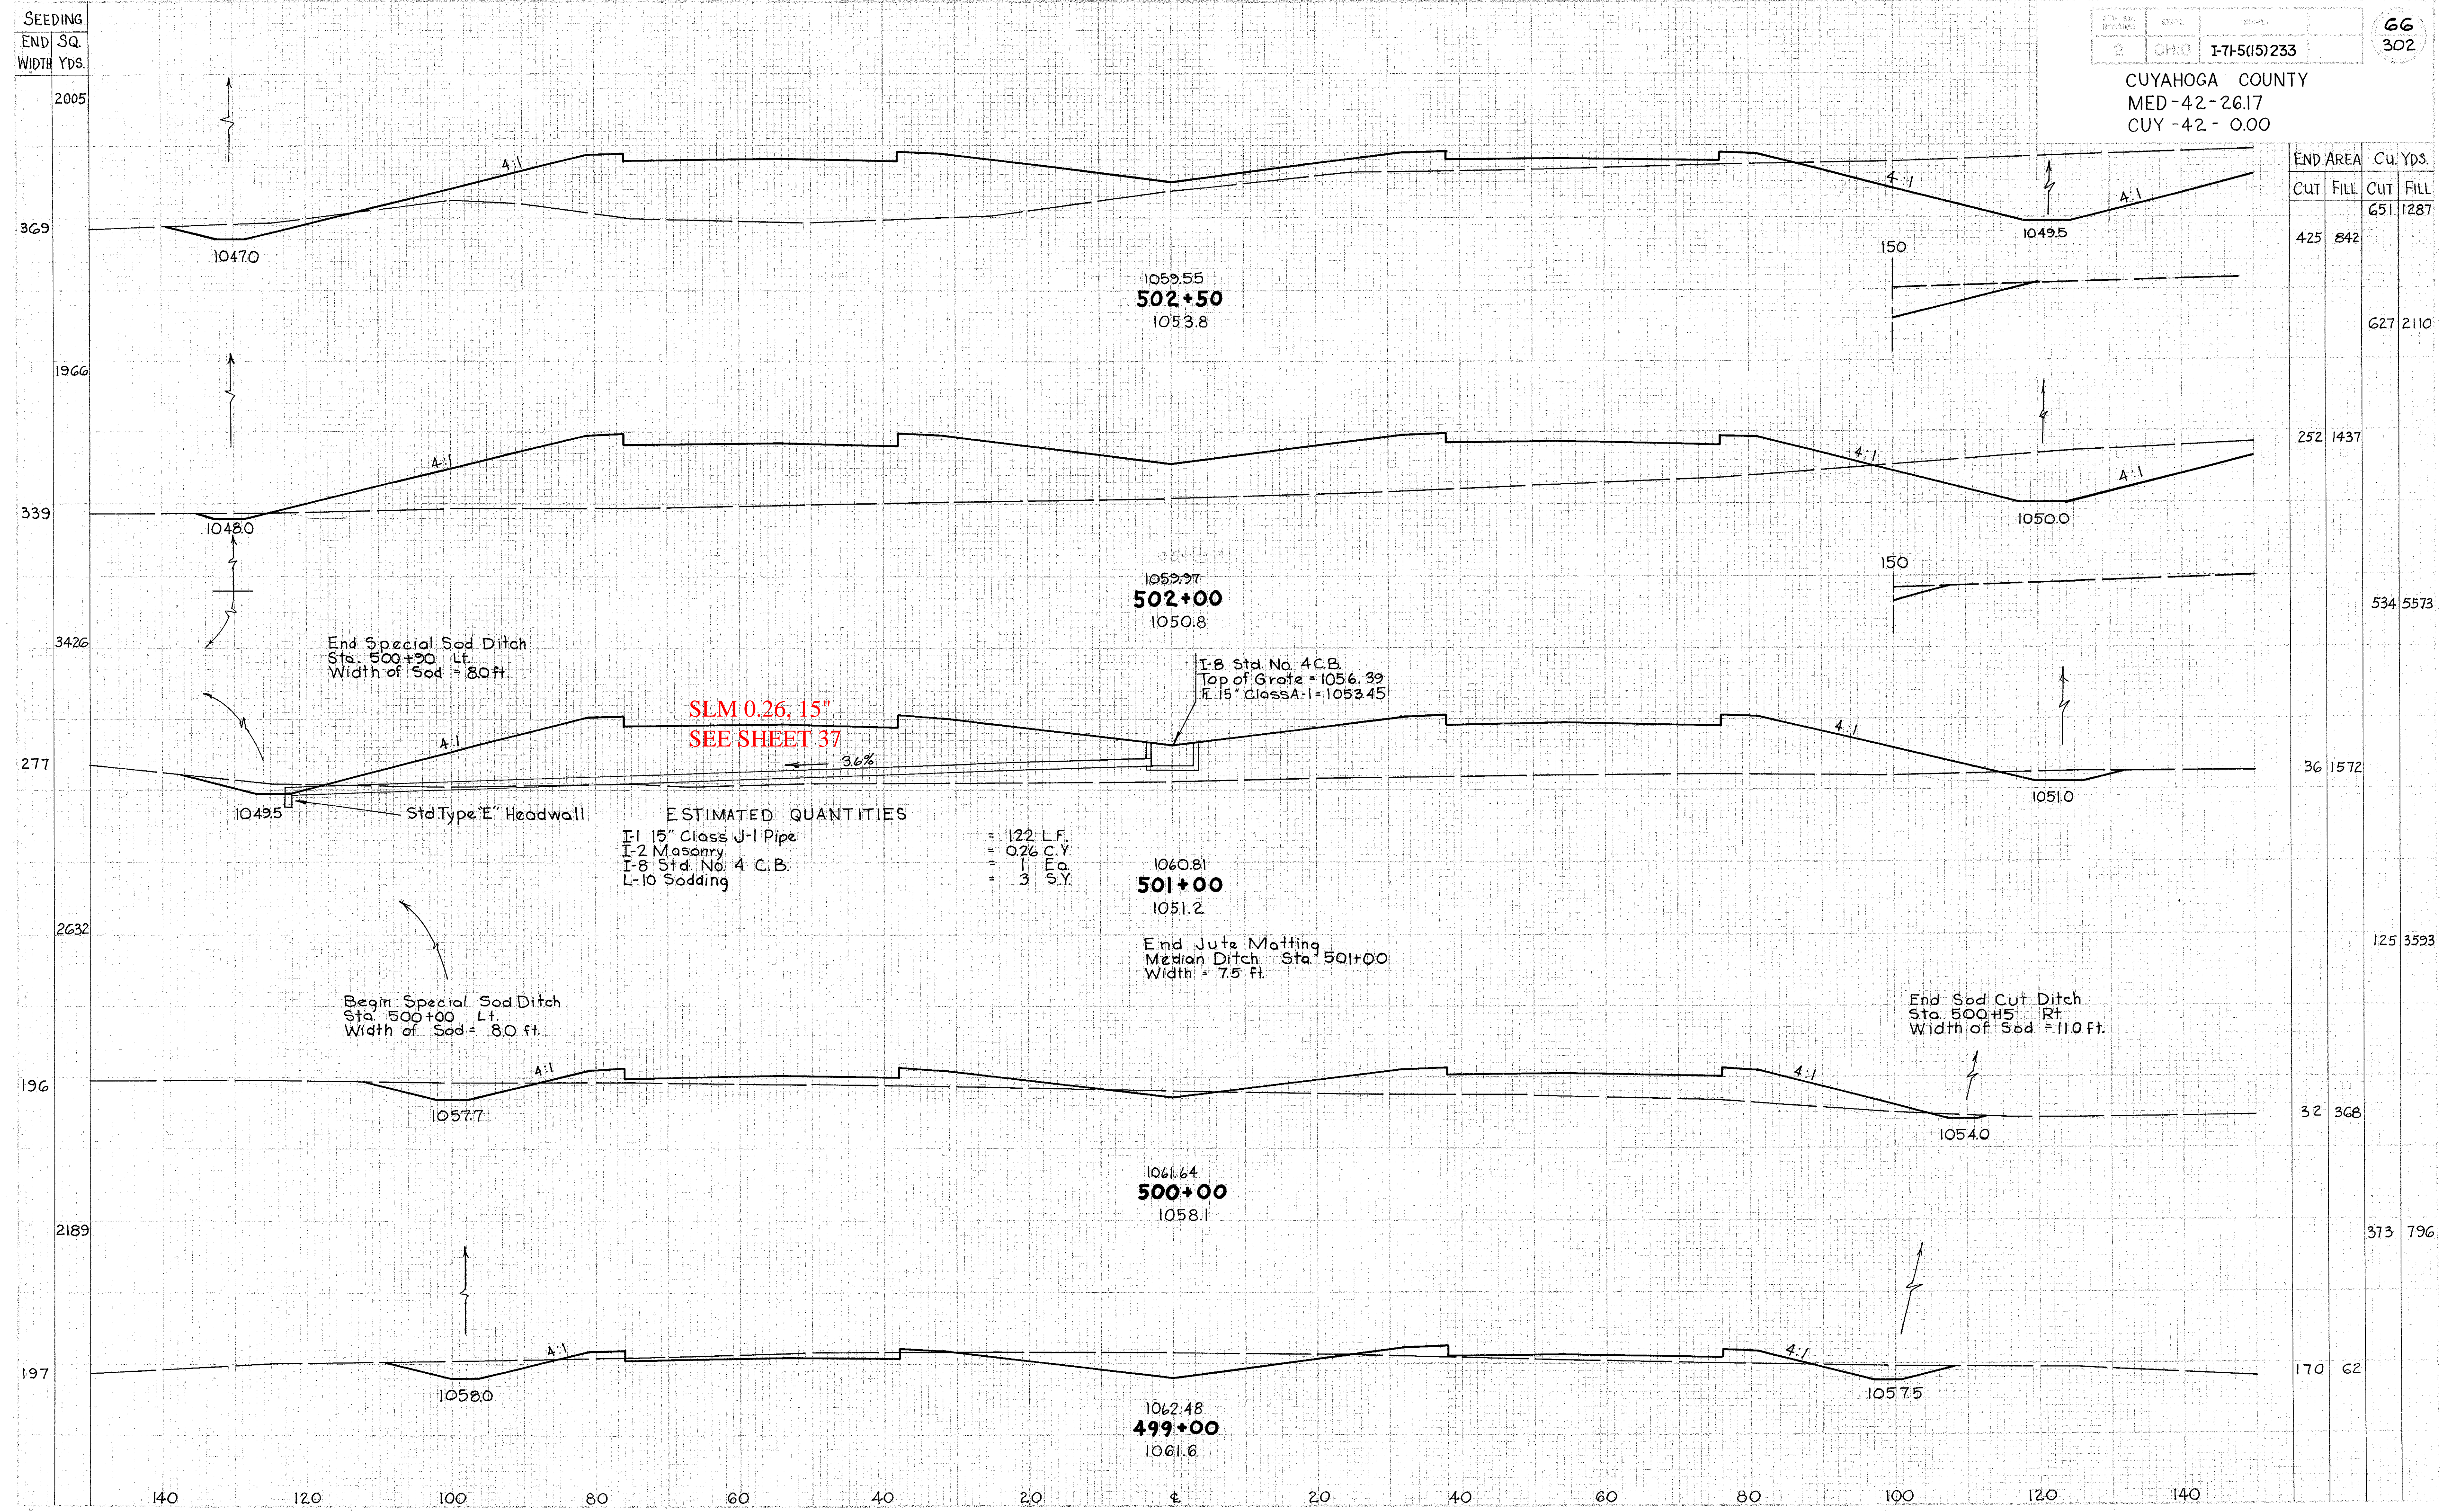

End Special Sod Ditch
Sta. 500+30 Lt.
Width of Sod = 80 ft.

Begin Special Sod Ditch
Sta. 500+00 Lt.
Width of Sod = 80 ft.

SLM 0.26, 15"
SEE SHEET 37

ESTIMATED QUANTITIES

- I-15" Class J-I Pipe = 122 LF.
- I-2 Masonry = 0.26 C.Y.
- I-8 Std. No. 4 C.B. = 1 Ea.
- L-10 Sodding = 3 S.Y.

I-8 Std. No. 4 C.B.
Top of Grate = 1056.39
R. 15" Class A-1 = 1053.45

End Sod Cut Ditch
Sta. 500+15 Rt.
Width of Sod = 110 ft.