


SEEDING
END SQ.
WIDTH YDS.

CUYAHOGA COUNTY
MED-42-2617
CUY-42-0.00

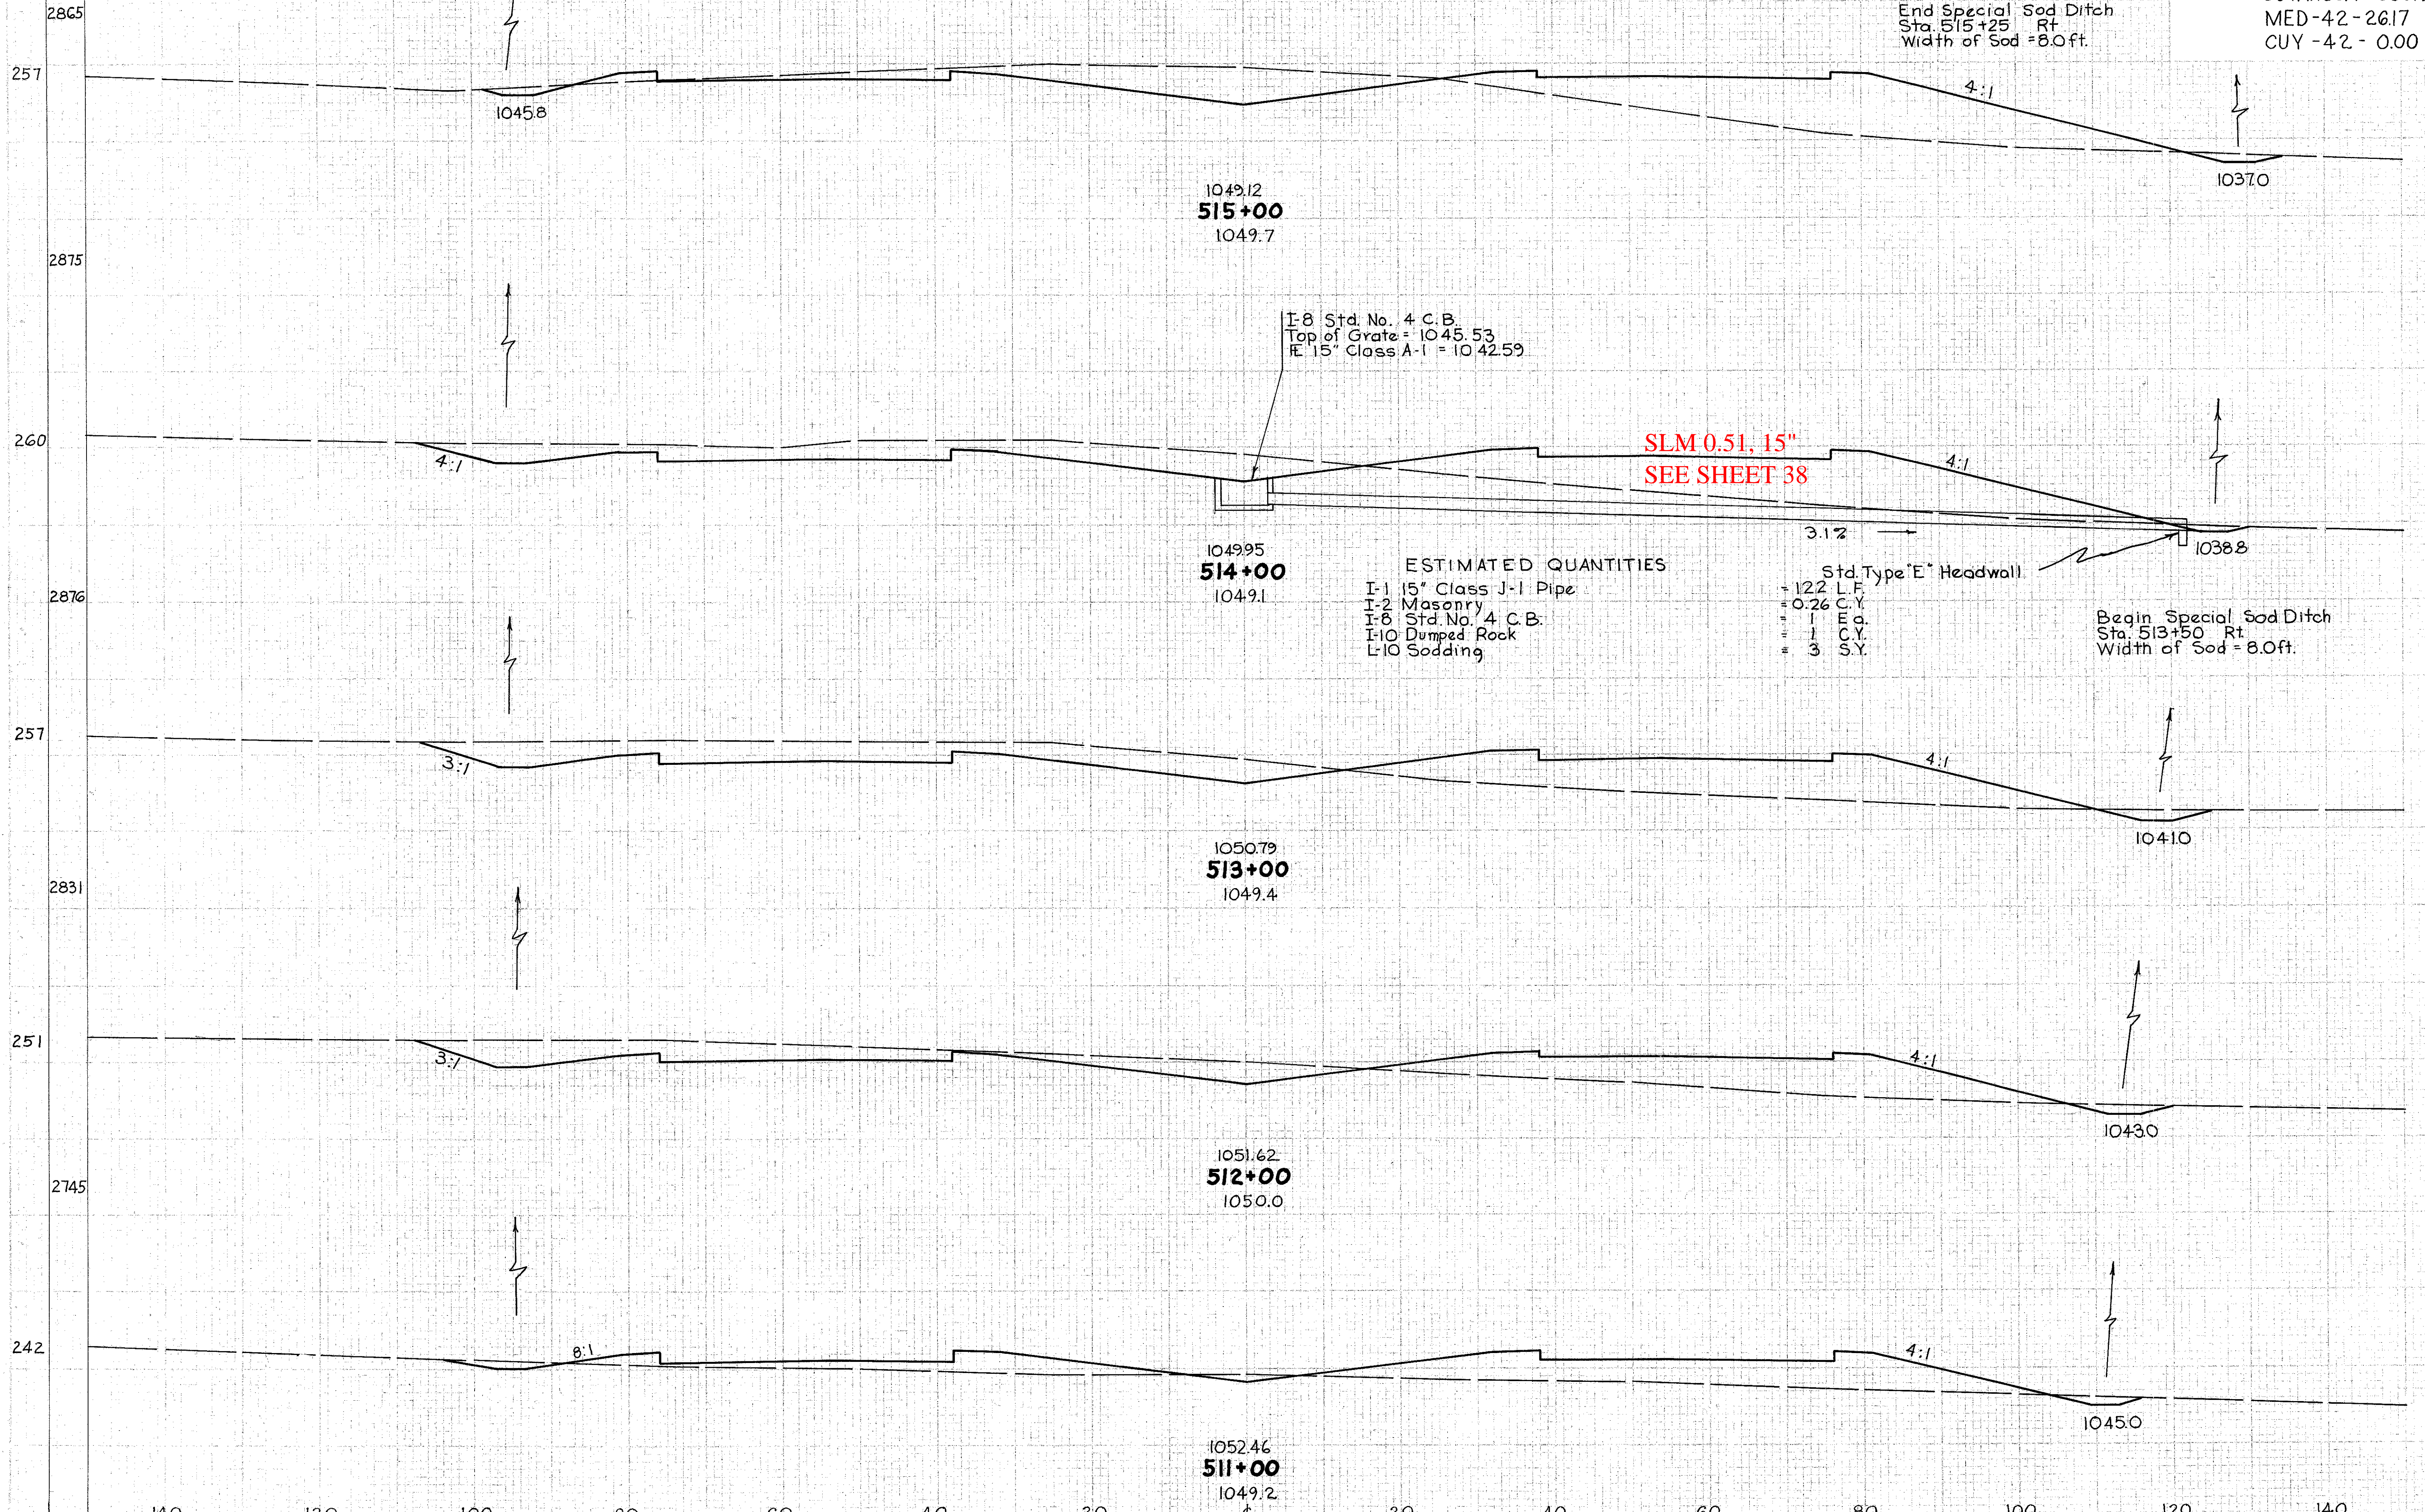

END AREA		Cu. YDS.	
CUT	FILL	CUT	FILL
221	399	995	1089
			865
245	425		1526
			975
281	380		1490
			955
234	280		1224
			490
30	352		1172

ESTIMATED QUANTITIES

- I-1 15" Class J-1 Pipe = 122 L.F.
- I-2 Masonry = 0.26 C.Y.
- I-8 Std. No. 4 C.B. = 1 Ea.
- I-10 Dumped Rock = 1 C.Y.
- L-10 Sodding = 3 S.Y.

Std. Type "E" Headwall

SLM 0.51, 15"
SEE SHEET 38

Begin Special Sod Ditch
Sta. 513+50 Rt.
Width of Sod = 8.0ft.

End Special Sod Ditch
Sta. 515+25 Rt.
Width of Sod = 8.0ft.