


SEEDING
END SQ.
WIDTH YDS.

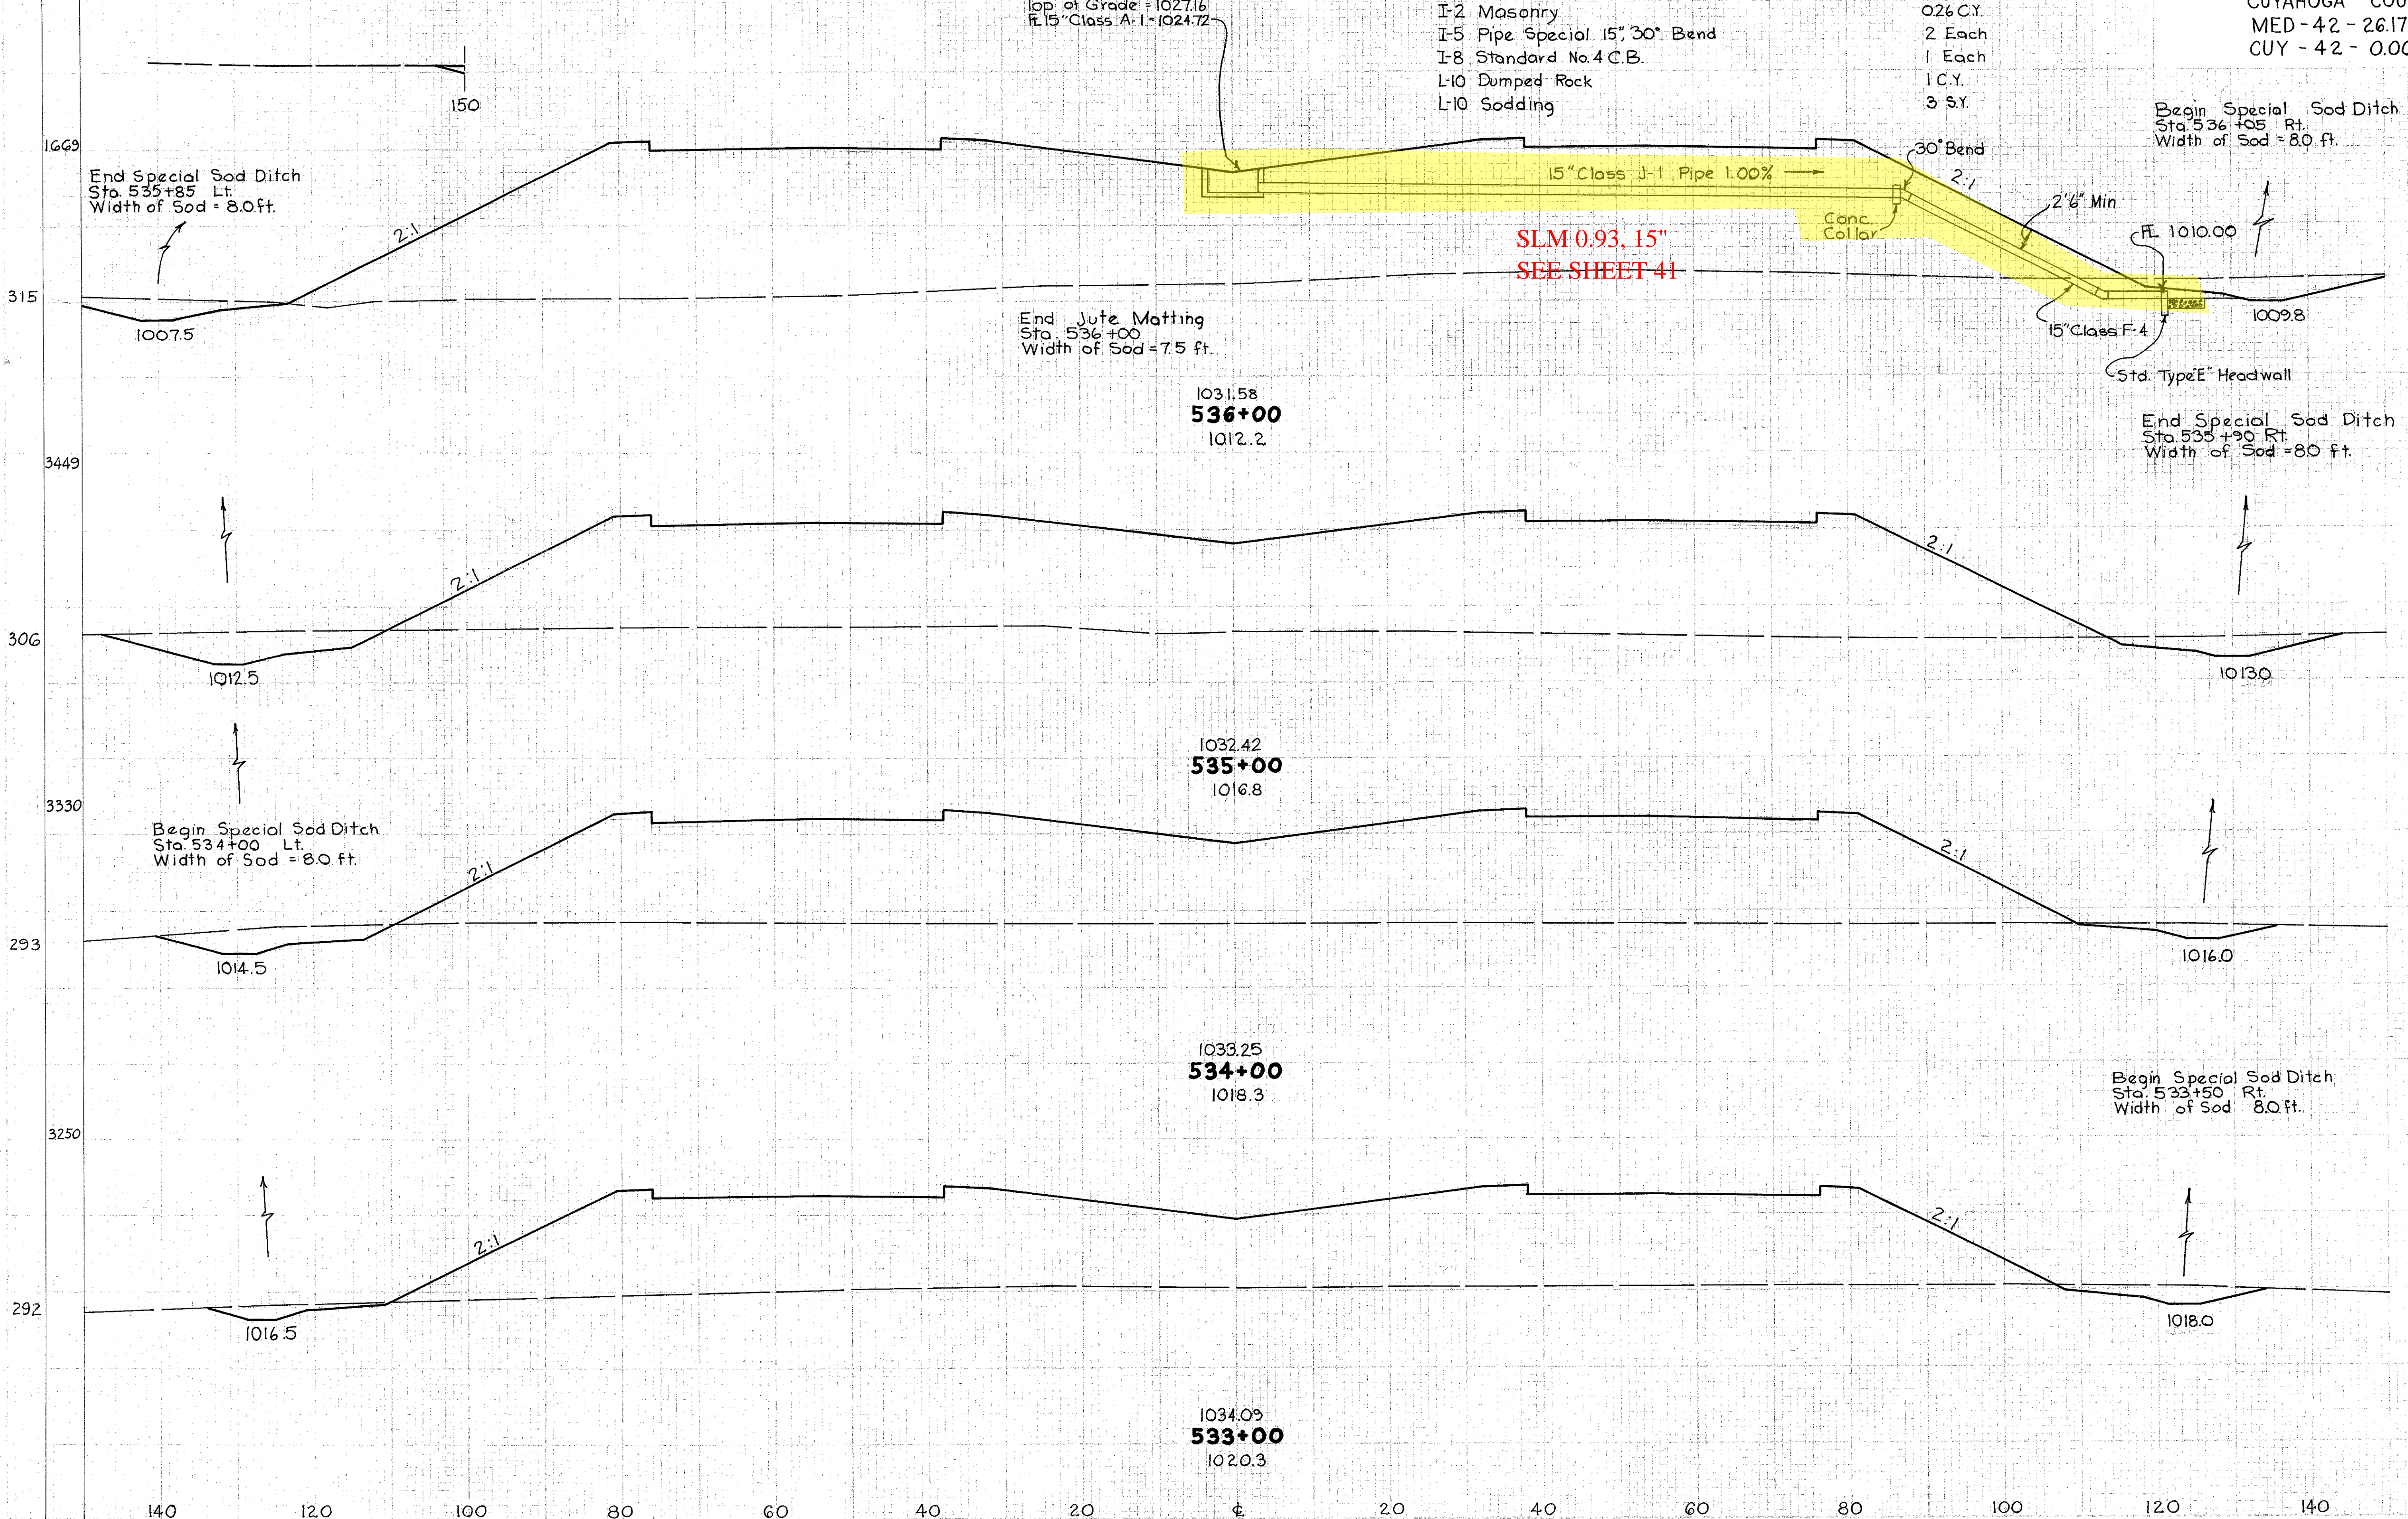

ESTIMATED QUANTITIES

I-1 15" Class J-1 Pipe	88 Lin. ft.
15" Class F-4 Pipe	38 Lin. ft.
I-2 Masonry	0.26 C.Y.
I-5 Pipe Special 15" 30° Bend	2 Each
I-8 Standard No. 4 C.B.	1 Each
L-10 Dumped Rock	1 C.Y.
L-10 Sodding	3 S.Y.

CUYAHOGA COUNTY
MED-42-26.17
CUI-42-0.00

END AREA	Cu. Yds.	
	CUT	FILL
183	6786	
110	3613	
475	11795	
146	2756	
440	9835	
91	2554	
282	9044	
61	2329	