


CUYAHOGA COUNTY  
MED-42-26.17  
CUY-42-0.00

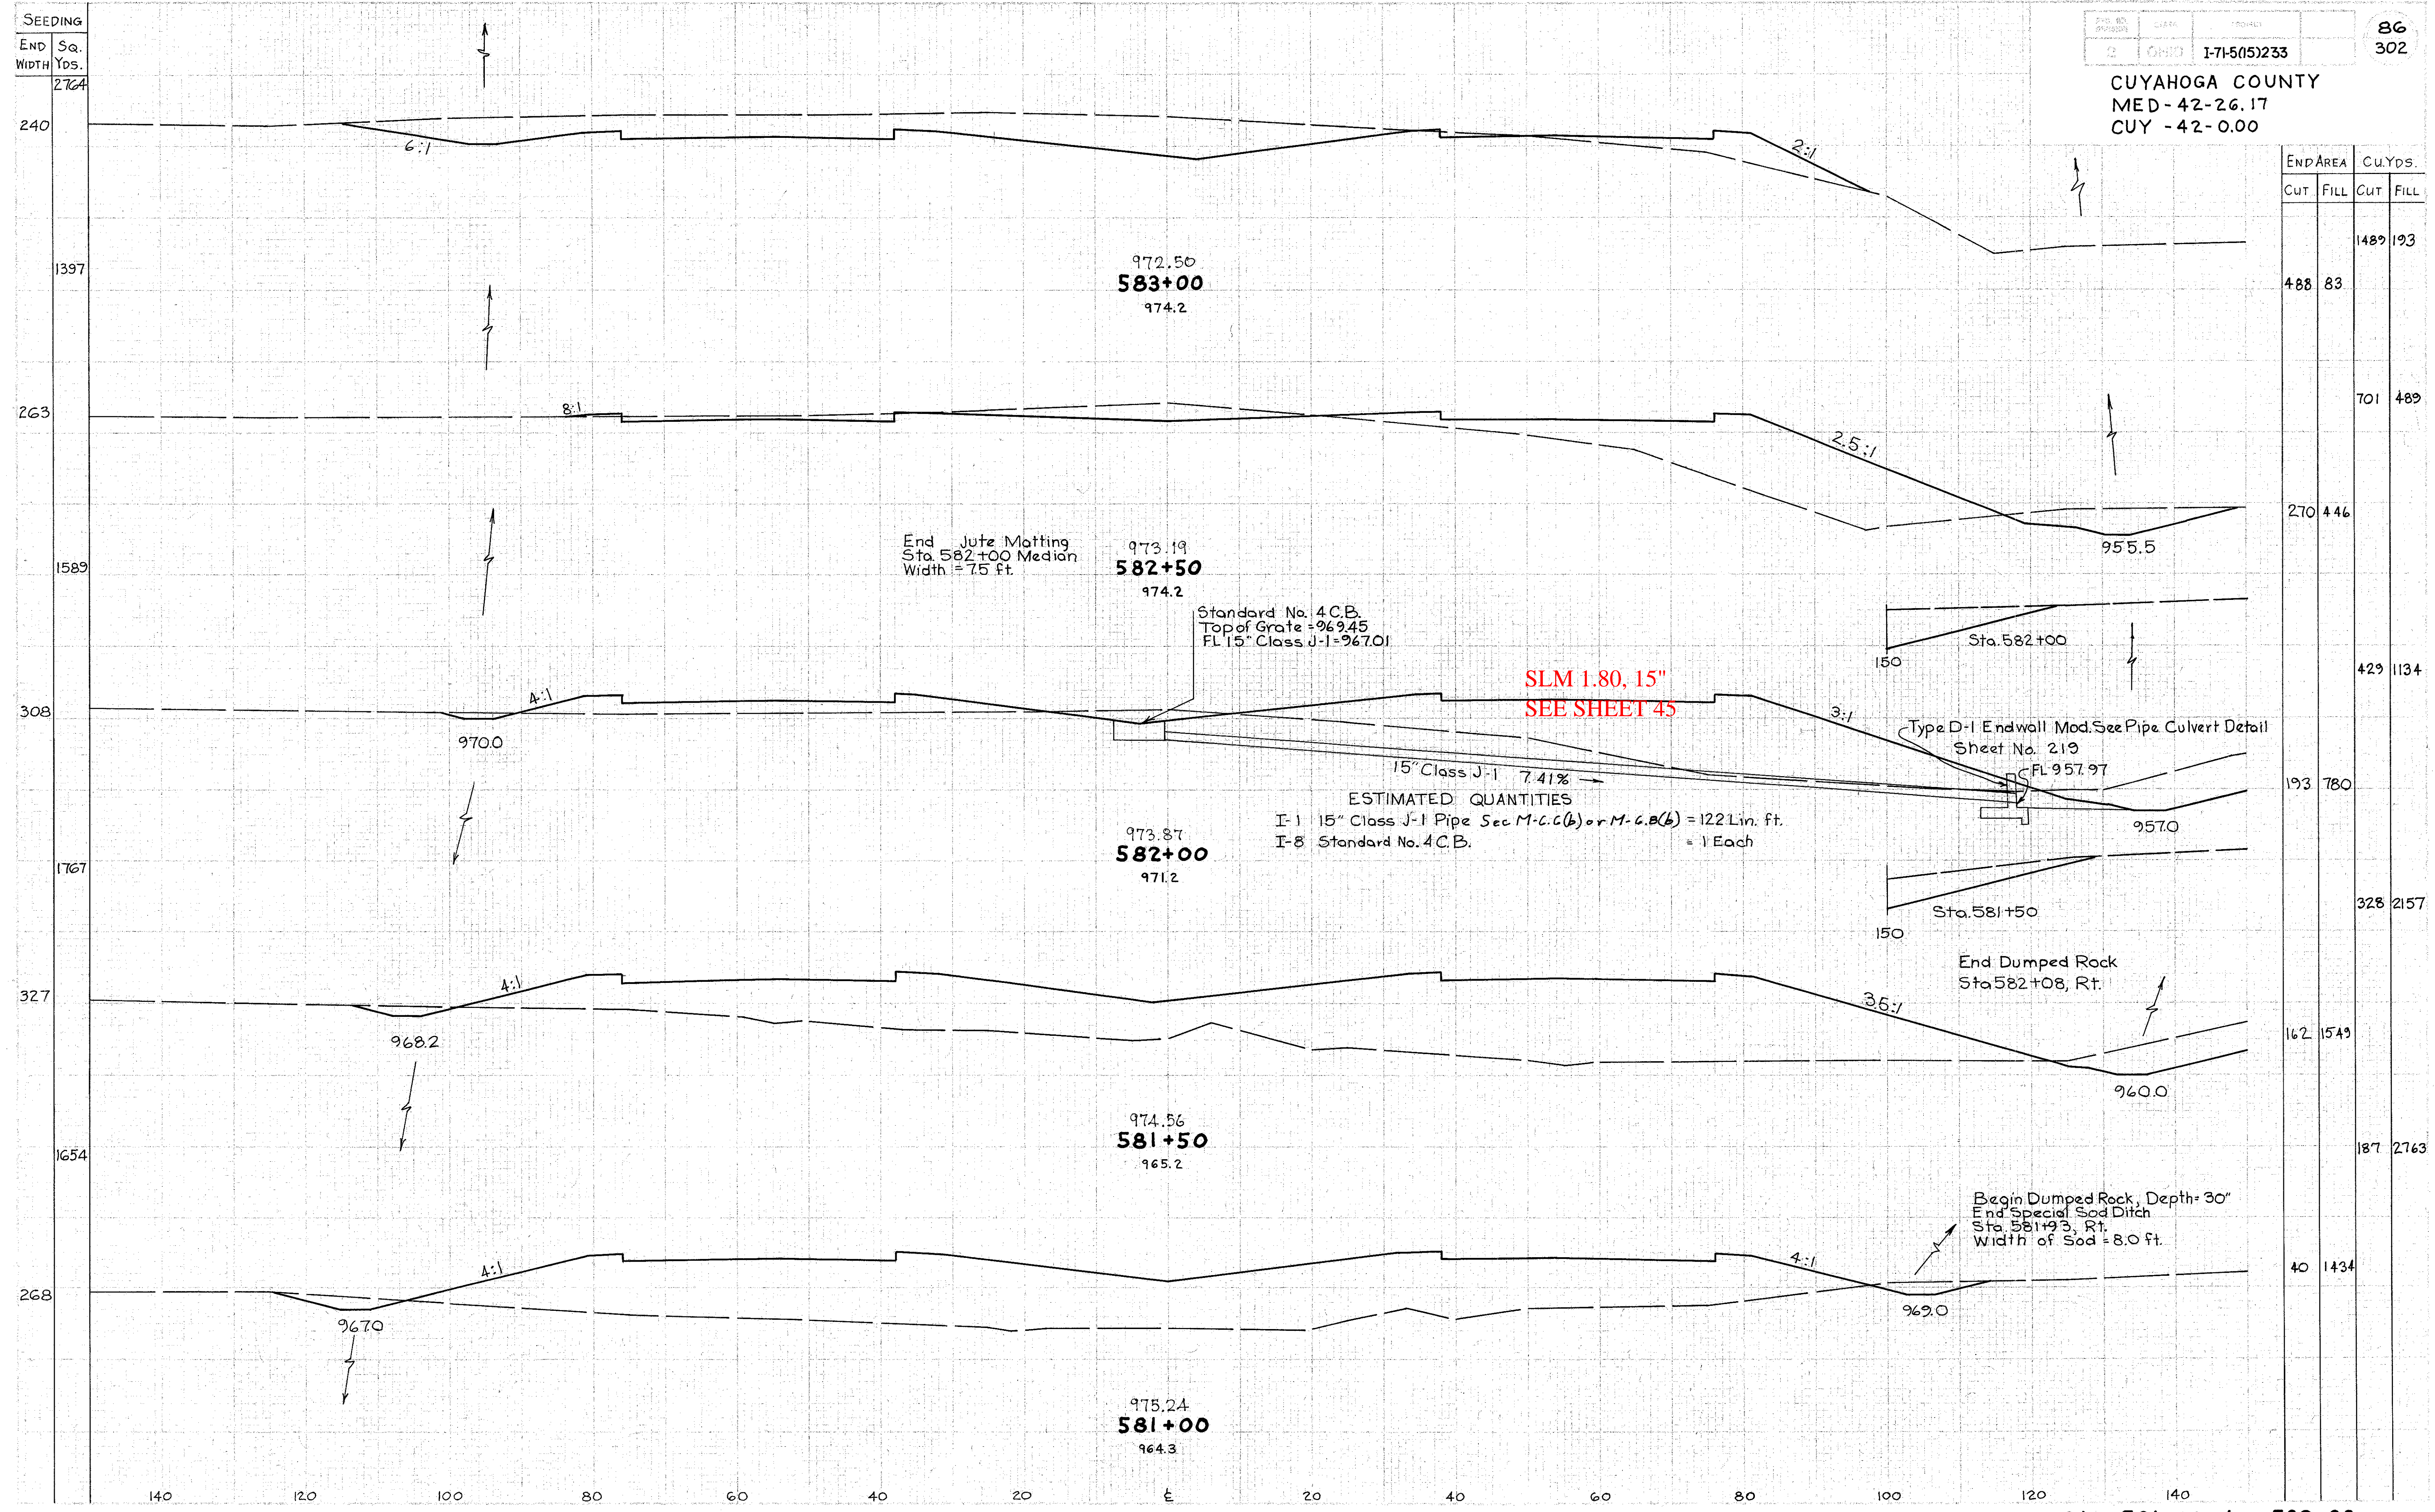

END AREA		CU.YDS.	
CUT	FILL	CUT	FILL
488	83	1489	193
		701	489
270	446		
		429	1134
193	780		
		328	2157
162	1549		
		187	2763
40	1434		

Sta. 581+00 to 583+00