


CUYAHOGA COUNTY
MED-42-26.62
CUY-42-0.00

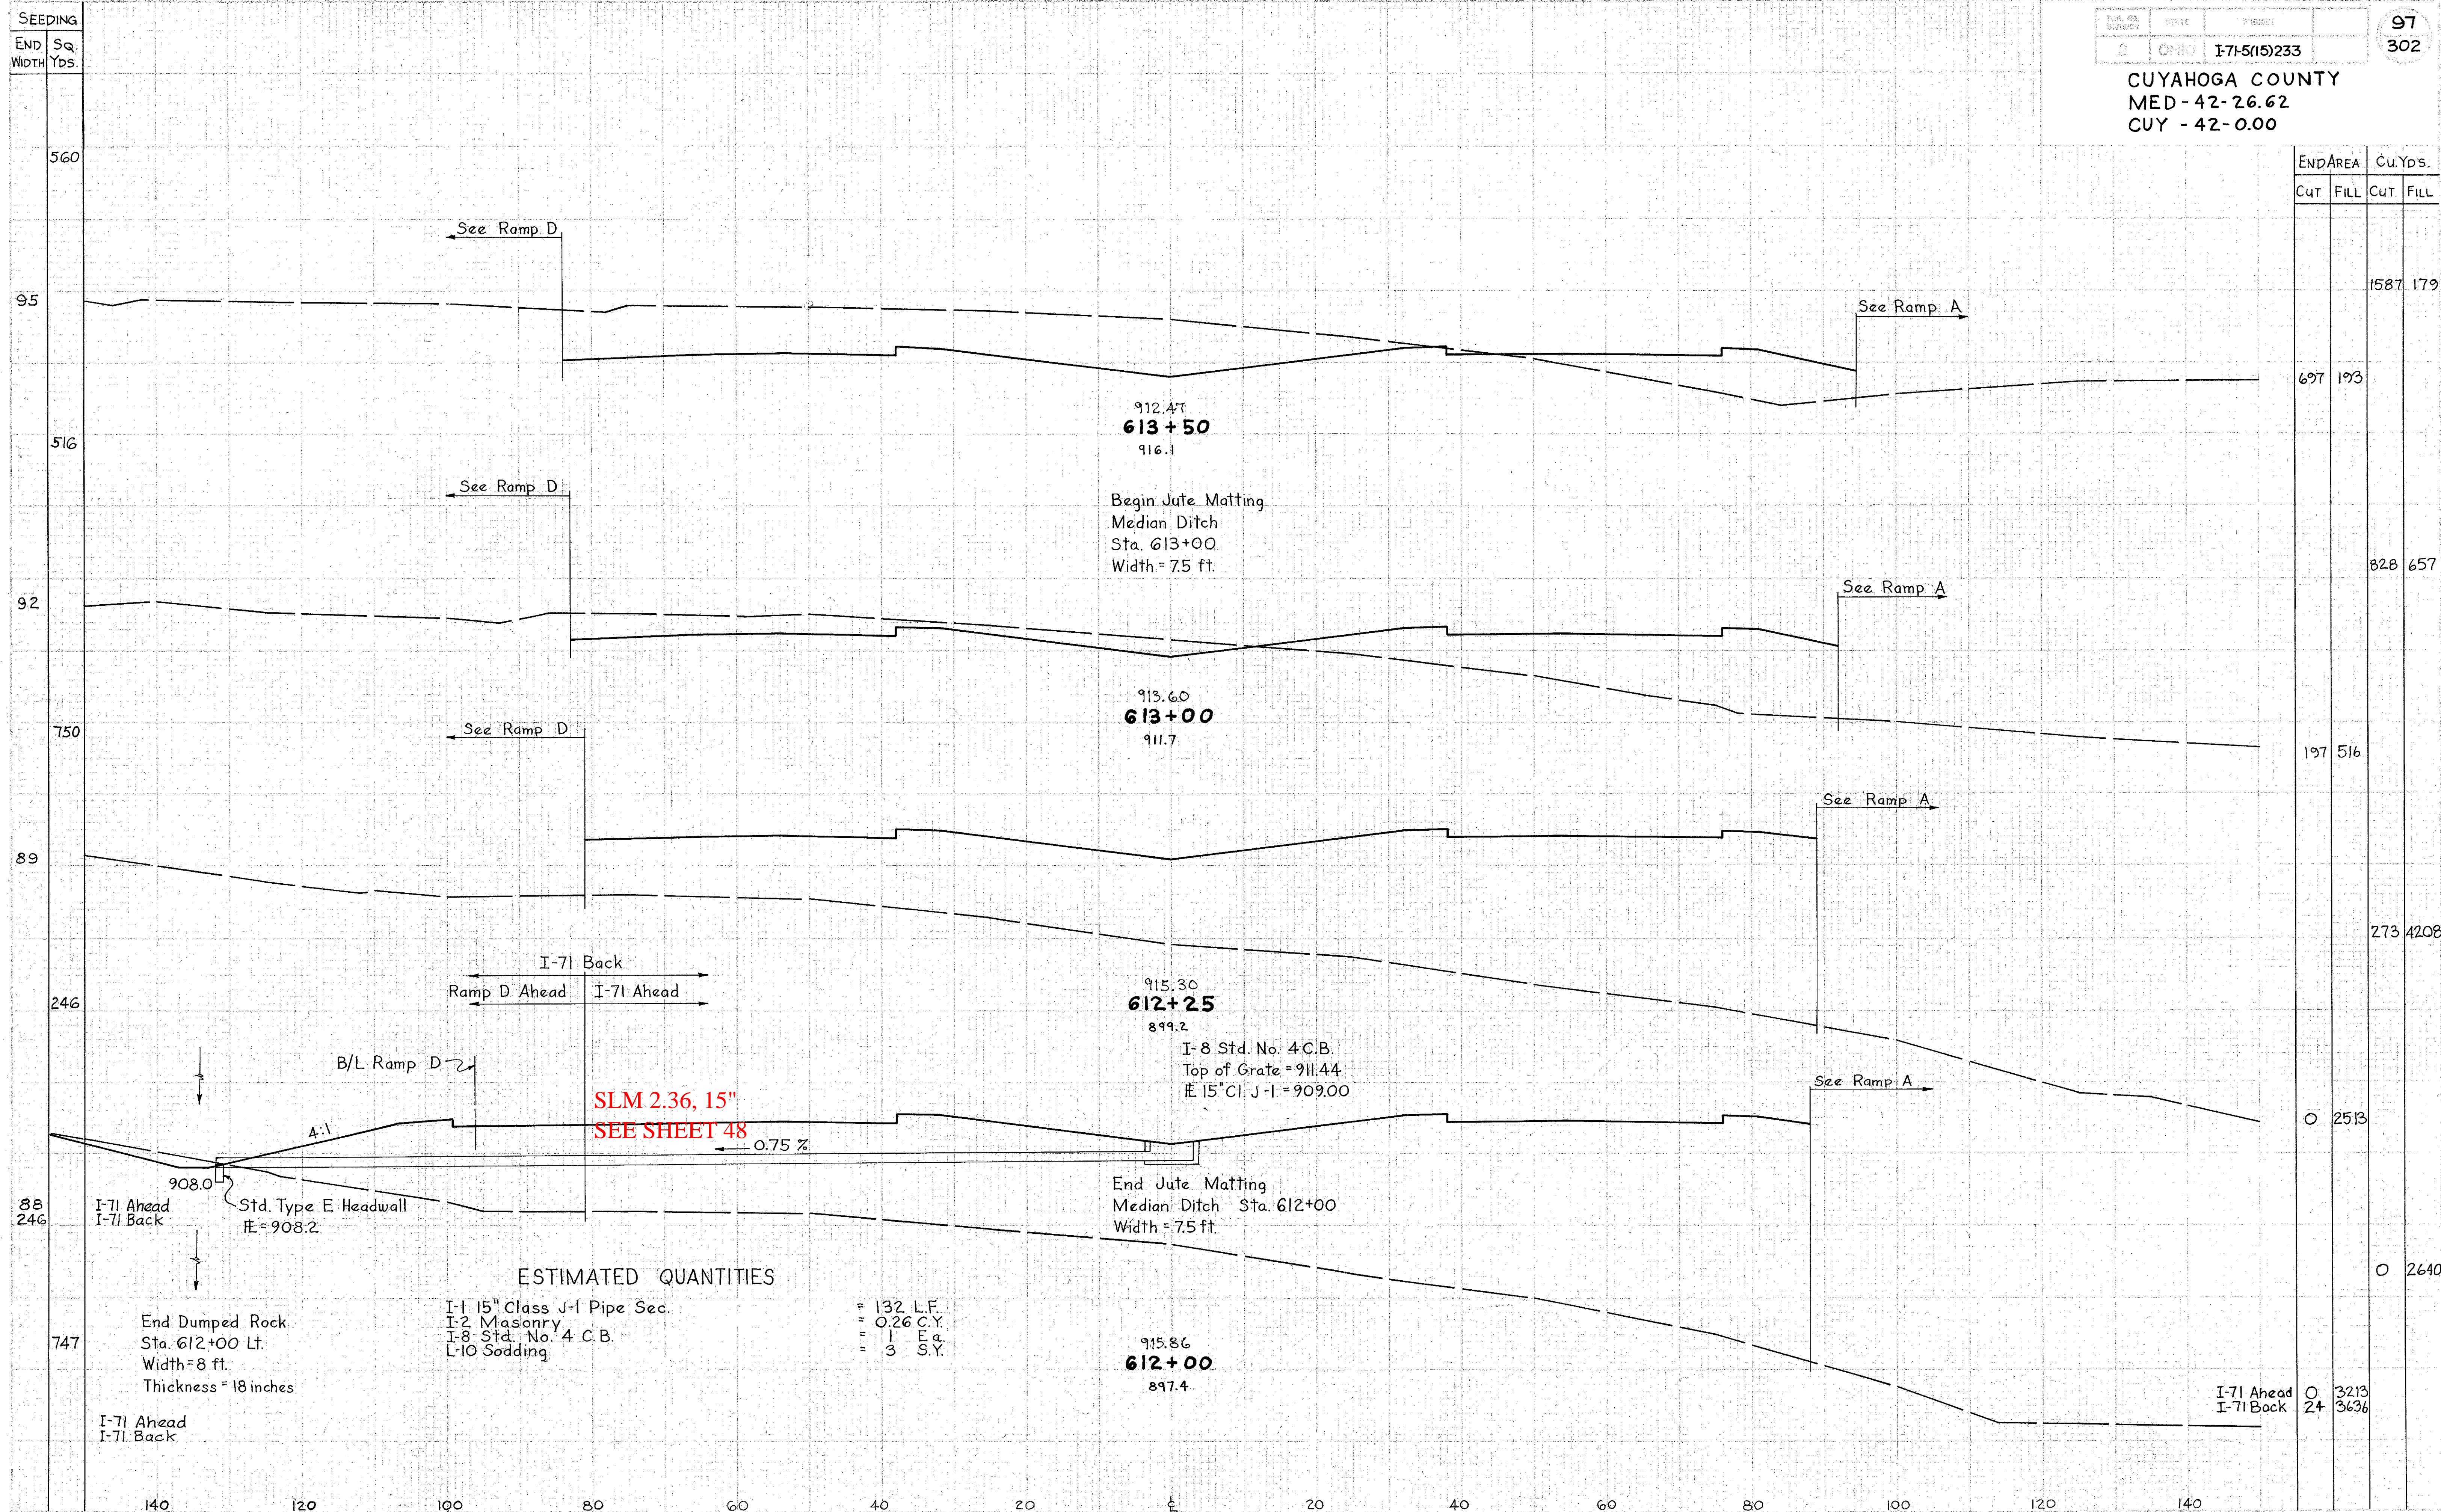

Sta. 612+00 to 613+50