

BRIDGE
SFN 1810003

LOT-36 LIMITED ACCESS
SCALE: 1" = 50'

FED. NO.	STATE	PROJECT
2	OHIO	I-71-5(15) 233


291
302

SOLD AS
MED/CUY-42-26.17/0.00

CUYAHOGA COUNTY
MED-42-26.63
CUY-42-0.00

18
29

Match Line See Sheet No. 19 of 29

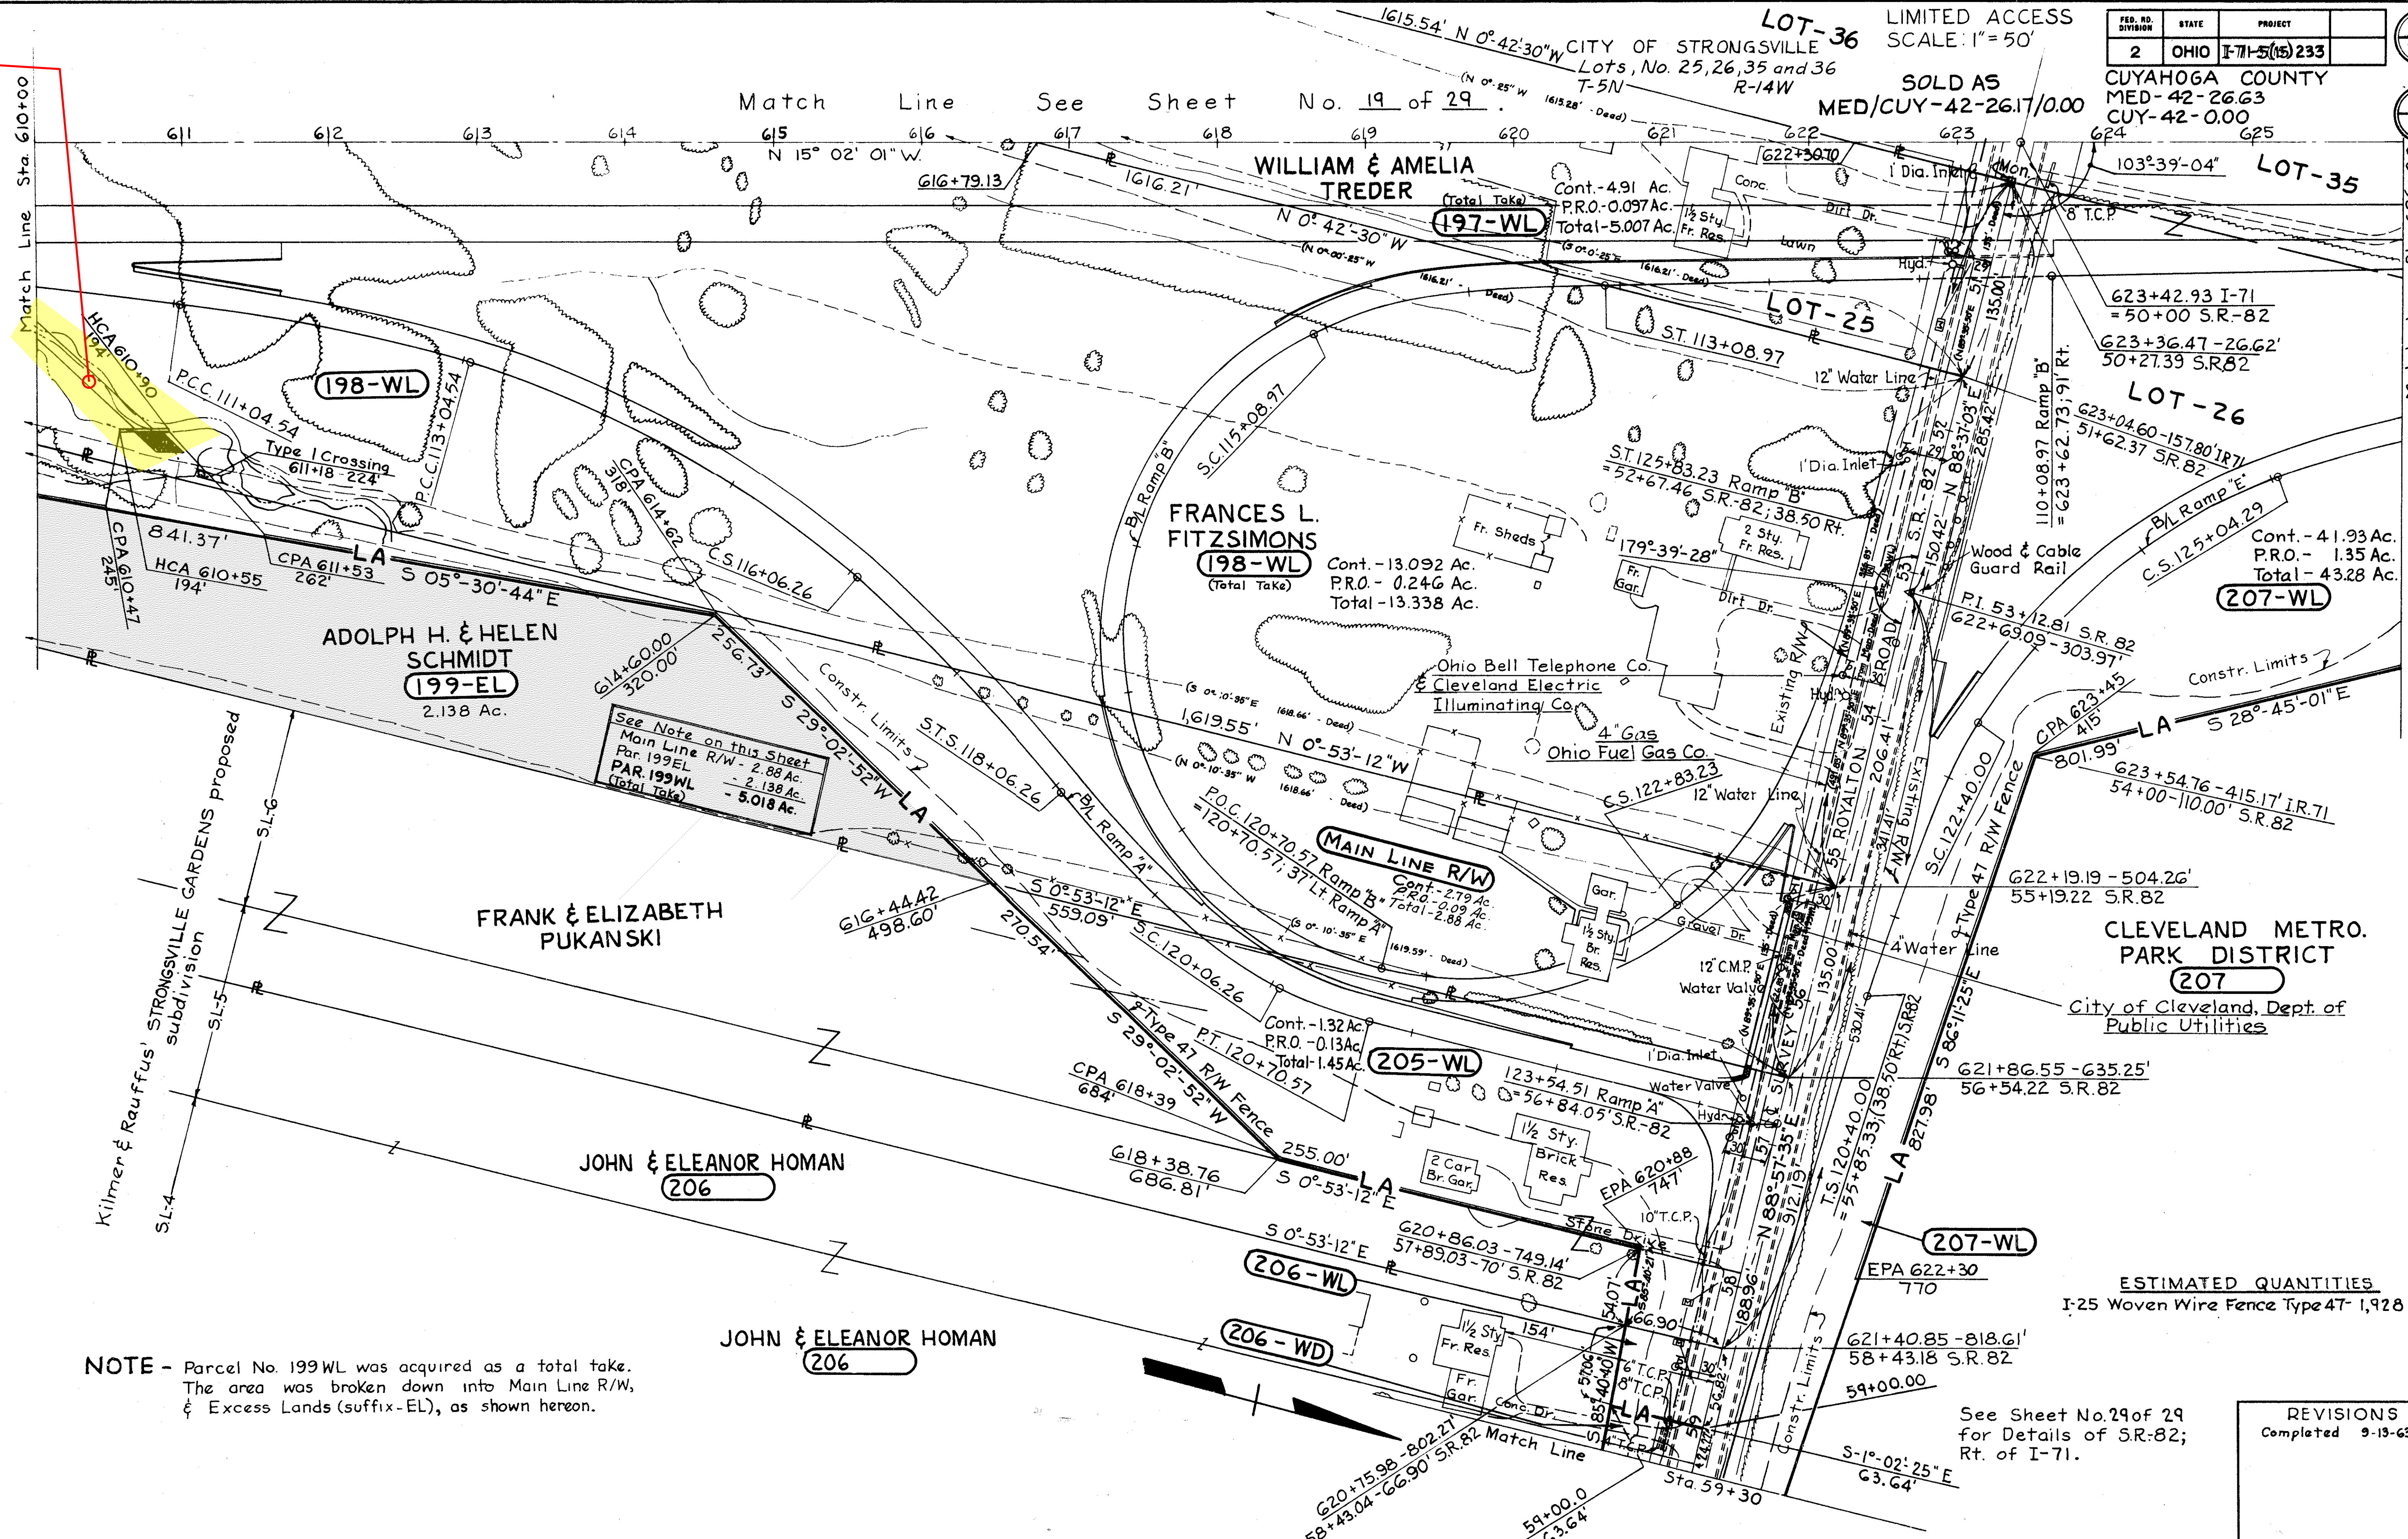

See Note on this Sheet
Main Line R/W - 2.88 Ac.
Par. 199EL - 2.138 Ac.
PAR. 199WL (Total Take) - 5.018 Ac.

NOTE - Parcel No. 199WL was acquired as a total take. The area was broken down into Main Line R/W, & Excess Lands (suffix-EL), as shown hereon.

ESTIMATED QUANTITIES
I-25 Woven Wire Fence Type 47-1,928 Ft.

See Sheet No. 29 of 29
for Details of S.R.-82;
Rt. of I-71.

REVISIONS
Completed 9-13-63