SEE 1963 CUY-71-0.00 PLANS
FOR ORIGINAL CONSTRUCTION
OF STORM SEWERS

CUY-71-0.00	OHIO	90
	FHWA REGION 5	361
	FEDERAL PROJECT	

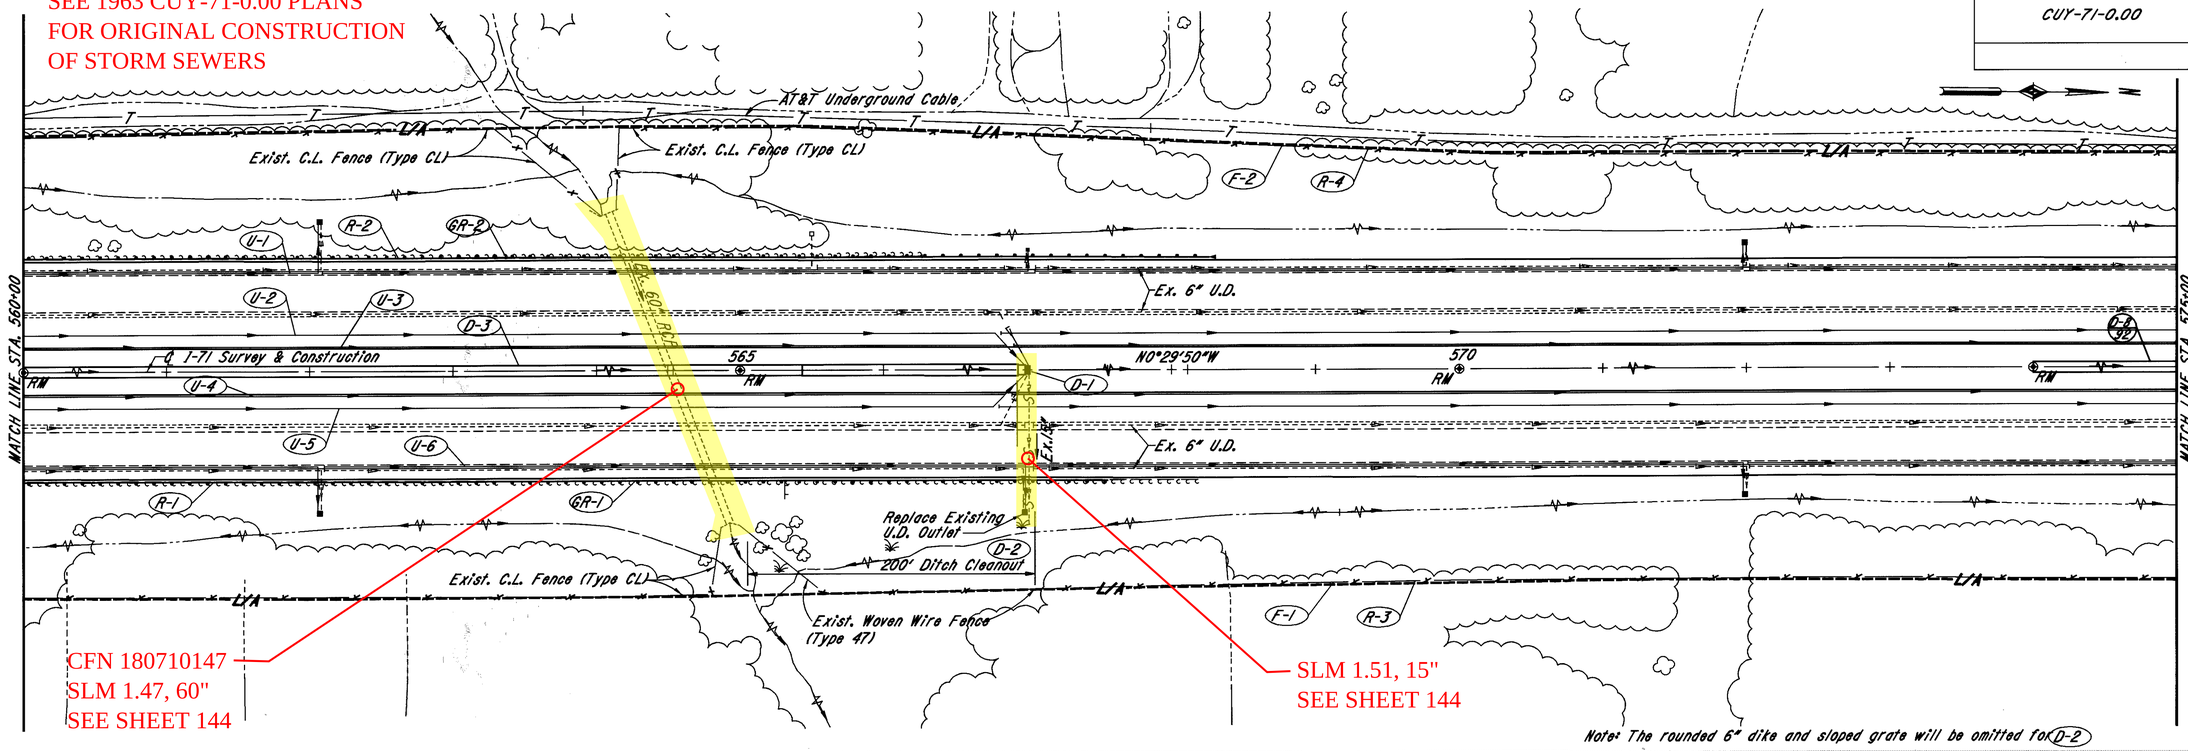

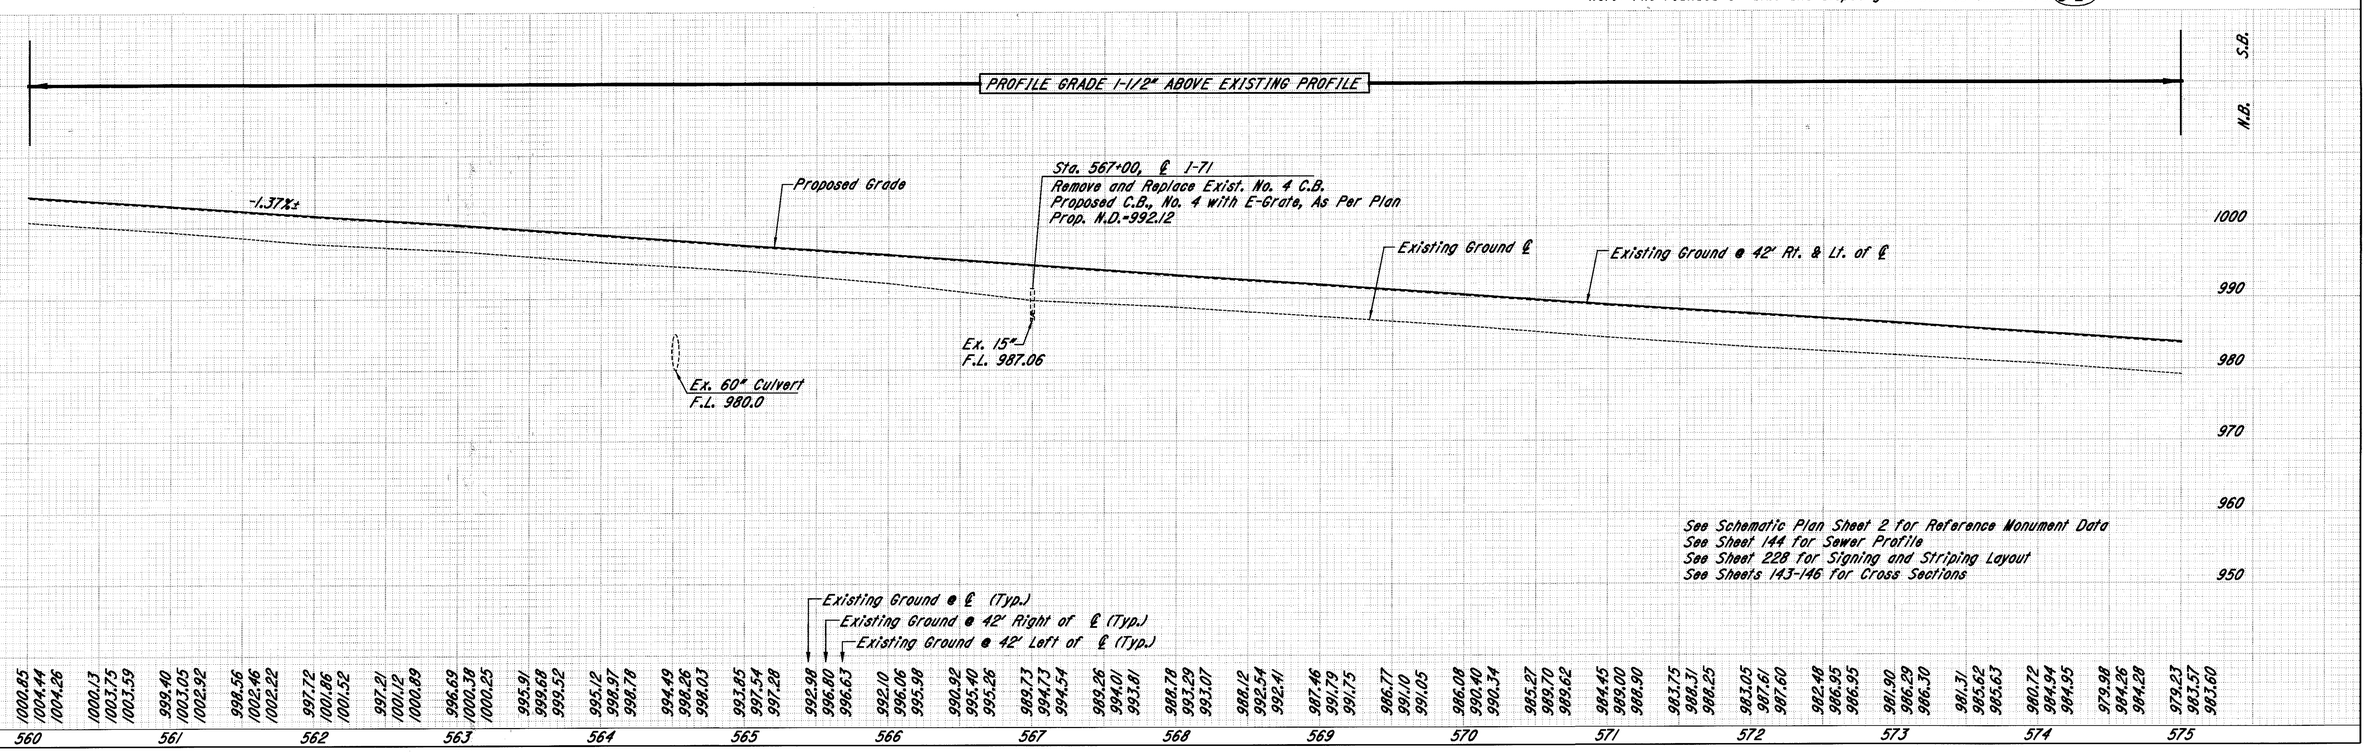

I-71 PLAN & PROFILE STA. 560+00 TO STA. 575+00

PLOTTED BY: fkonopka
PLOTTED: 04-AUG-1998 11:58
PLOT SUBMITTED: 04-AUG-1998 11:58
307pp06.dgn