SEE 1963 ~~CUY 71 0.00 PLANS~~
FOR ORIGINAL CONSTRUCTION
OF STORM SEWERS

CUY-71-0.00	OHIO	94 / 361
	FHWA REGION 5	
	FEDERAL PROJECT	

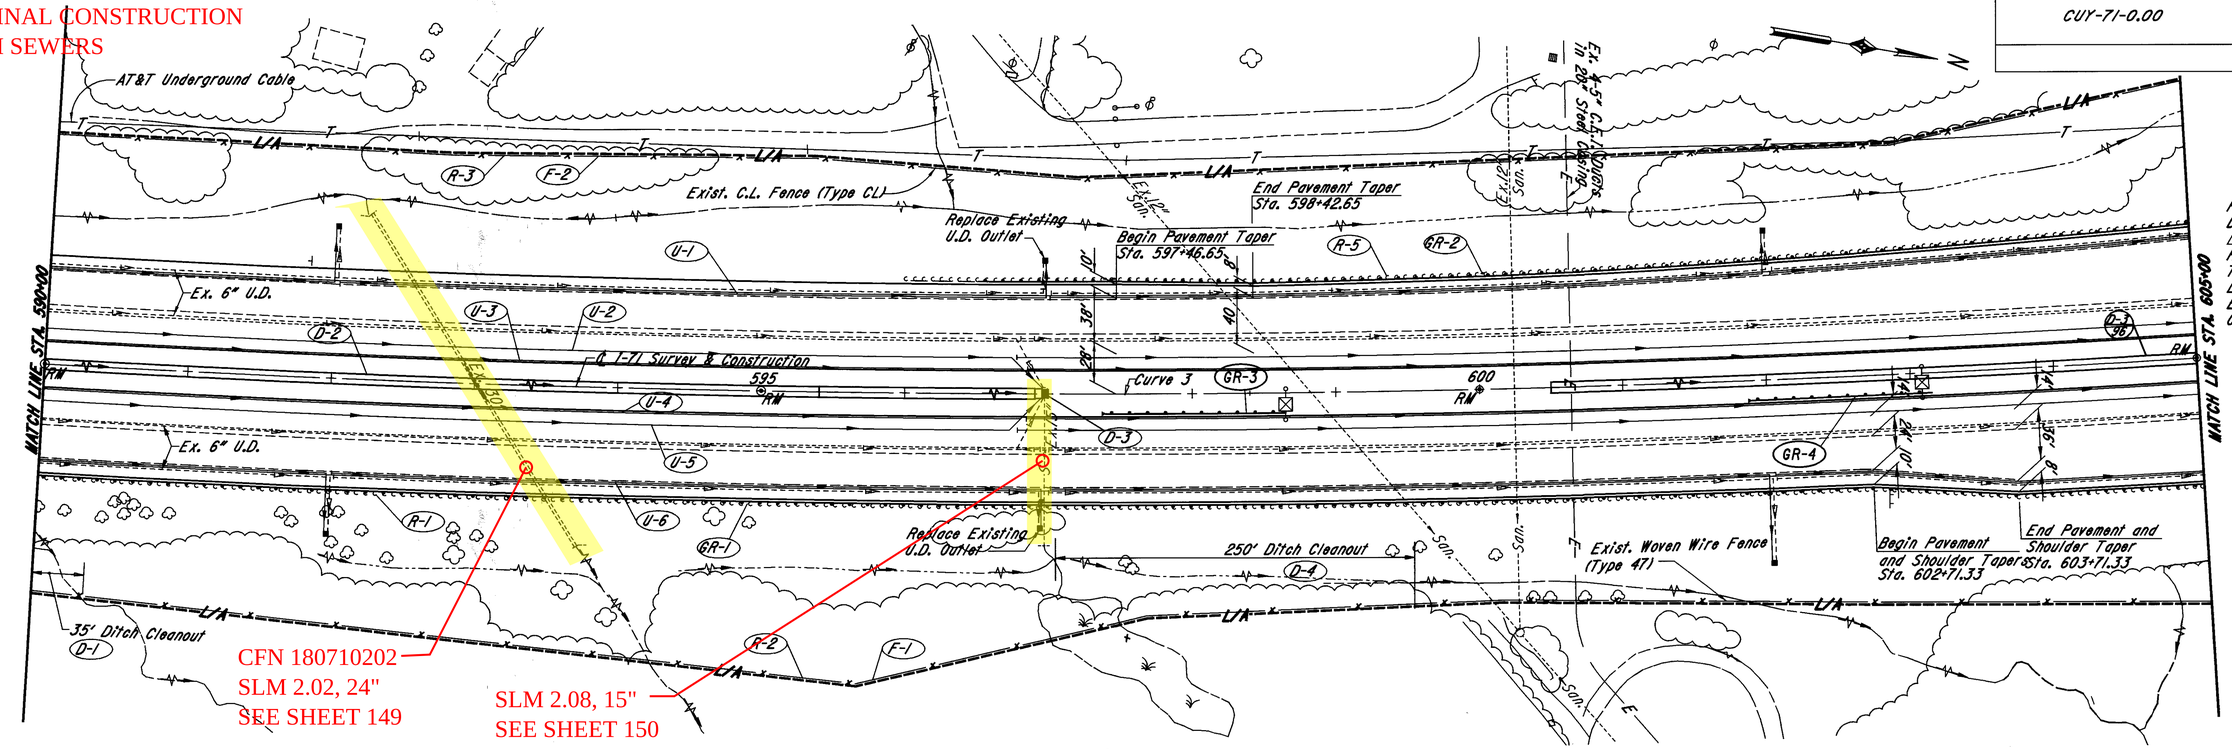

Curve 3 Data
P.I. Sta. 593+34.87
Dc = 0°28'00"
△ = 14°32'11"
R = 12277.67'
T = 1565.88'
L = 3114.94'
E = 99.45'
Ch = 3106.59'

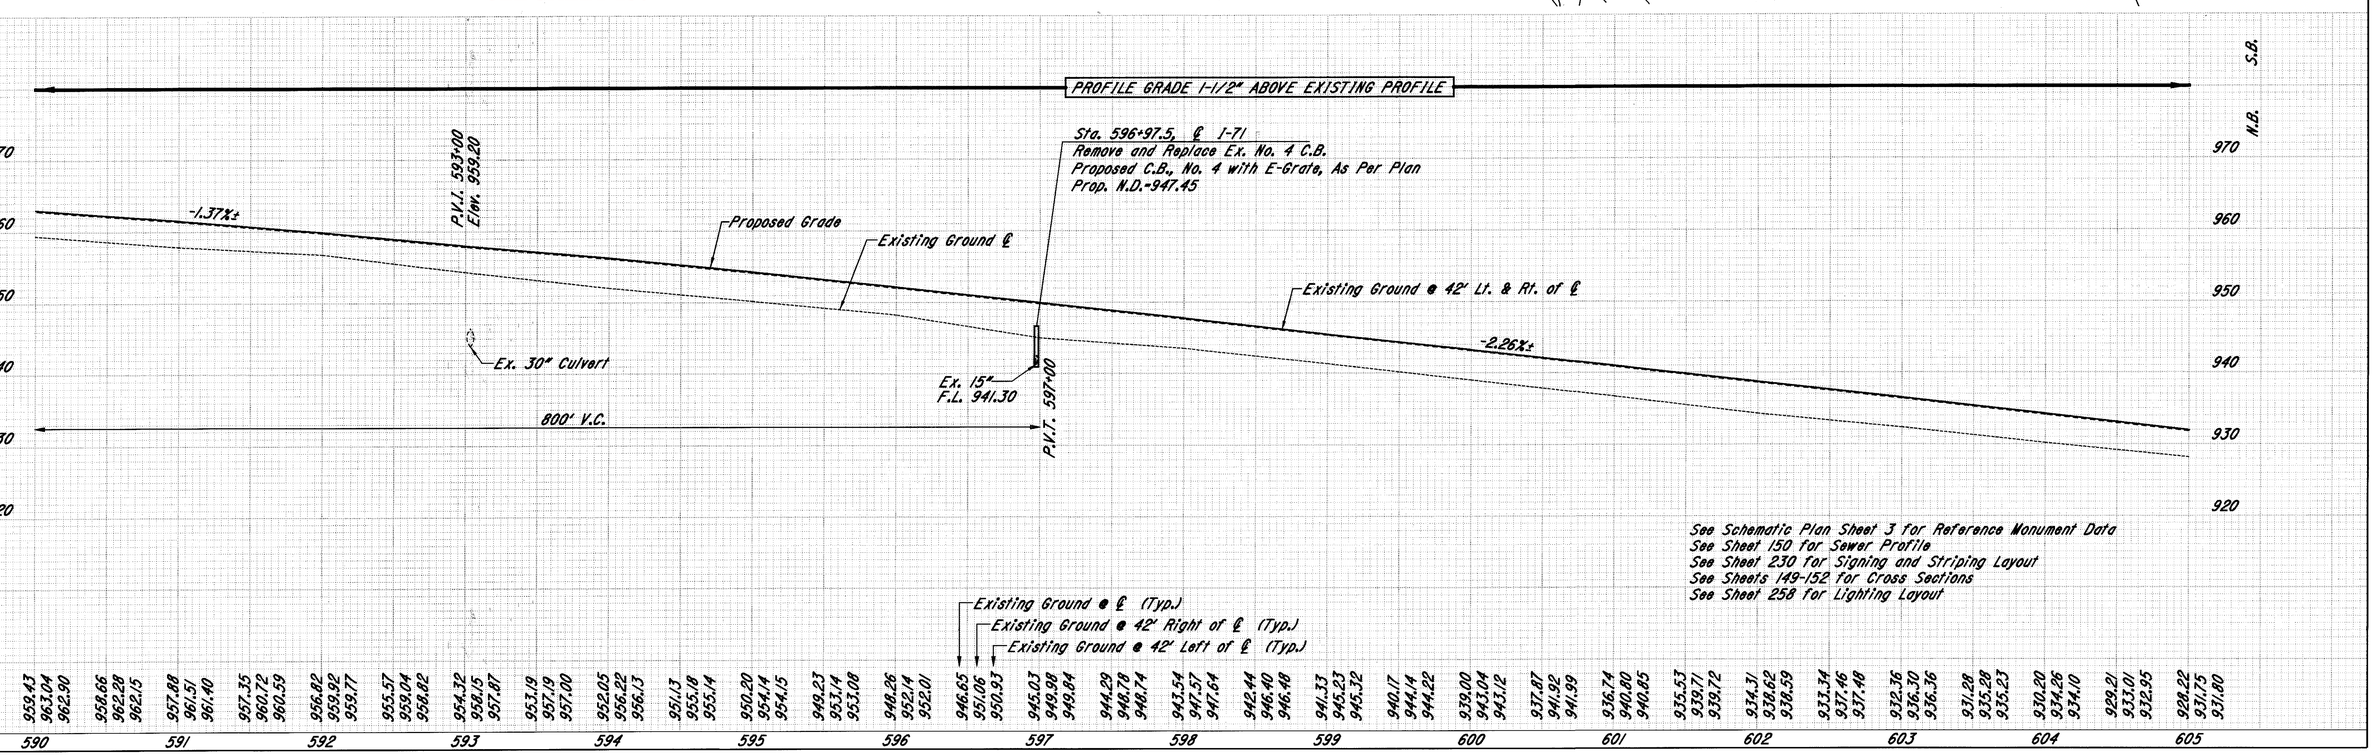

I-71 PLAN & PROFILE STA. 590+00 TO STA. 605+00

PLOTTED BY: fkonopka
PLOTTED: 11:59 04-AUG-1998
PLOT SUBMITTED: 04-AUG-1998 11:59
307pp08.dgn