SLM 2.62, 15"
SEE BELOW

REMOVED

SLM 2.56, 18"

SLM 2.57, 21"
SEE SHEET 155

SLM 2.57, 15"
SEE SHEET XX

SLM 2.65, 27"
SEE BELOW

SLM 2.67, 27"
SEE SHEET 156

SLM 2.74, 30"

SLM 2.57, 21"
SEE BELOW

SLM 2.57, 18"

SLM 2.57, 24"

SLM 2.74, 30"

SR 82
SLM 2.57 = MM 231.28

SEE 1963 CUY-71-0.00 PLANS
FOR ORIGINAL CONSTRUCTION
OF STORM SEWERS

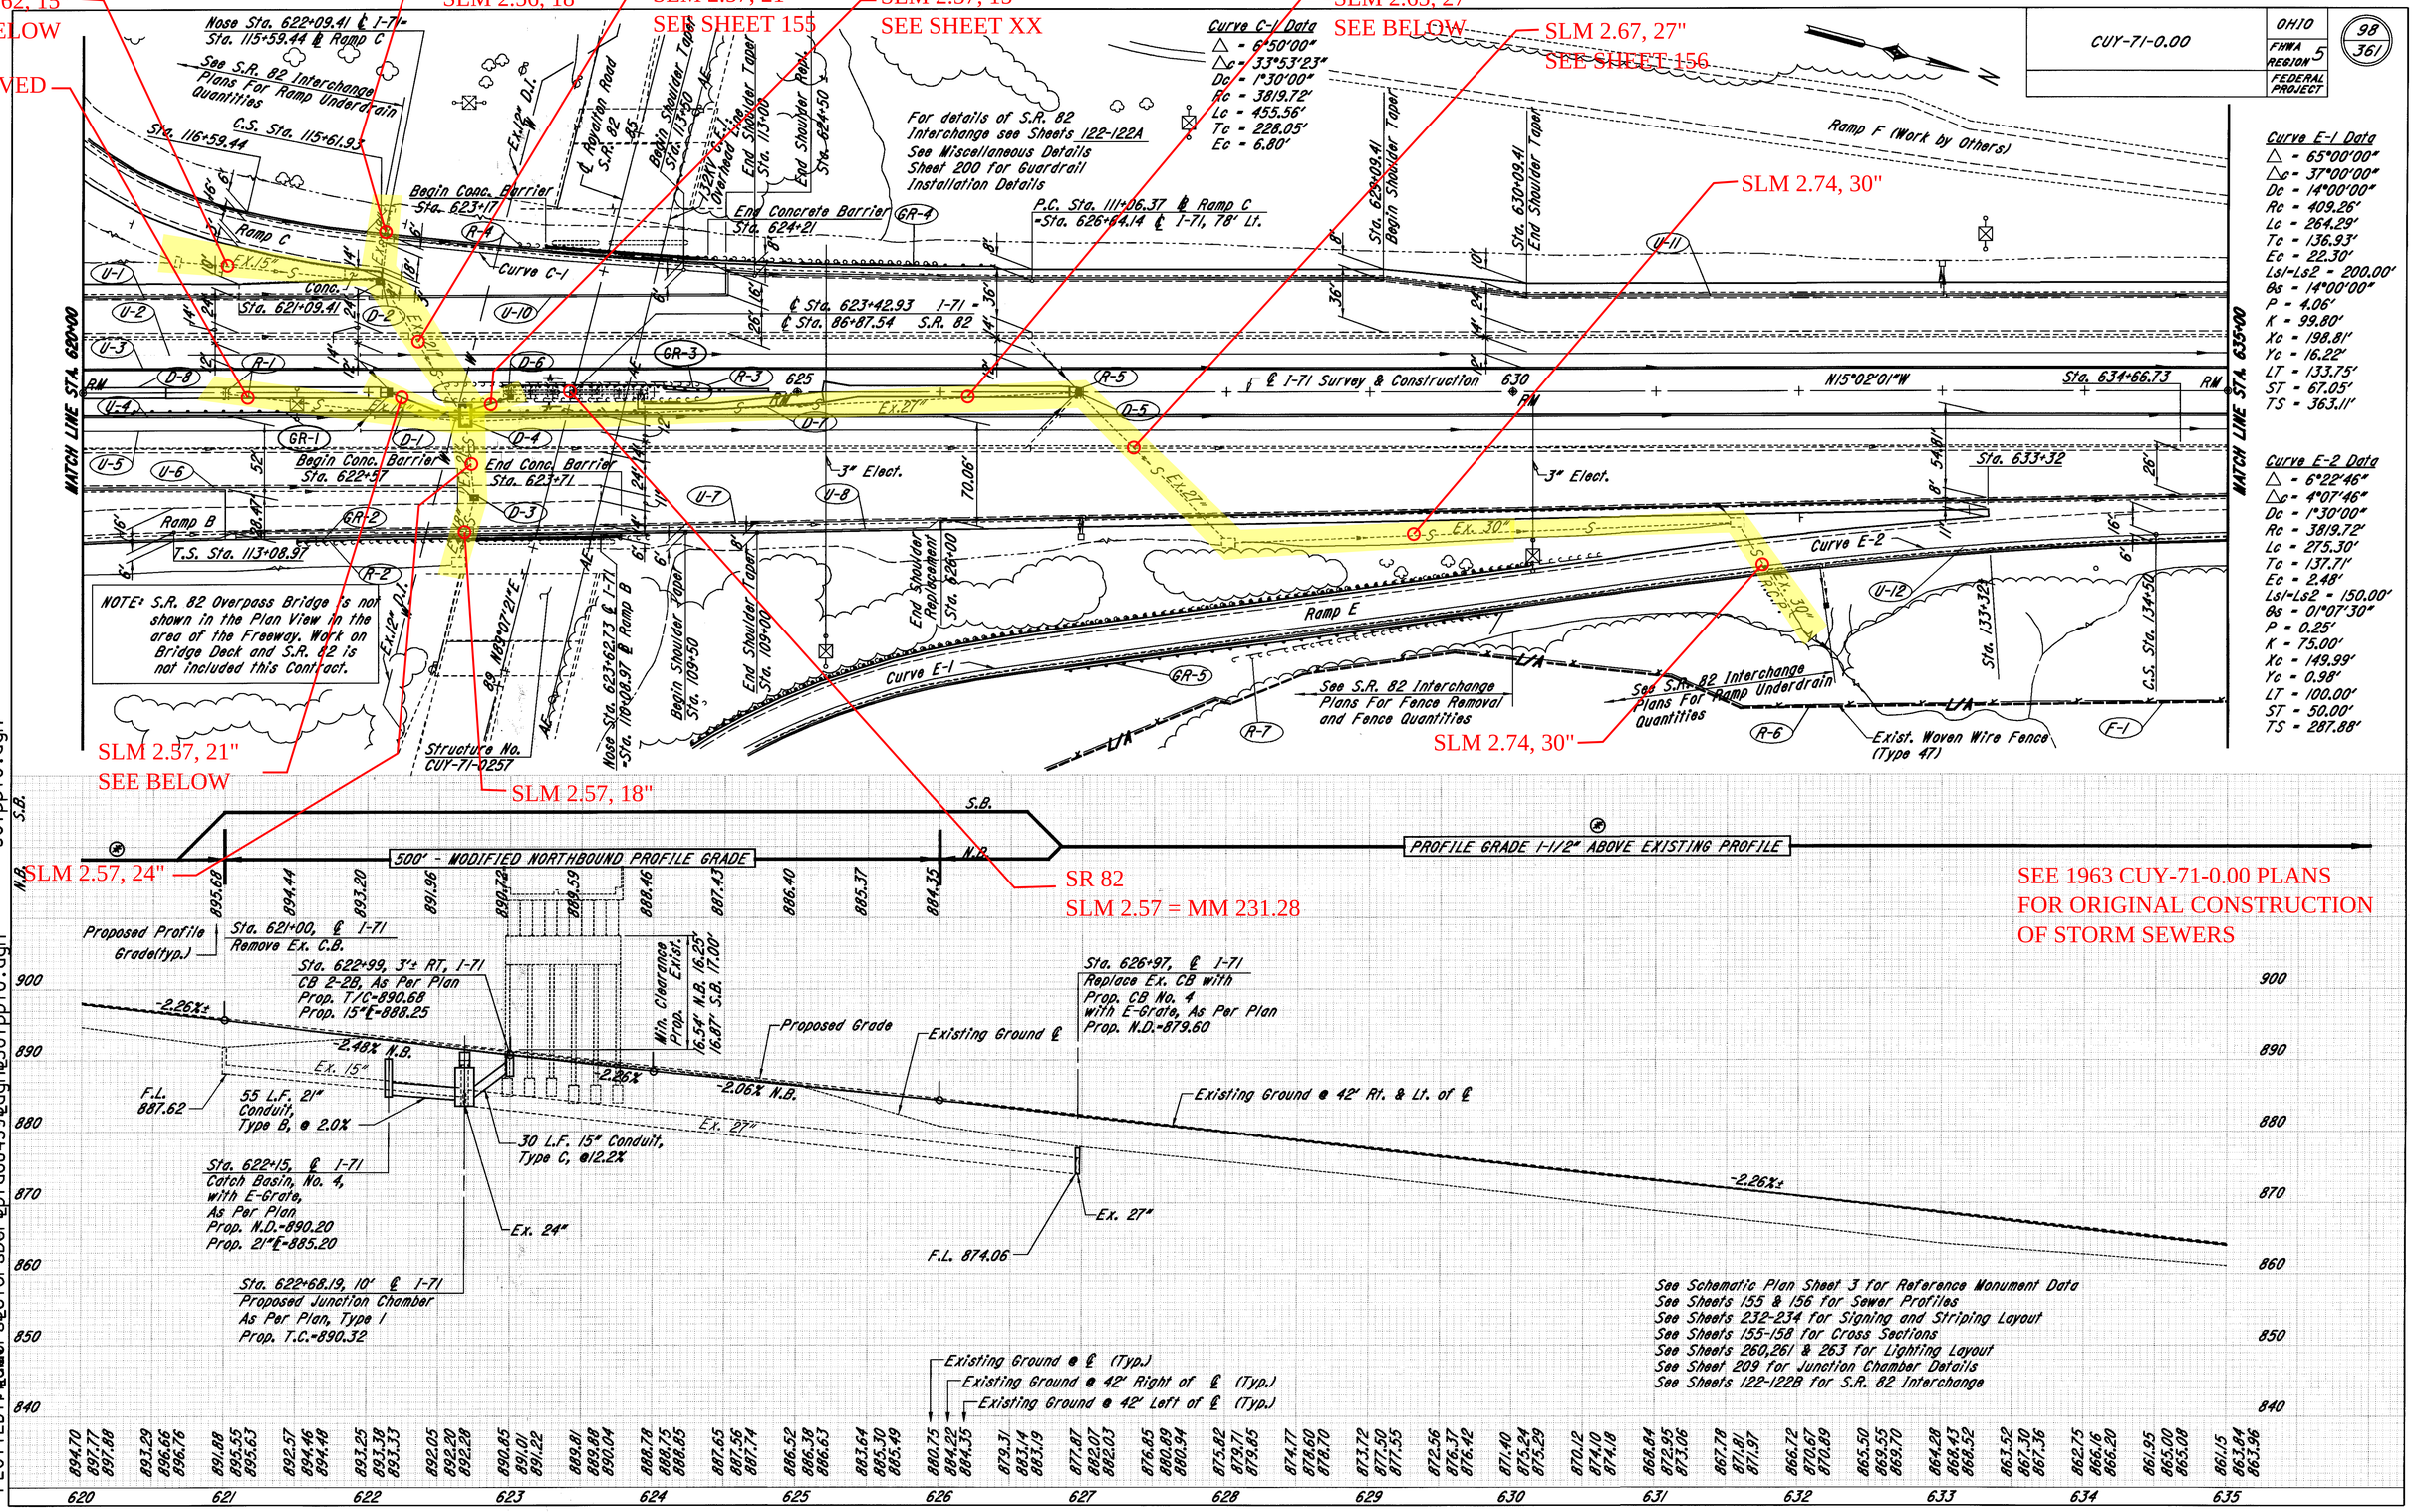

PLOTTED BY: fkonopka
PLOTTED: FROM: 307pp10.dgn
PLOT SUBMITTED: 04-AUG-1998 12:01