VALLEY PARKWAY
SLM 3.32 = MM 232.03

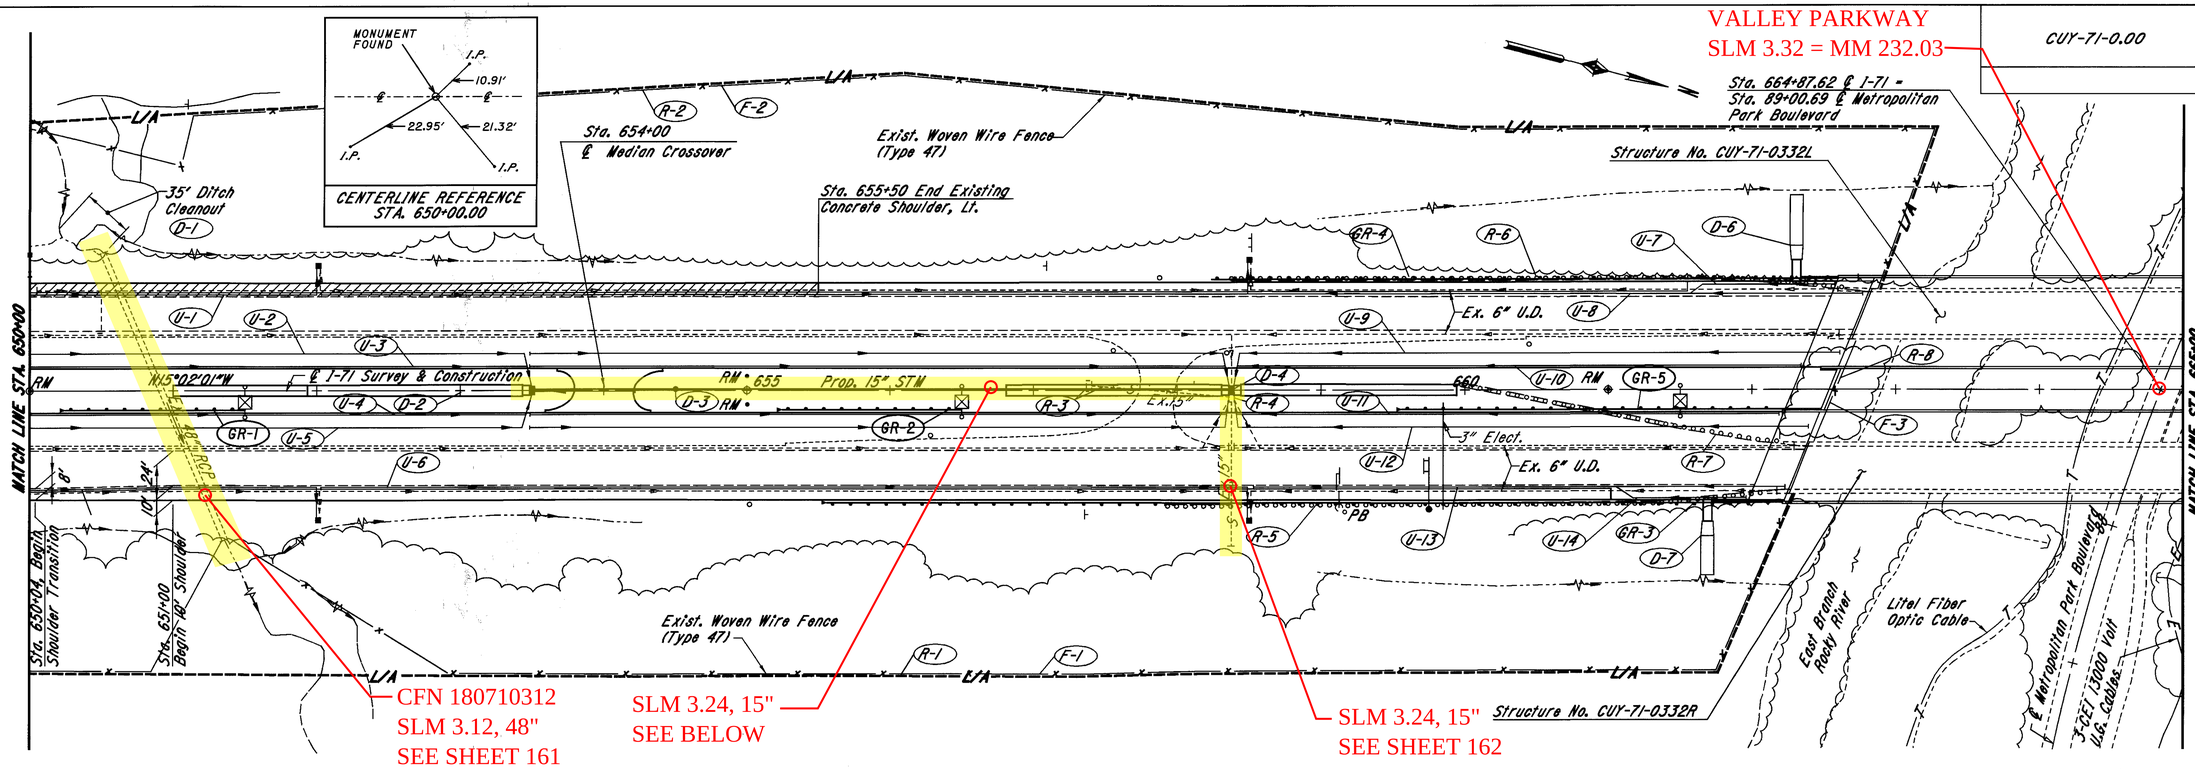

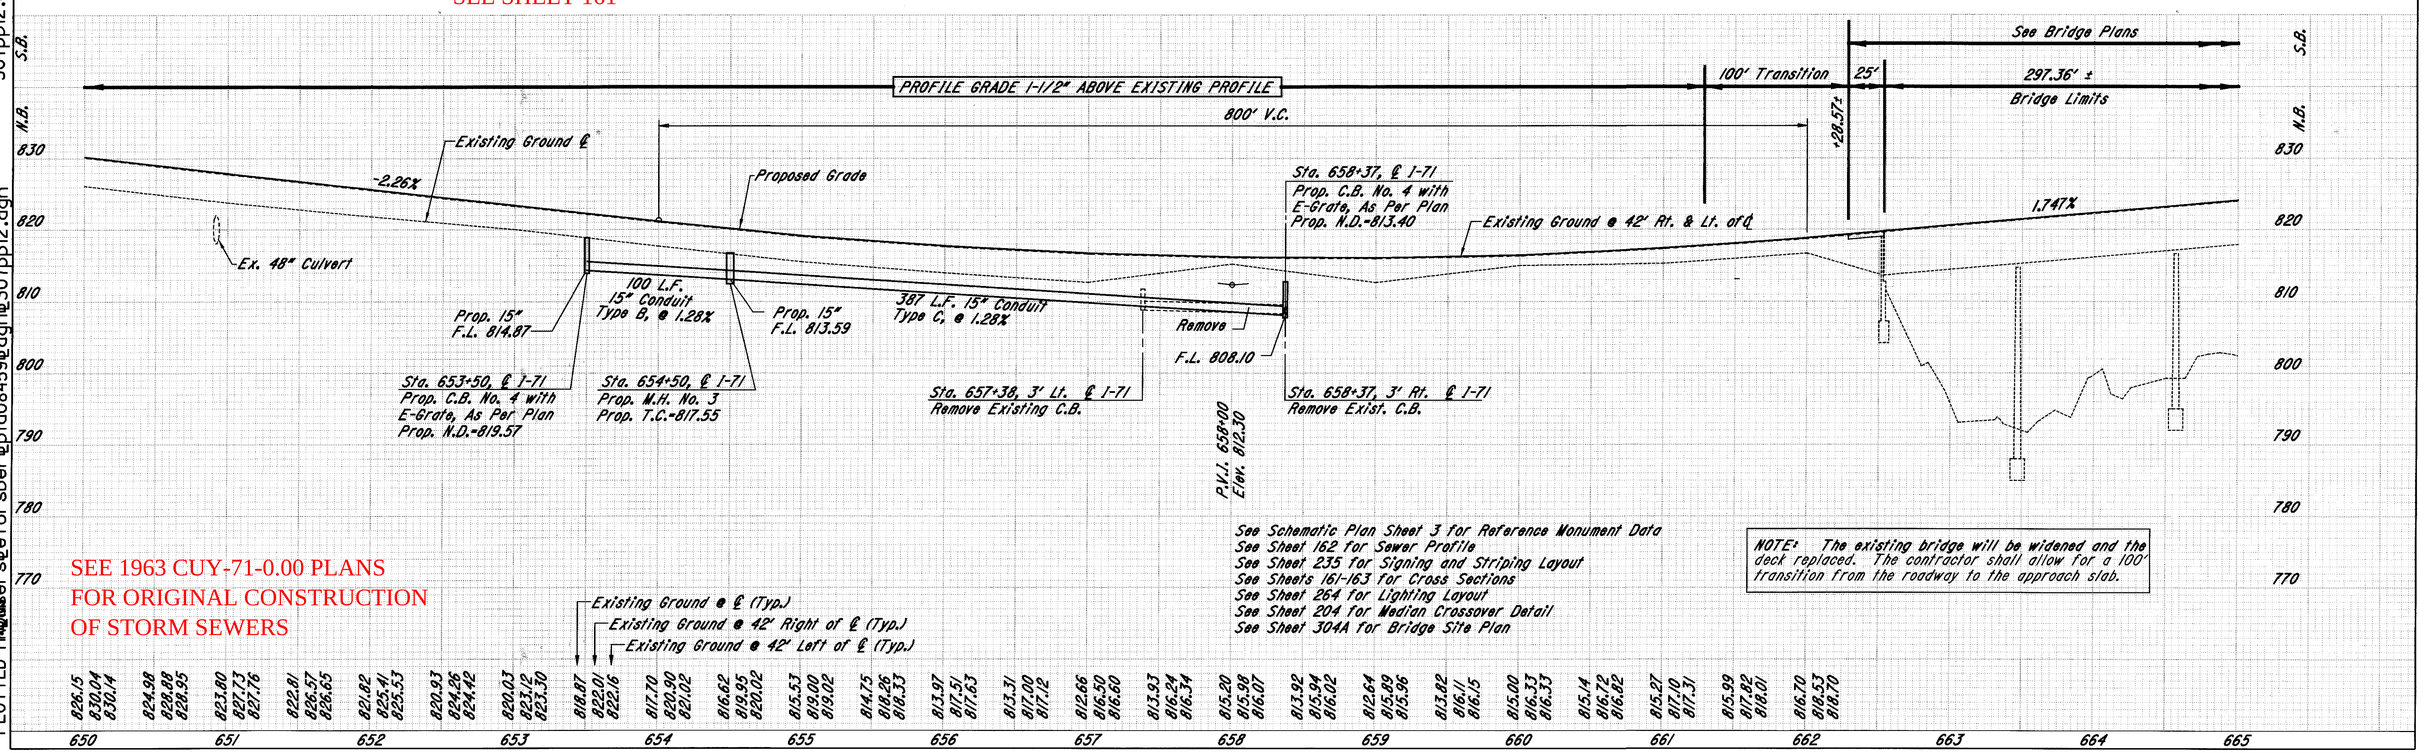

SEE 1963 CUY-71-0.00 PLANS
FOR ORIGINAL CONSTRUCTION
OF STORM SEWERS

See Schematic Plan Sheet 3 for Reference Monument Data
See Sheet 162 for Sewer Profile
See Sheet 235 for Signing and Striping Layout
See Sheets 161-163 for Cross Sections
See Sheet 264 for Lighting Layout
See Sheet 204 for Median Crossover Detail
See Sheet 304A for Bridge Site Plan

NOTE: The existing bridge will be widened and the deck replaced. The contractor shall allow for a 100' transition from the roadway to the approach slab.

Existing Ground @ ℄ (Typ.)
Existing Ground @ 42' Right of ℄ (Typ.)
Existing Ground @ 42' Left of ℄ (Typ.)

I-71 PLAN & PROFILE STA. 650+00 TO STA. 665+00

PLOTTED BY: fkonopka
PLOTTED FROM: 307pp12.dgn
PLOT SUBMITTED: 05-AUG-1998 11:45