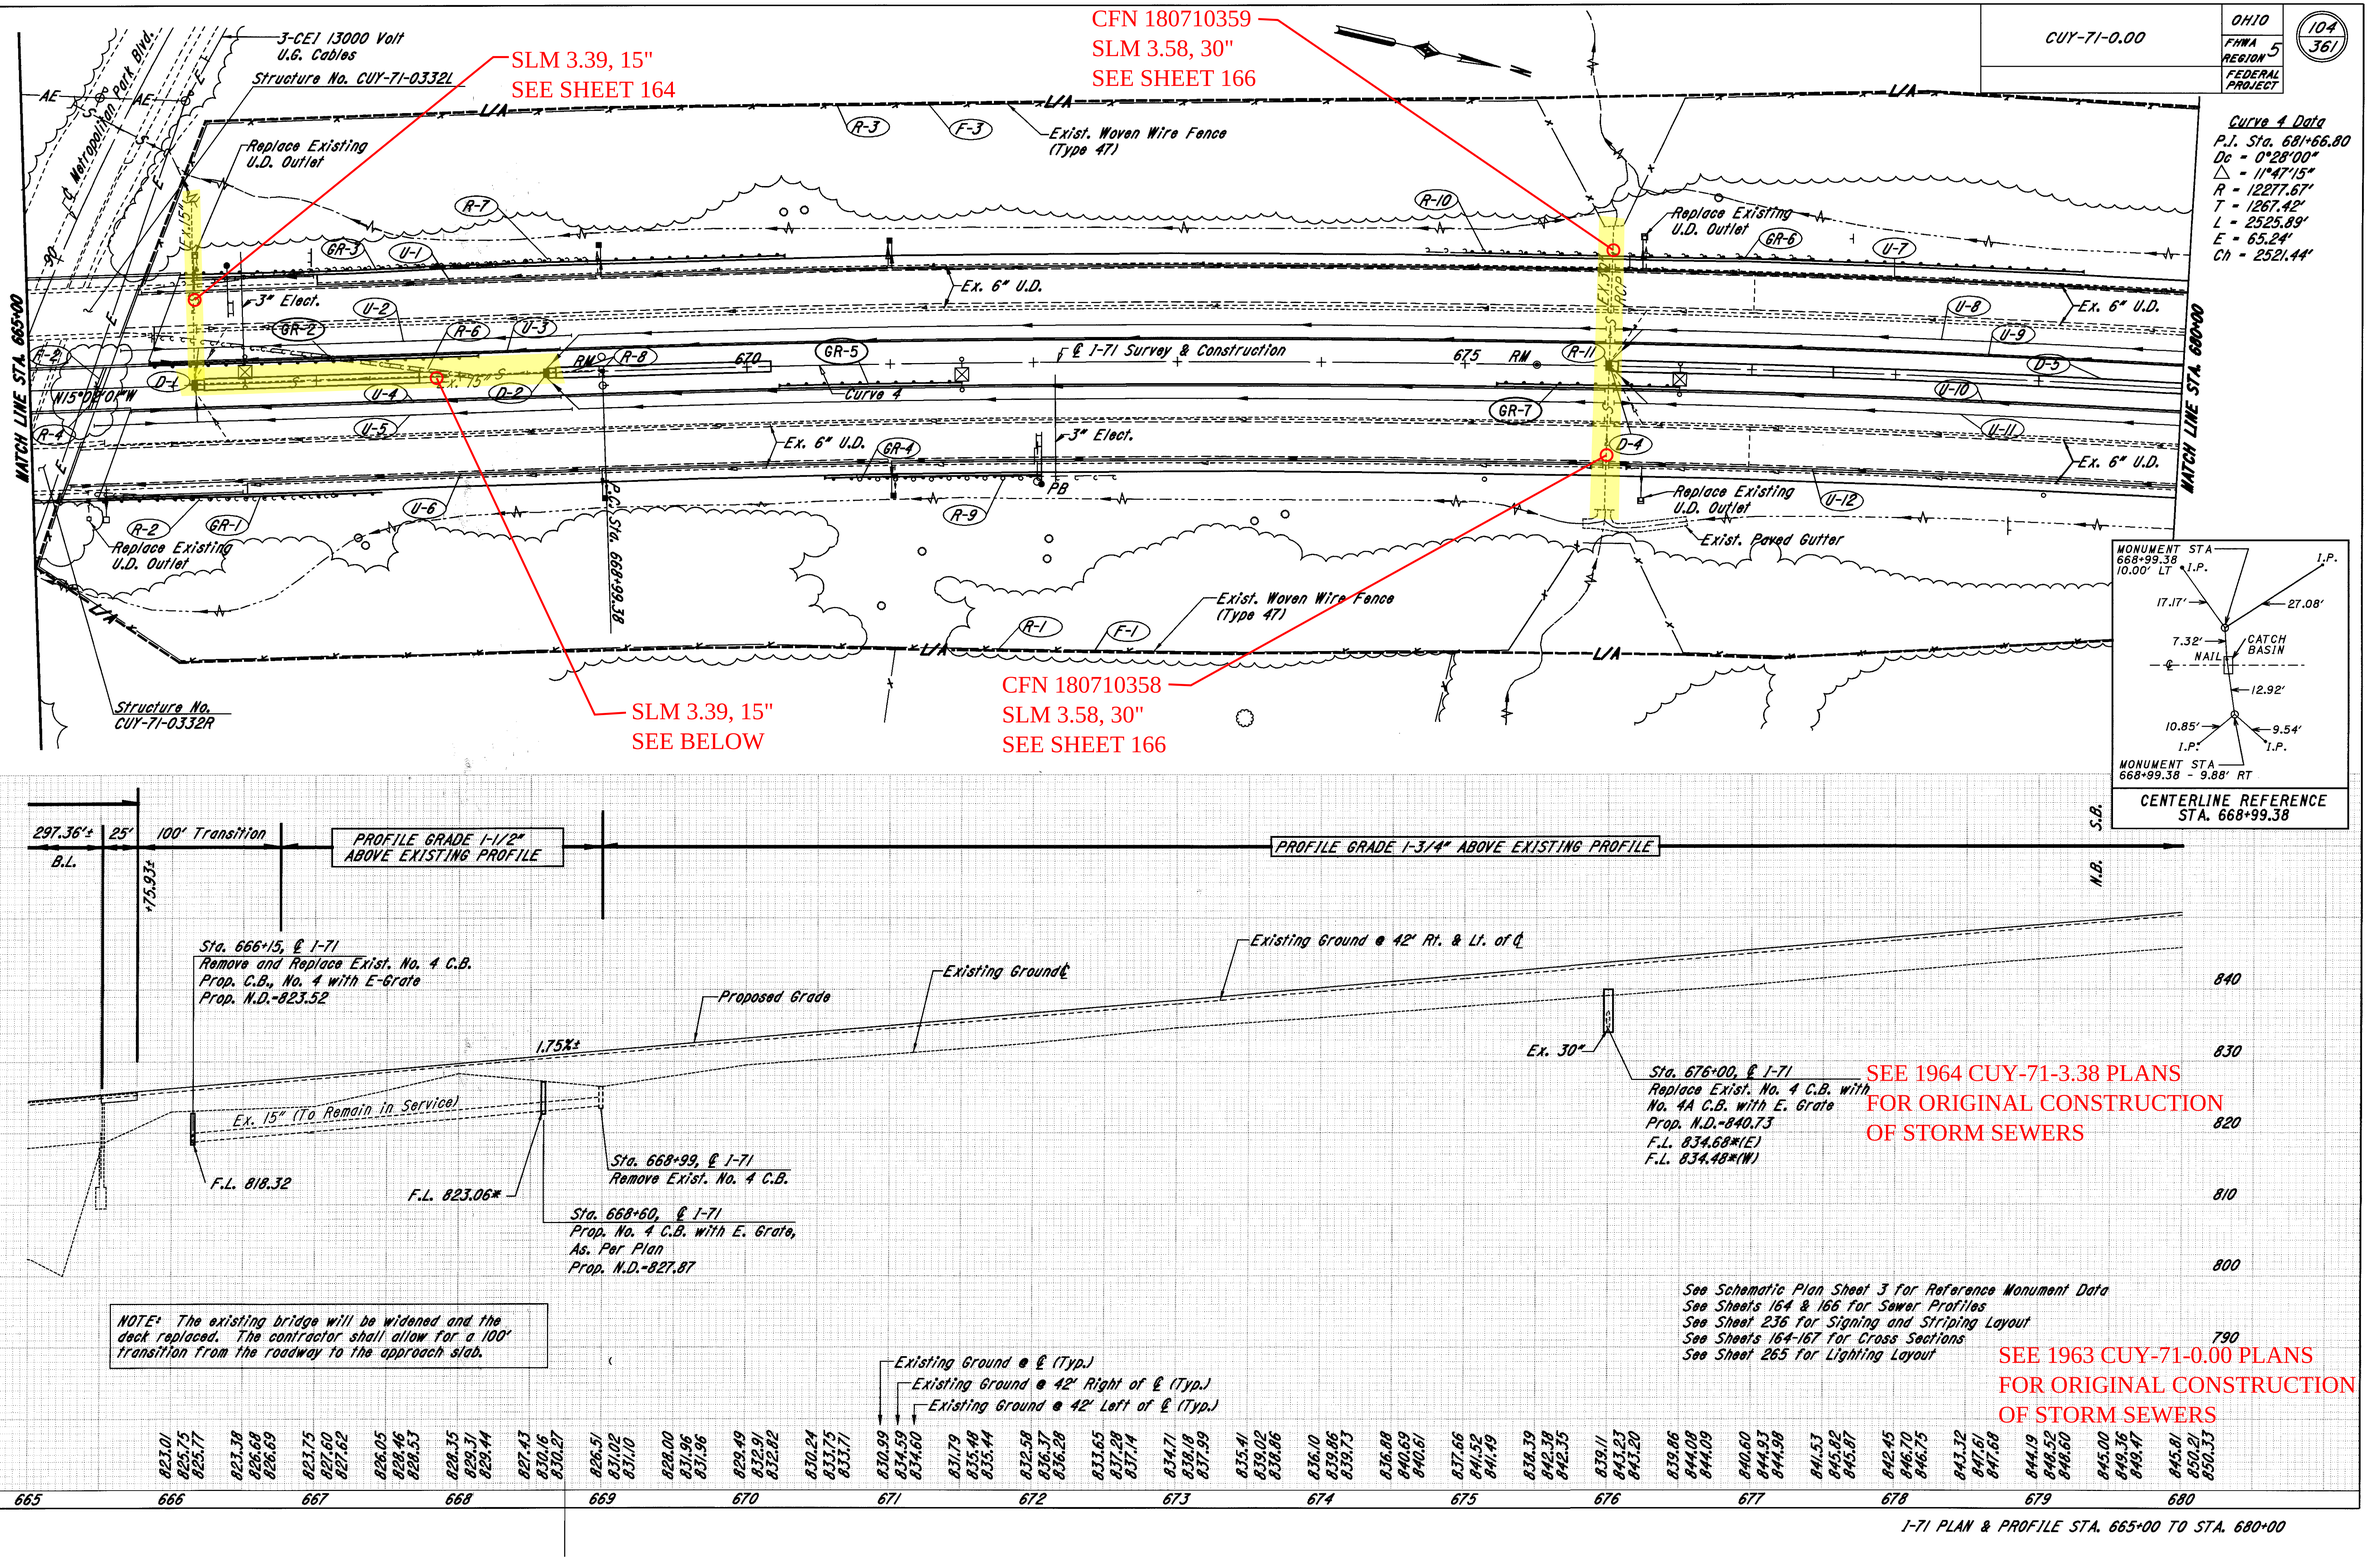

PLOTTED BY: fkonopka
PLOTTED FROM: ..\user$\beforsber\pid08459\307pp13.dgn
PLOT SUBMITTED:05-AUG-1998 07:04