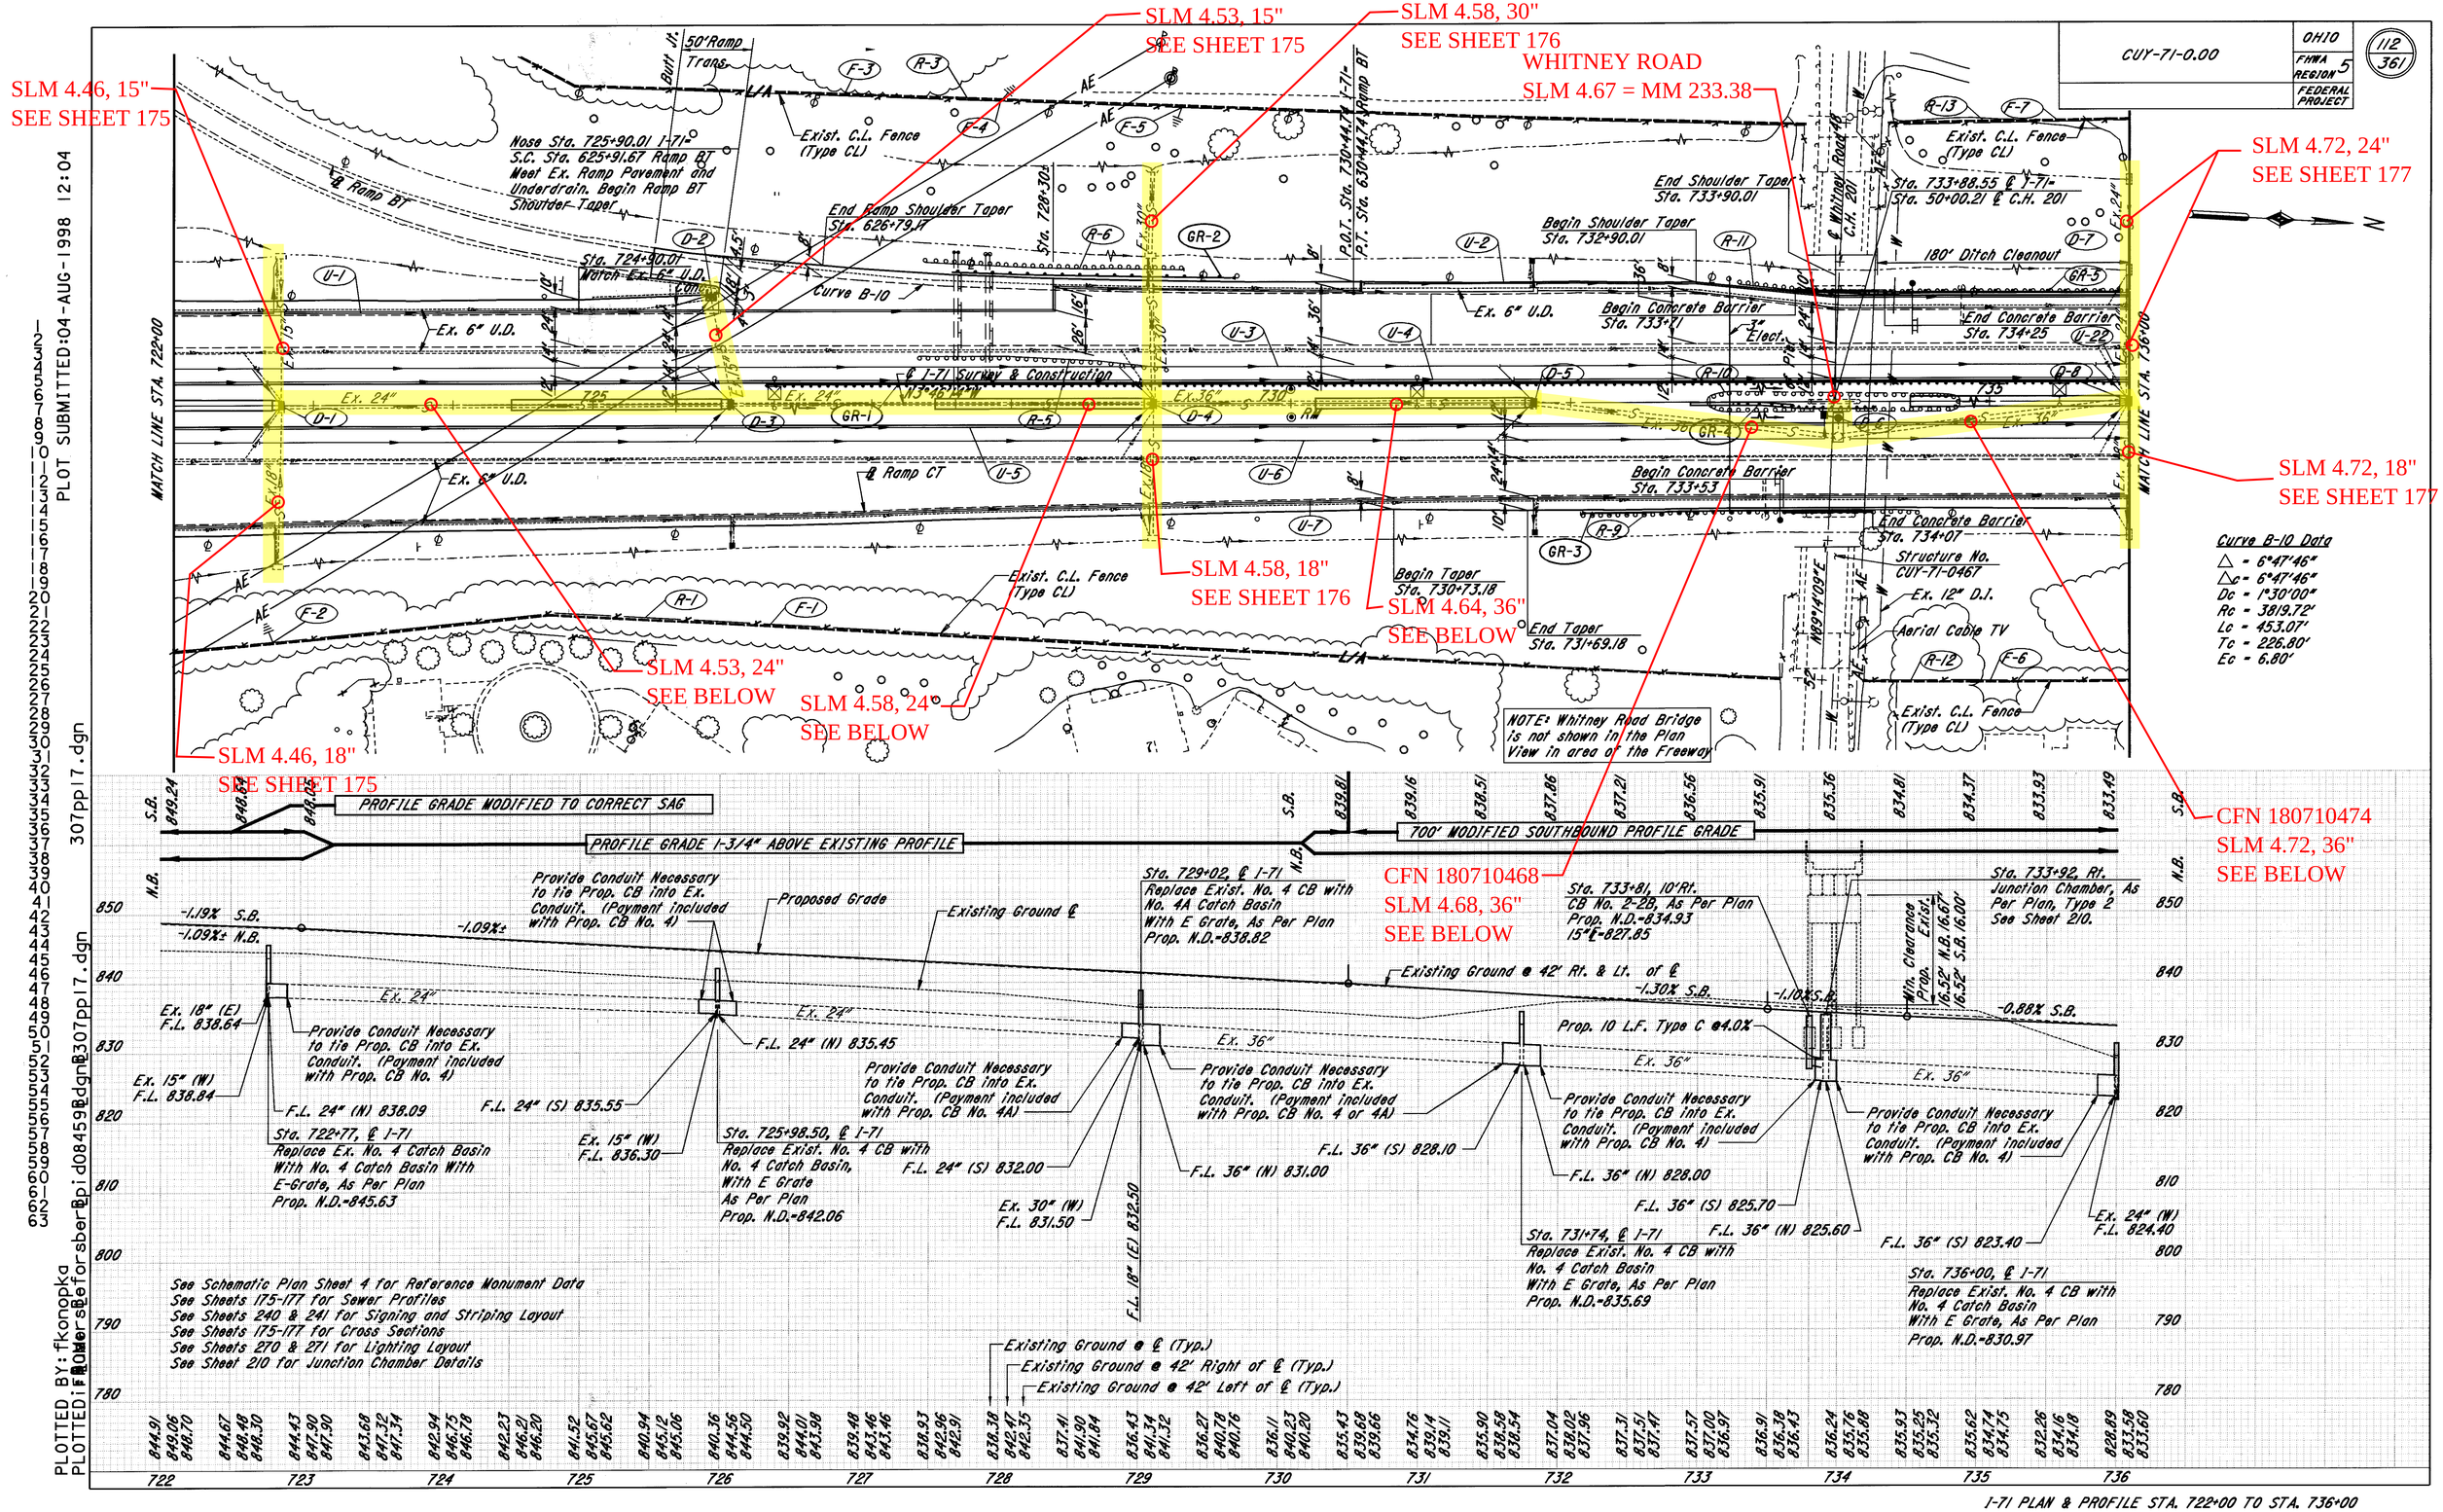

SEE 1964 CUY-71-3.38 PLANS
FOR ORIGINAL CONSTRUCTION
OF STORM SEWERS