PEARL ROAD
SLM 5.52 = MM 234.23

SLM 5.57, 15"
SEE SHEET 187

SLM 5.58, 12"
SEE SHEET 187

SLM 5.51, 15"
SEE SHEET 186

SLM 5.63, 15"
SEE SHEET 187

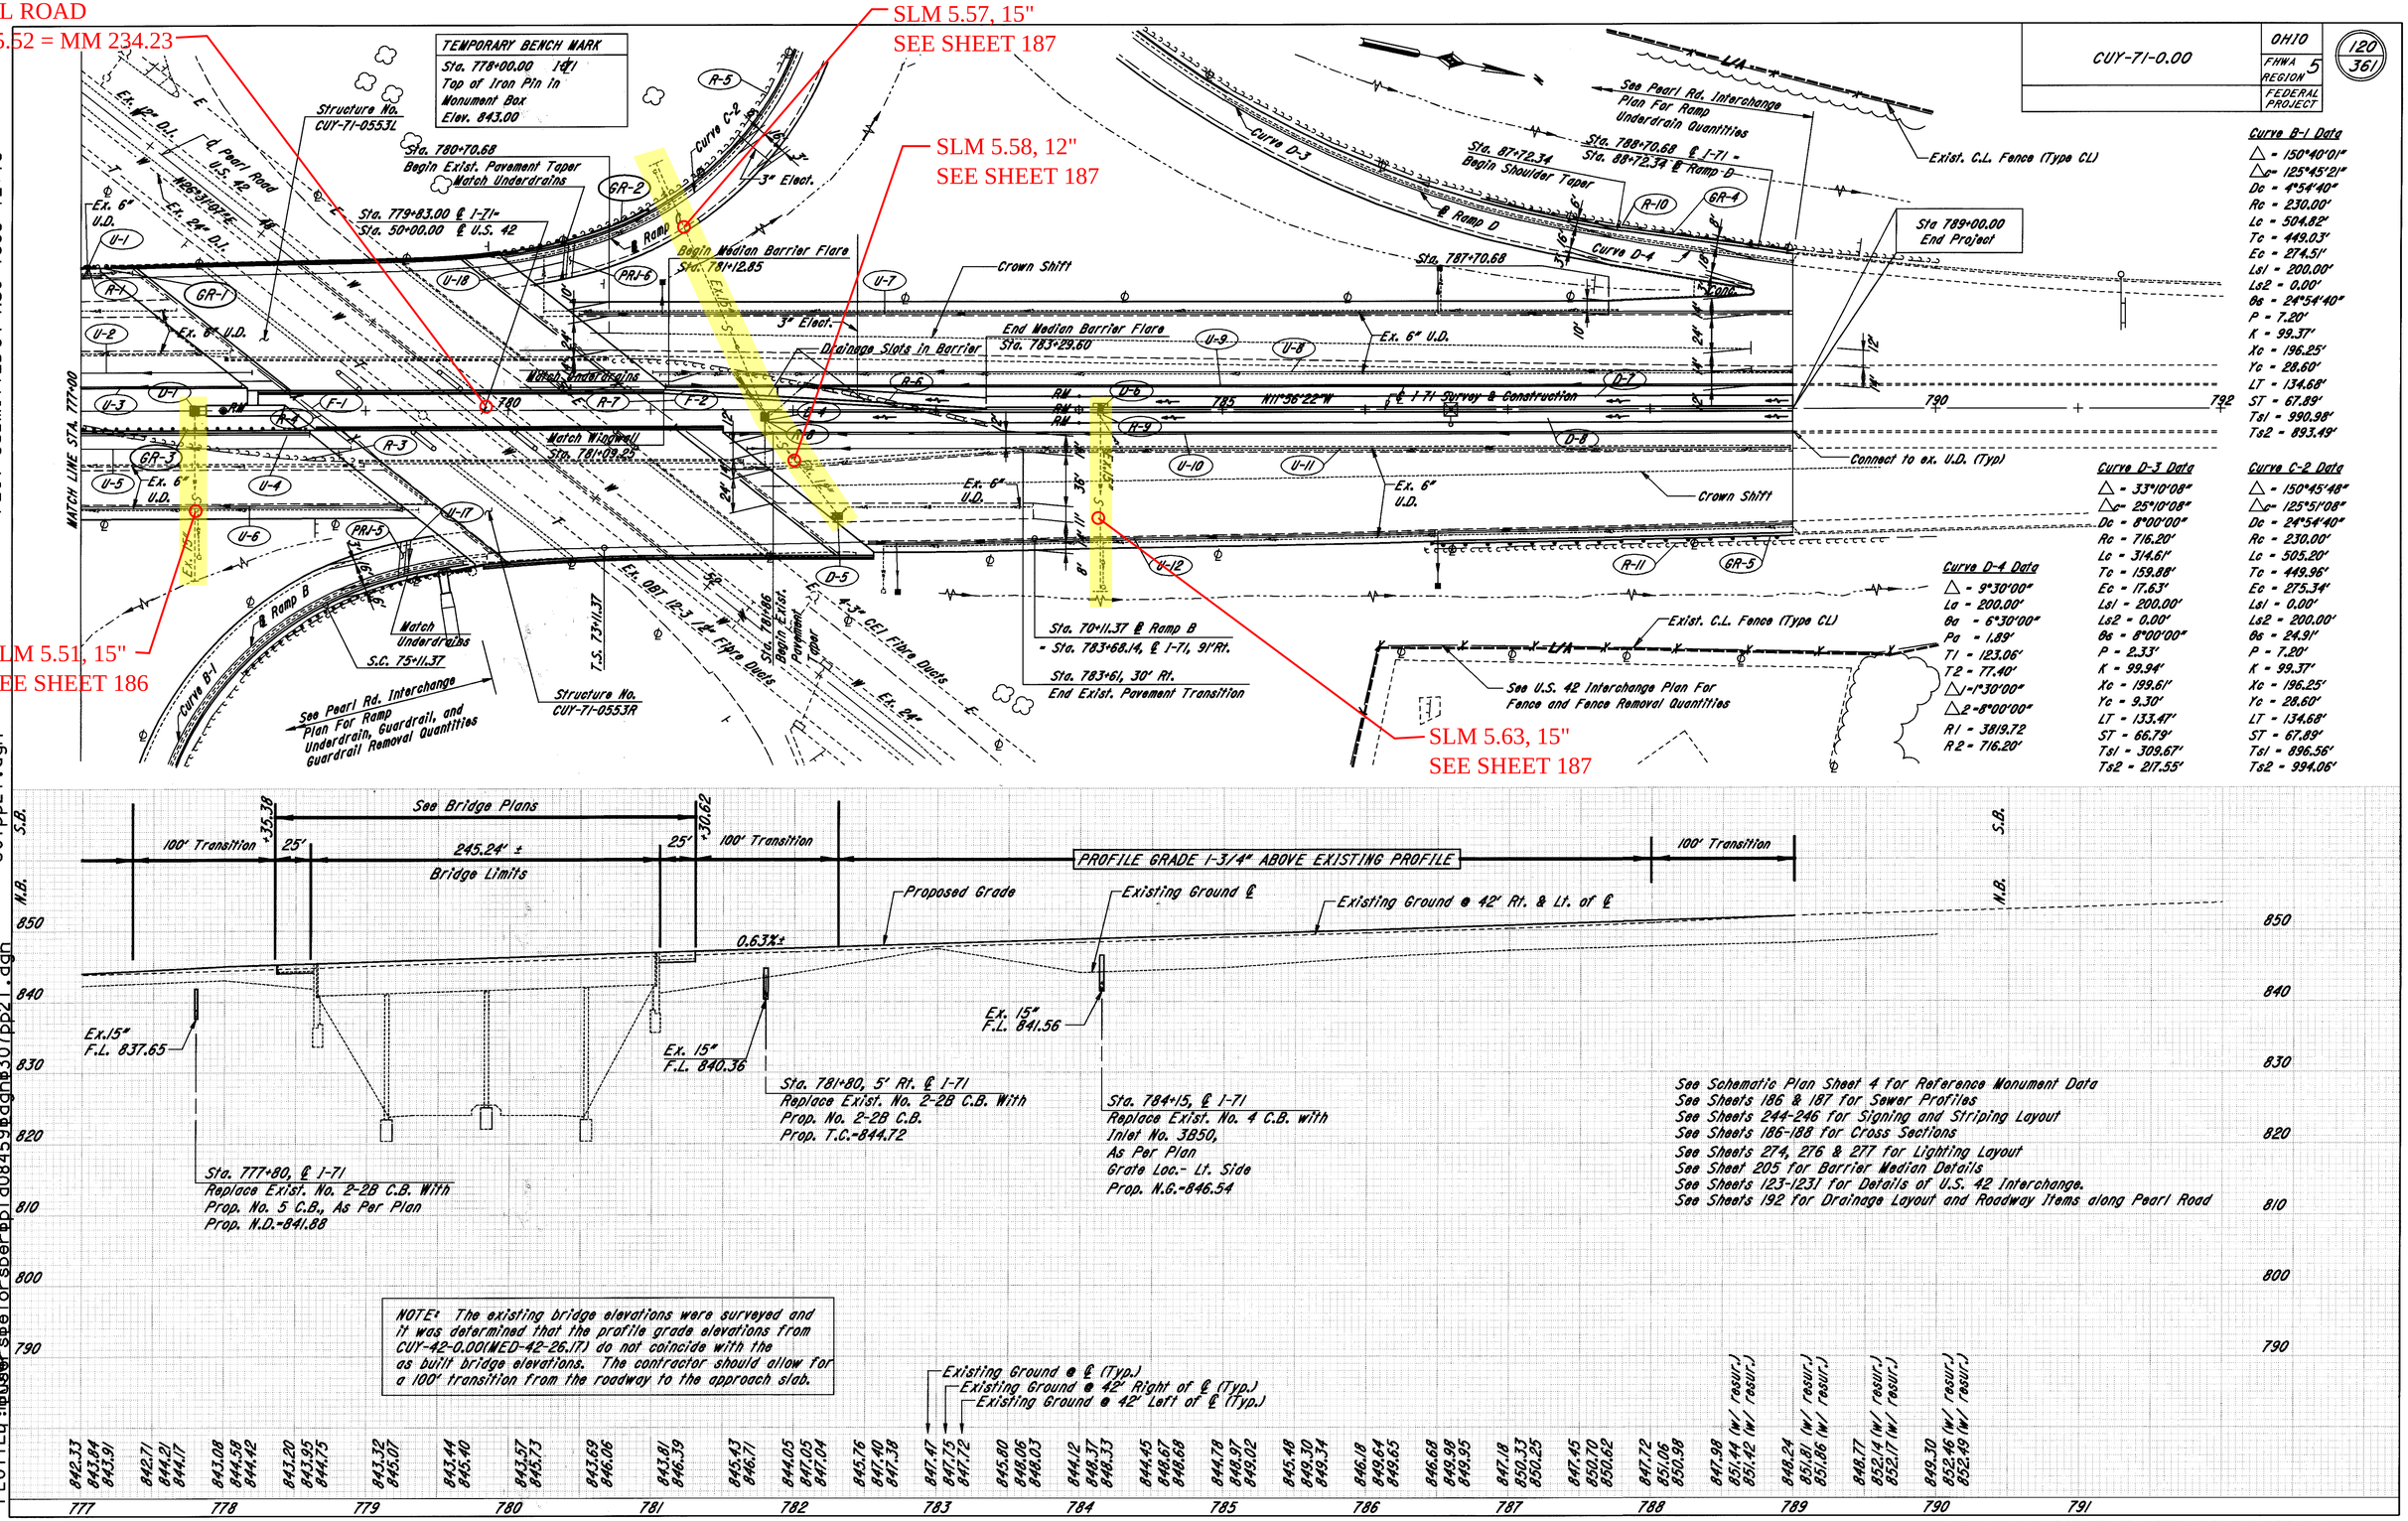


SEE 1964 CUY-71-3.38 PLANS
FOR ORIGINAL CONSTRUCTION
OF STORM SEWERS