


PLOTTED FROM: I:\users\eforsber\p\d08459\dgn\307xs01.dgn
 PLOT SUBMITTED: 24-JUL-1998 15:11
 307XS01.DGN

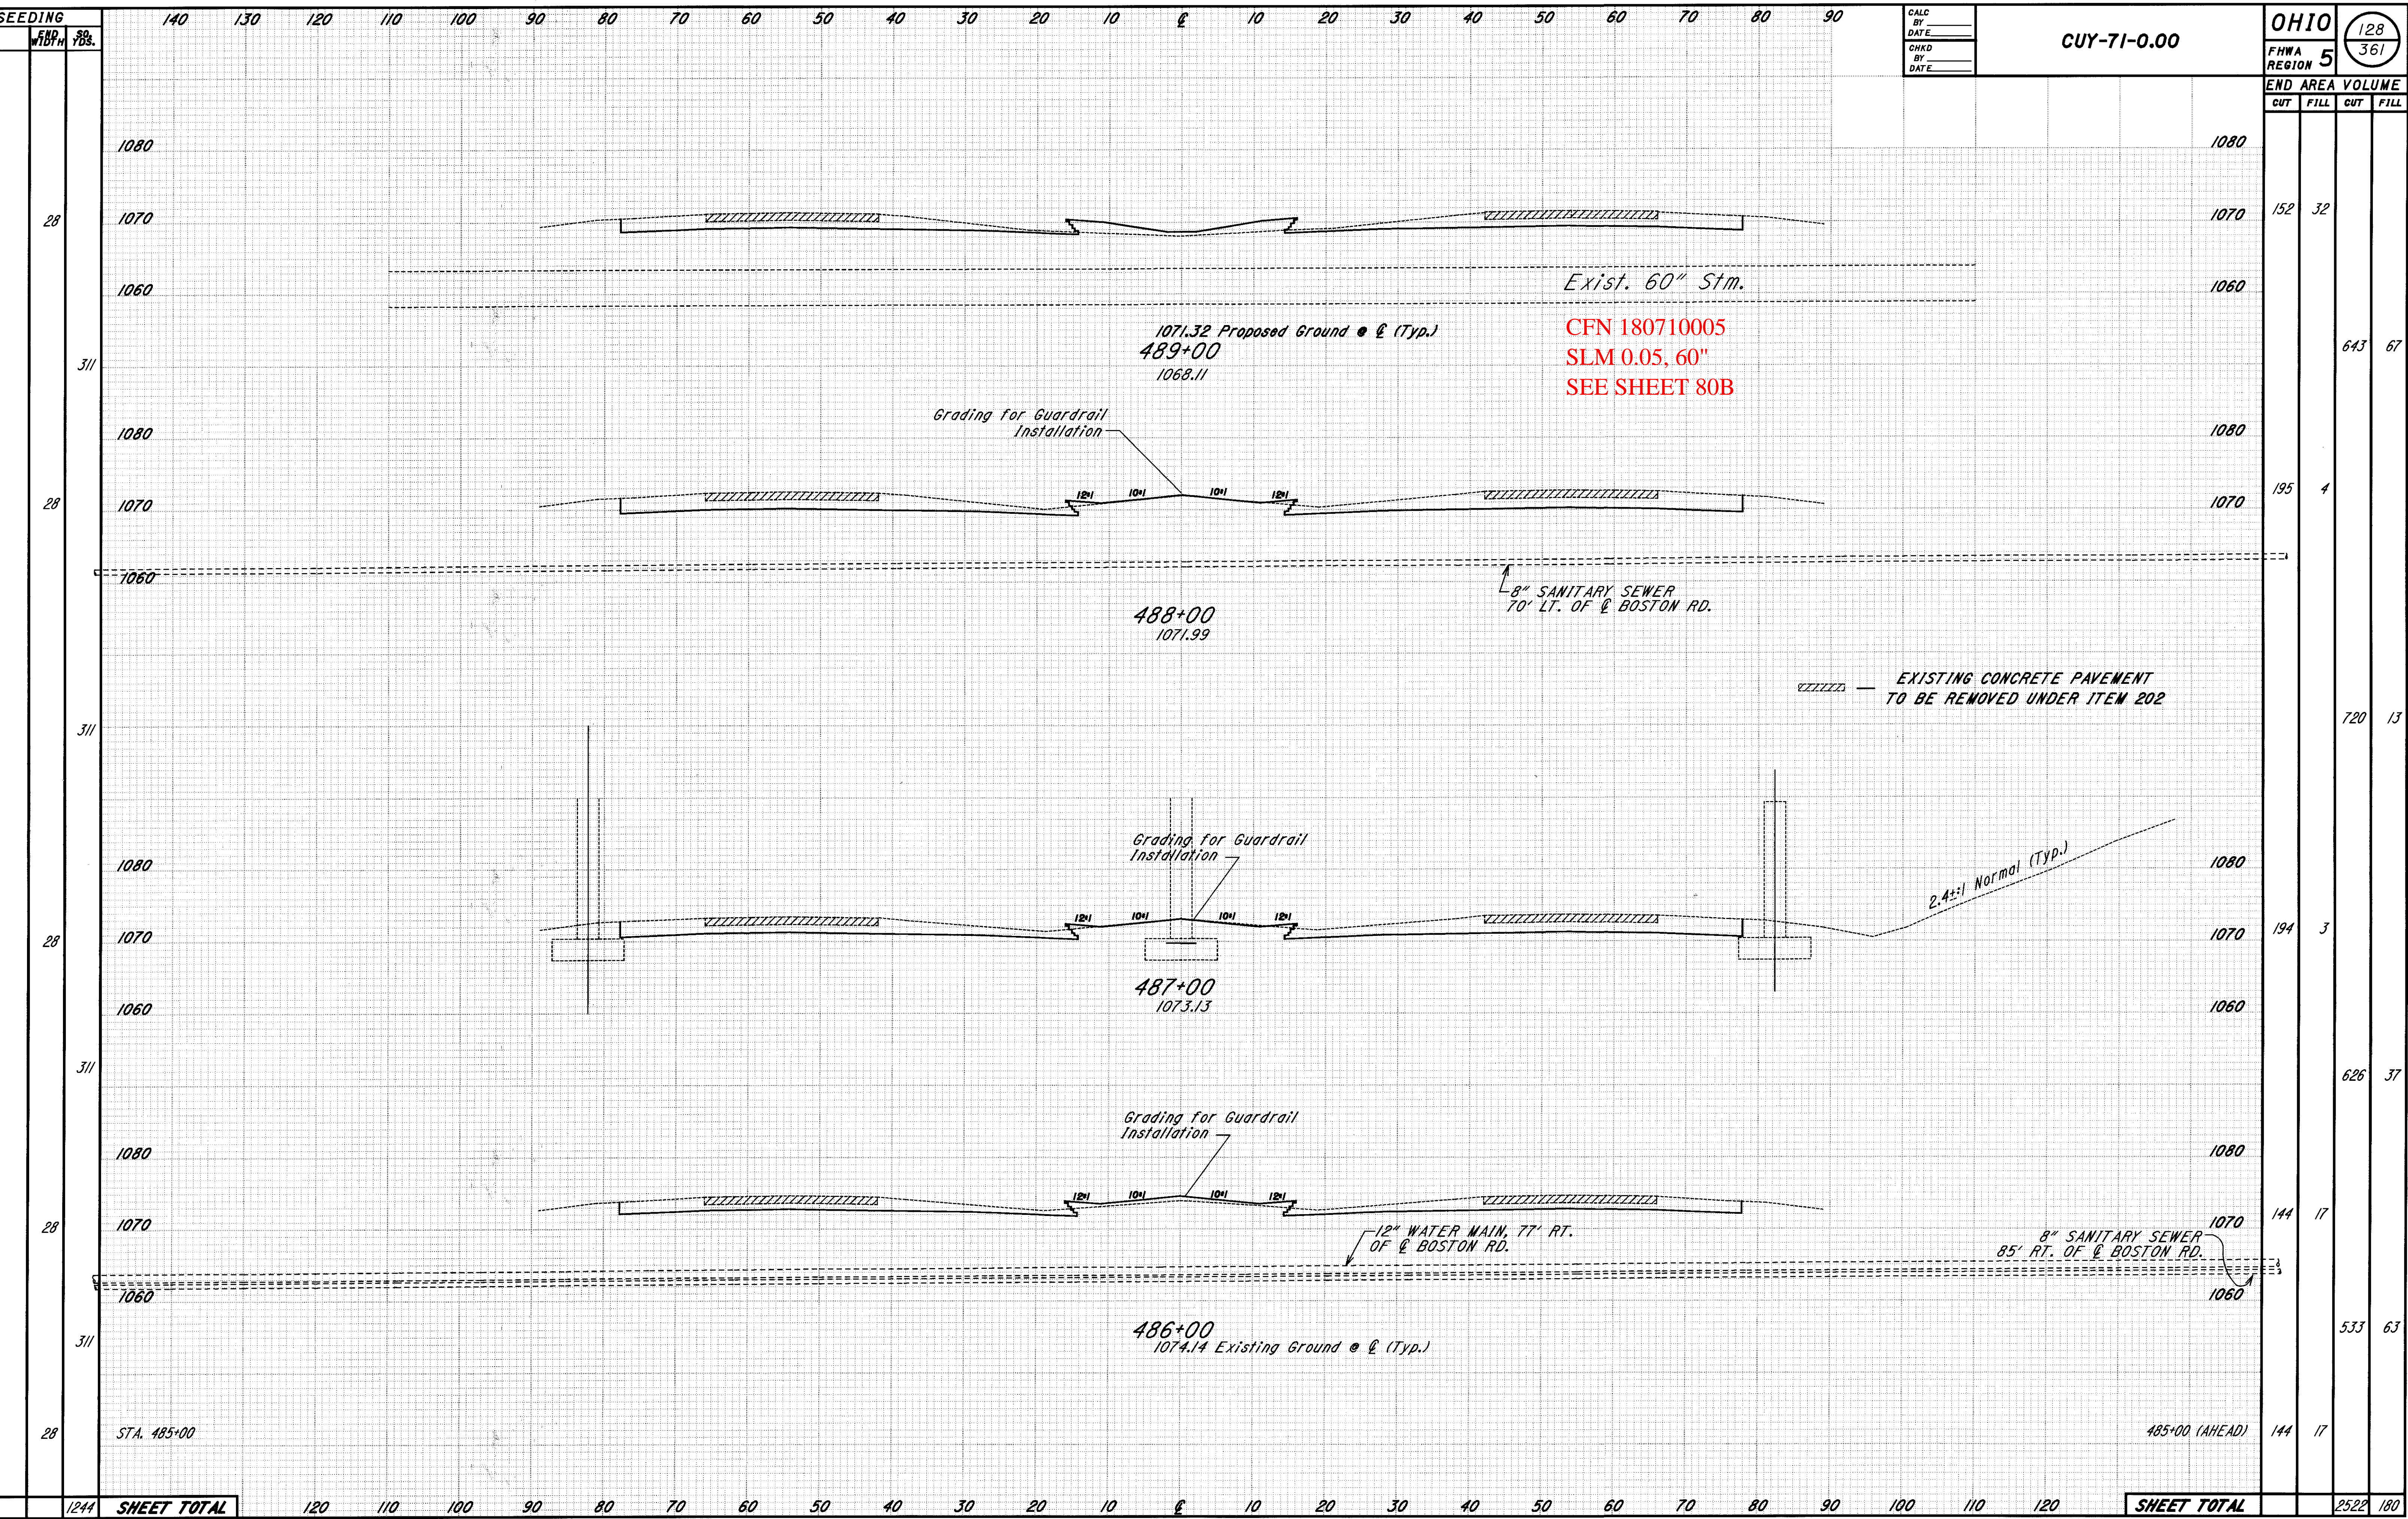

CROSS SECTIONS STA. 486+00 TO STA. 489+00