


PLOTTED FROM: 1:\users\eforsber\p\d08459\dgn\307xs04.dgn
 307XS04.DGN
 PLOT SUBMITTED: 24-JUL-1998 15:11

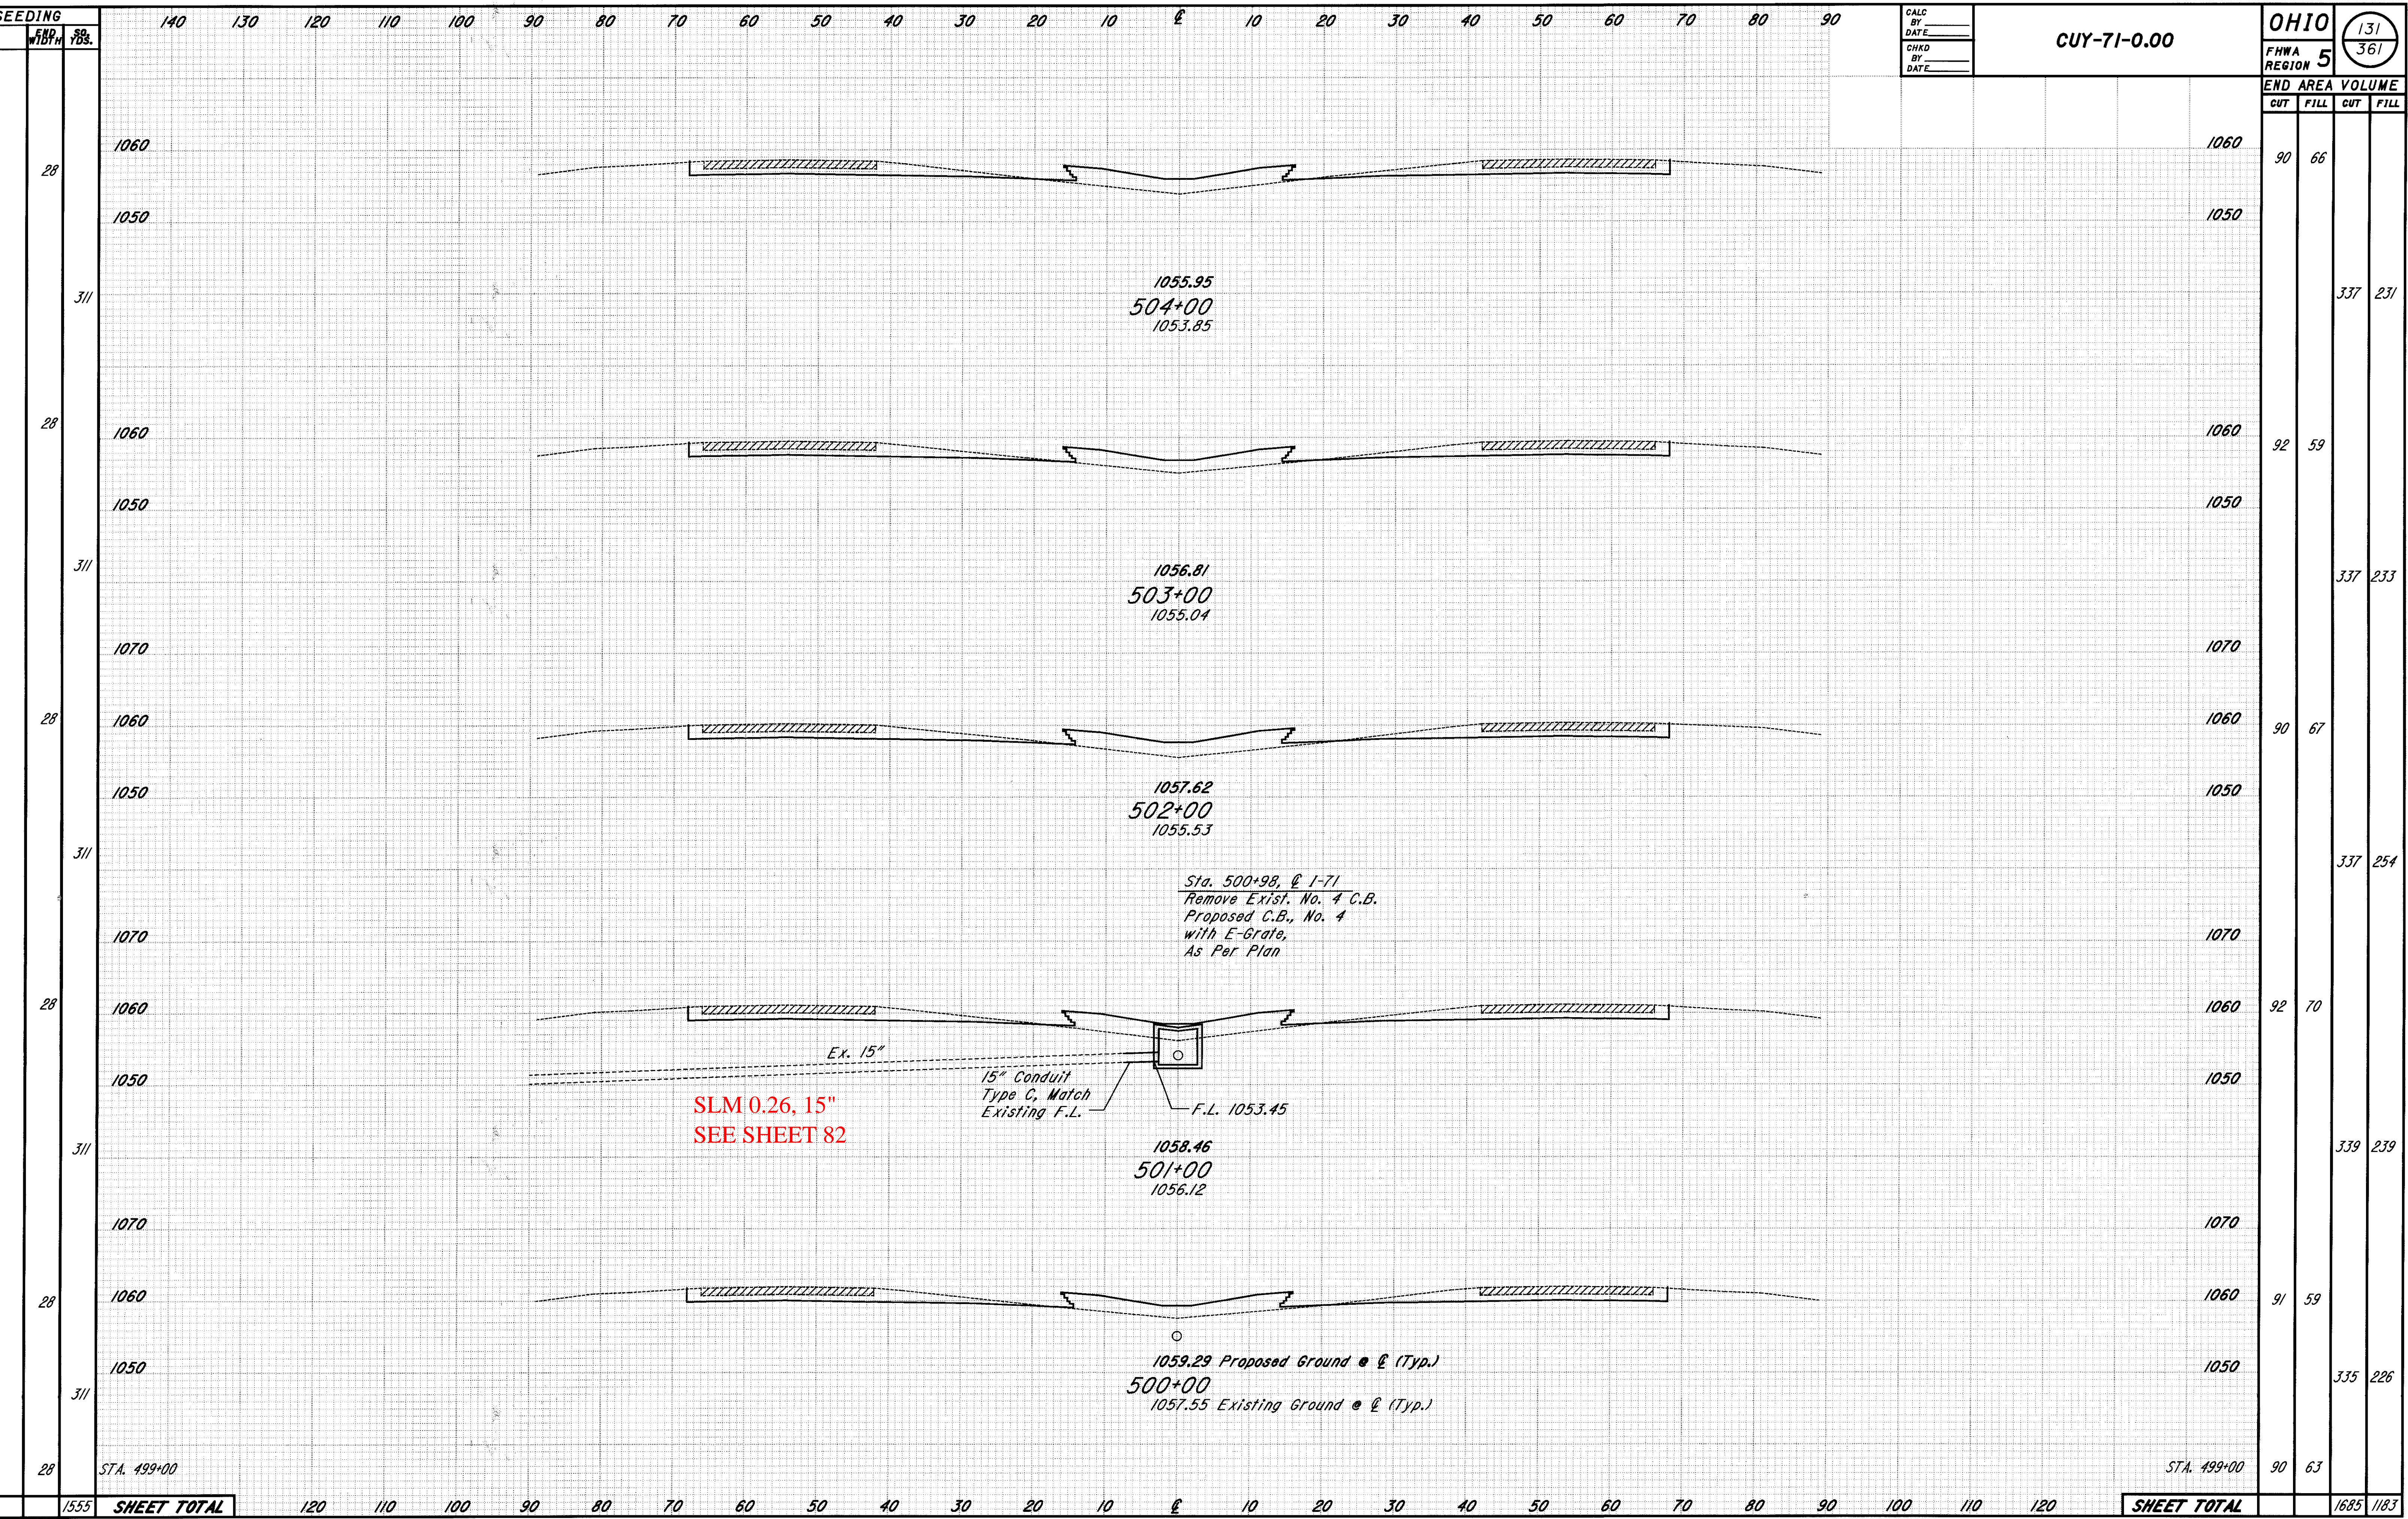

CROSS SECTIONS STA. 500+00 TO STA. 504+00