


PLOTTED FROM: i:\users\eforsber\pic08459\dgn\307xs06.dgn
 307XS06.DGN
 PLOT SUBMITTED: 24-JUL-1998 15:11

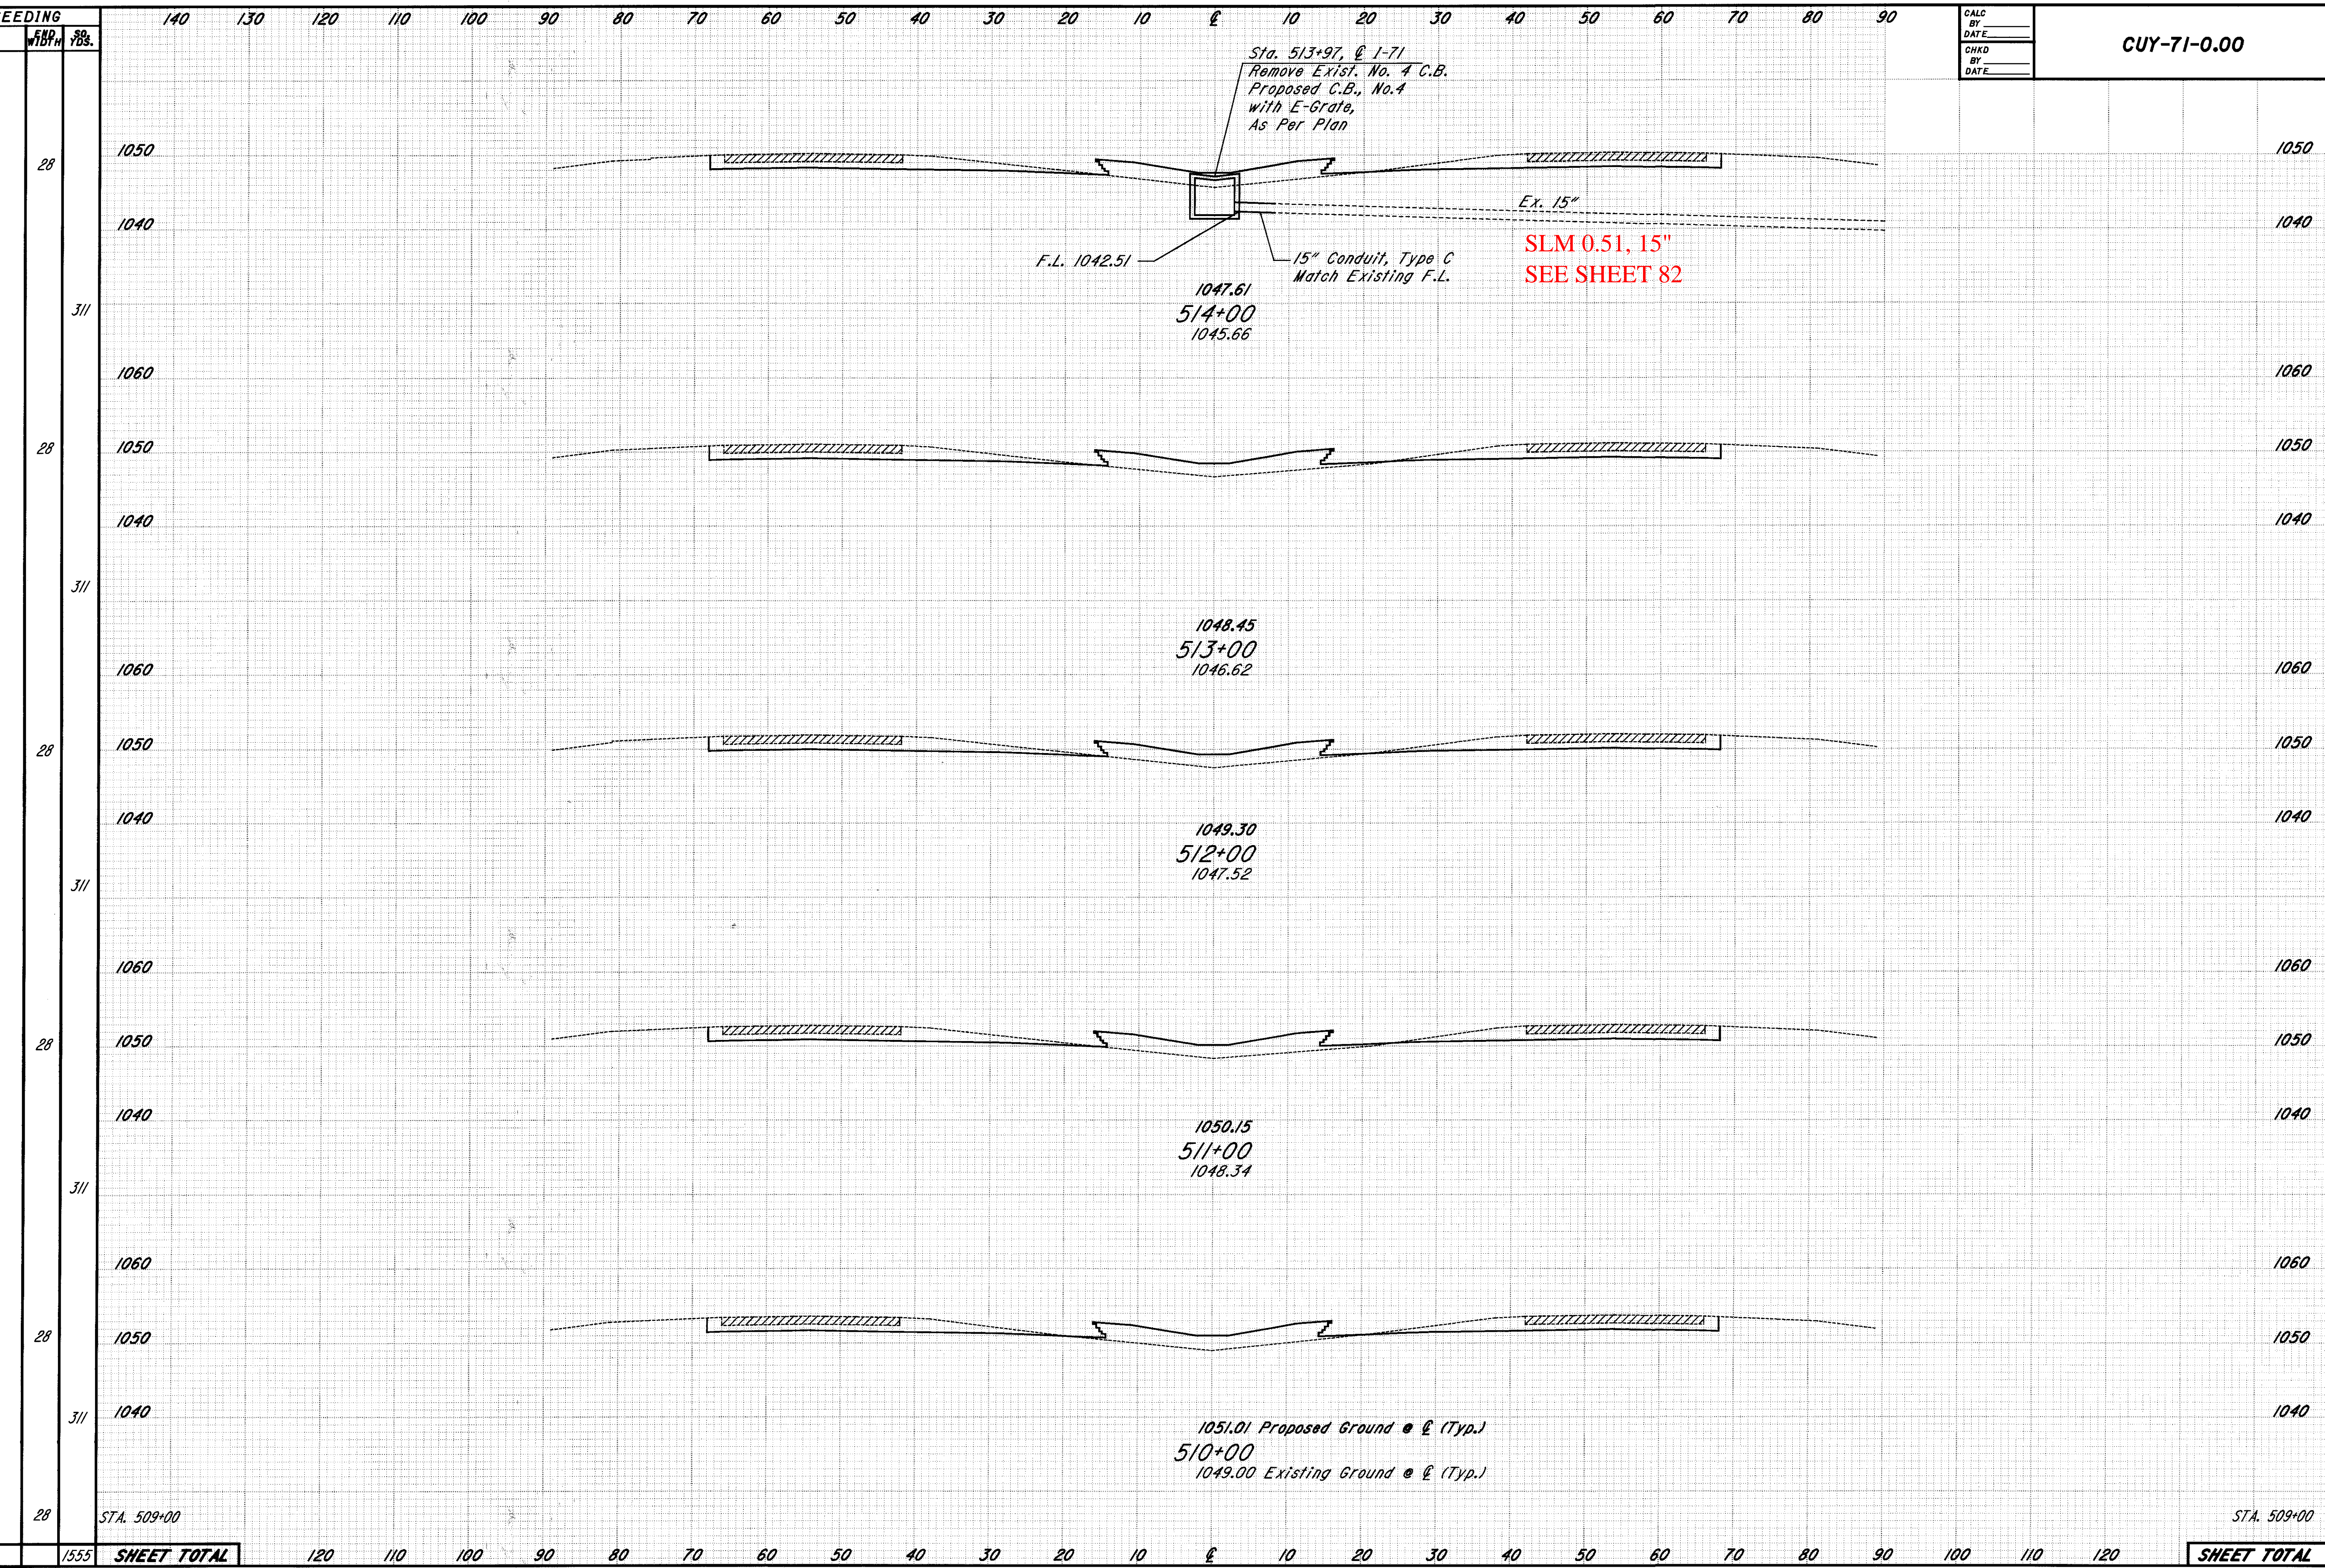

CALC BY _____ DATE _____ CHKD BY _____ DATE _____	CUY-71-0.00
--	--------------------

OHIO FHWA REGION 5 133 361

END AREA		VOLUME	
CUT	FILL	CUT	FILL
96	62		
		350	230
93	62		
		352	224
97	59		
		352	226
93	63		
		344	239
93	66		
		324	237
82	62		
		1722	1156

1555 SHEET TOTAL

SHEET TOTAL

CROSS SECTIONS STA. 510+00 TO STA. 514+00