

SEEDING

140 130 120 110 100 90 80 70 60 50 40 30 20 10 0 10 20 30 40 50 60 70 80 90

CALC BY
DATE
CHKD BY
DATE


CUY-71-0.00

OHIO
FHWA REGION 5
139
361

END AREA VOLUME
CUT FILL CUT FILL

PLOTTED FROM: I:\users\eforsber\pic08459\dgn\307xs12.dgn
PLOT SUBMITTED: 24-JUL-1998 15:11

28
311
28
89
28
28
205
28

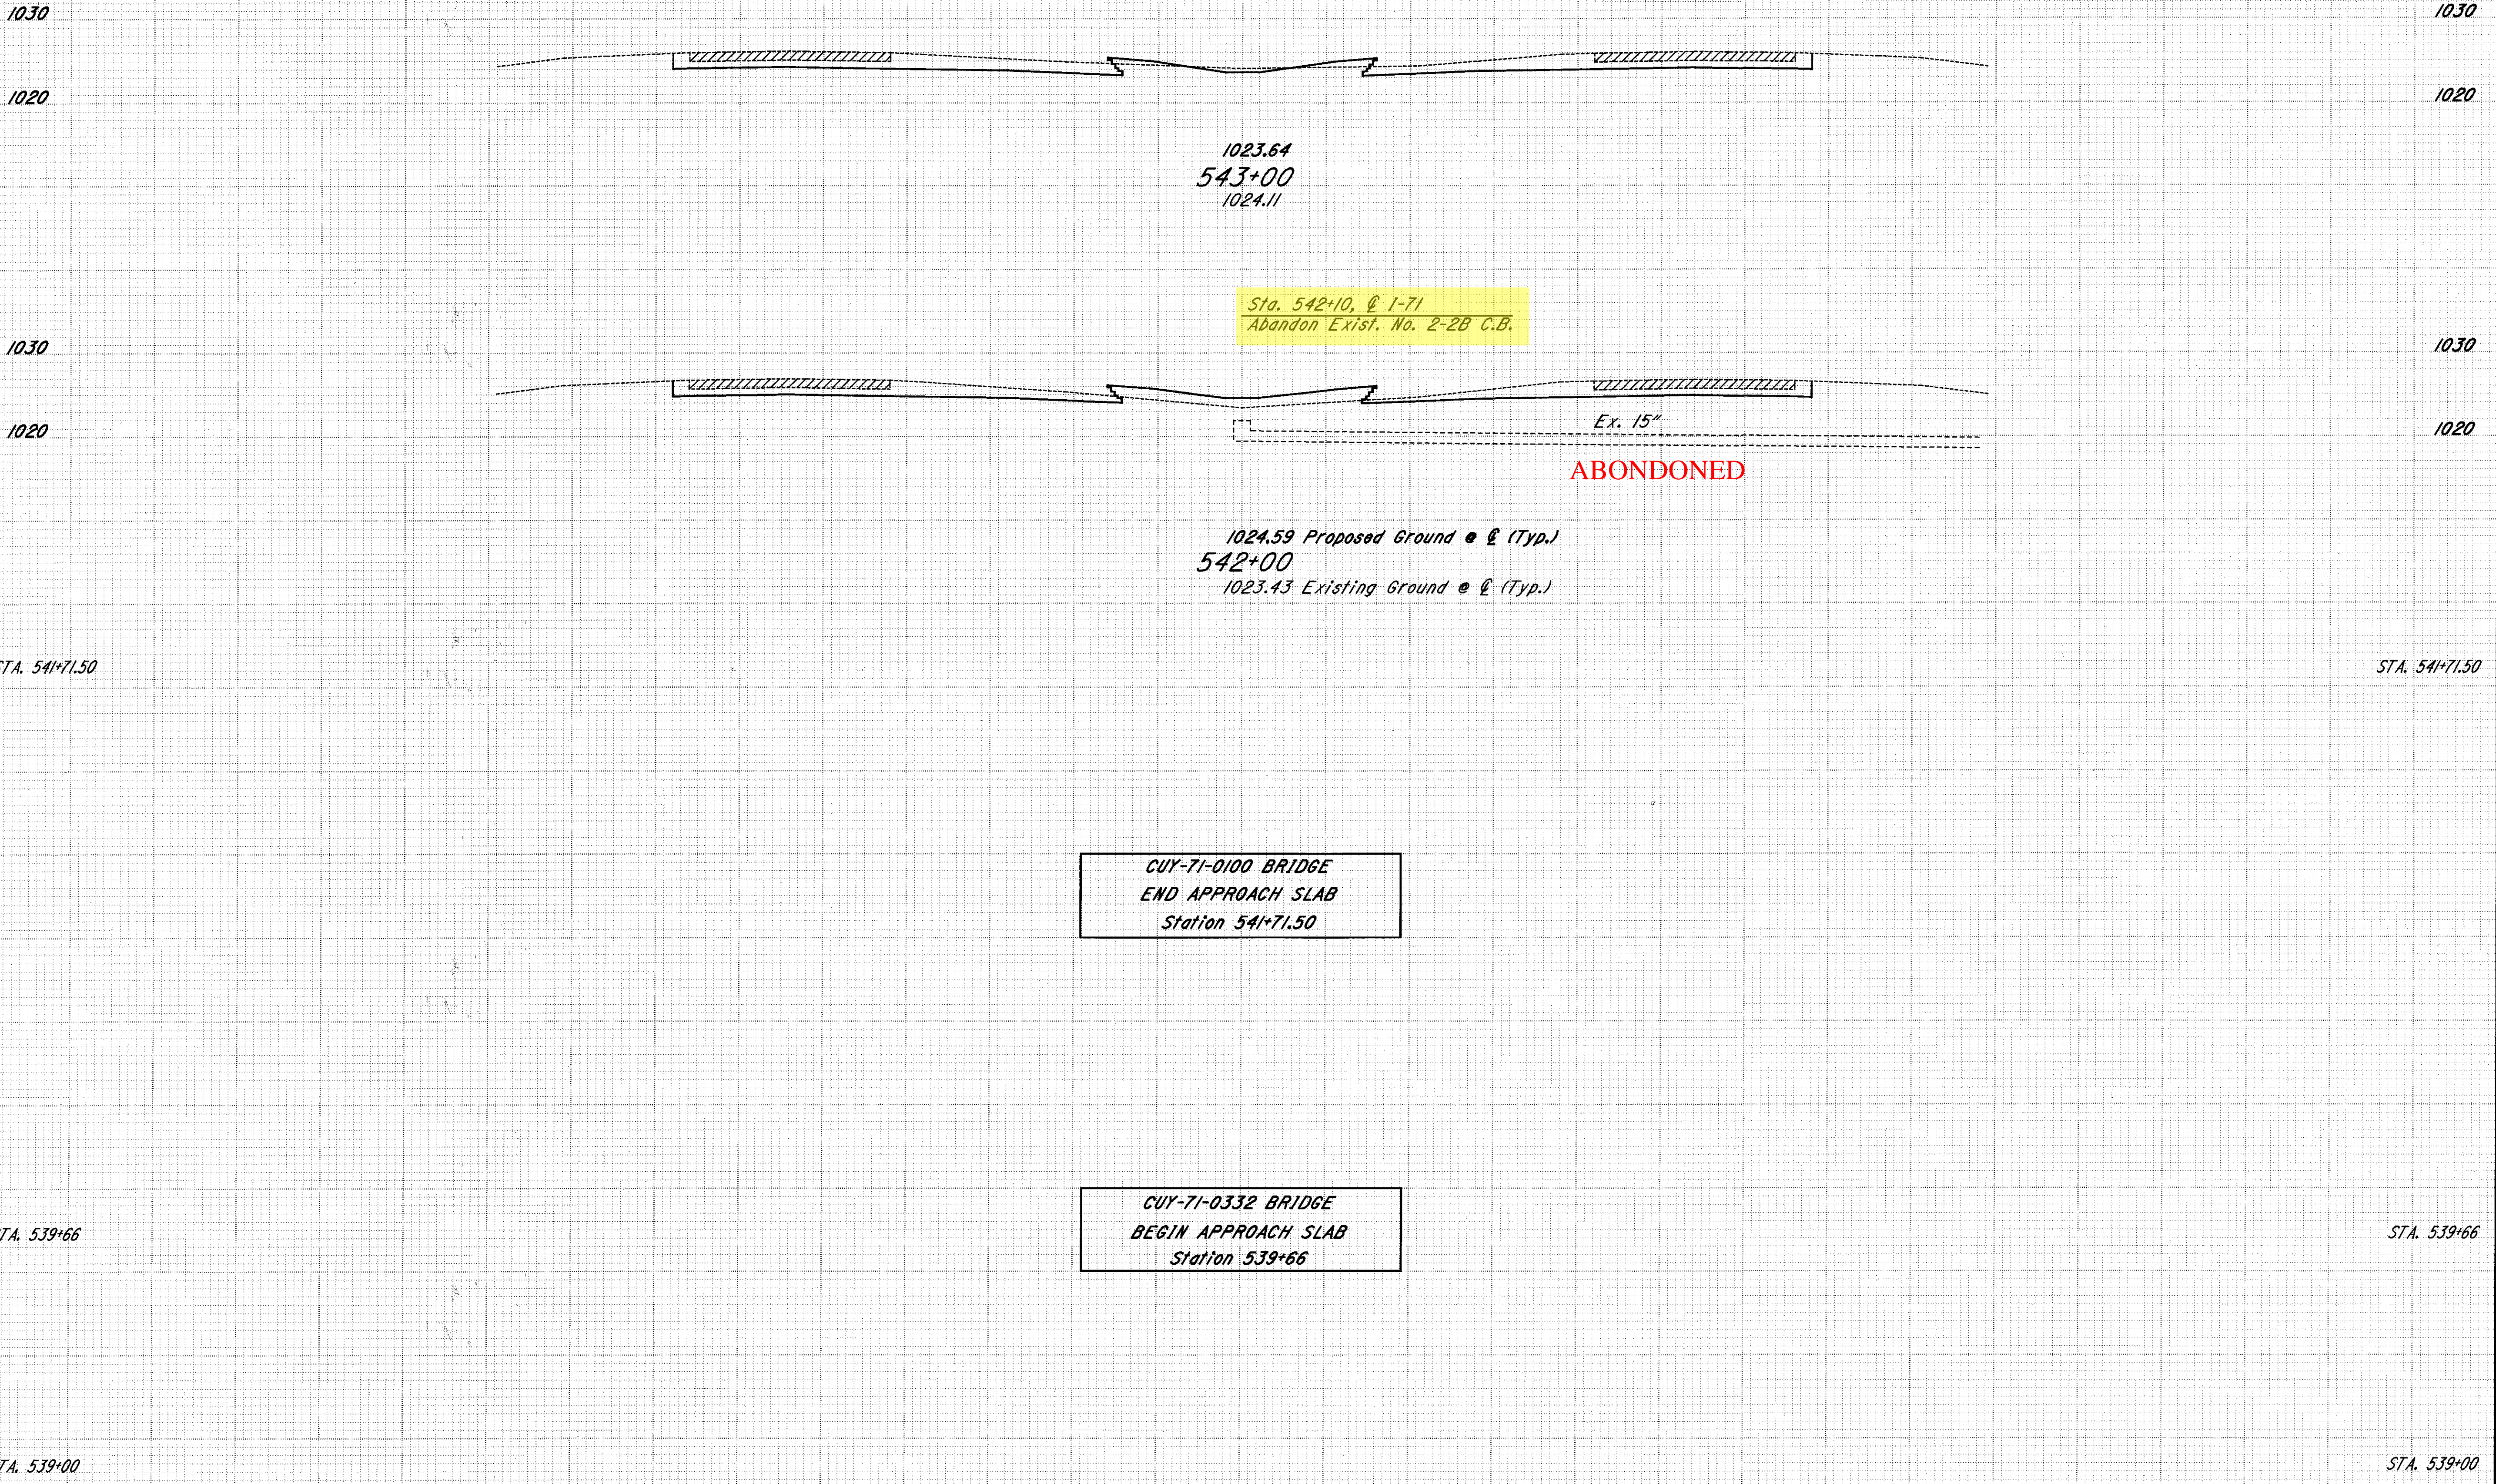

10.30	10.30	133	9
10.20	10.20		
			457 78
10.30	10.30	114	33
10.20	10.20		
			120 35
STA. 541+71.50	STA. 541+71.50	114	33
STA. 539+66	STA. 539+66	106	52
			259 127
STA. 539+00	STA. 539+00	106	52

CUY-71-0100 BRIDGE
END APPROACH SLAB
Station 541+71.50

CUY-71-0332 BRIDGE
BEGIN APPROACH SLAB
Station 539+66

ABONDONED

1023.64
543+00
1024.11

1024.59 Proposed Ground @ (Typ.)
542+00
1023.43 Existing Ground @ (Typ.)

Sta. 542+10, @ 1-71
Abandon Exist. No. 2-2B C.B.

Ex. 15"

STA. 541+71.50

STA. 541+71.50

STA. 539+66

STA. 539+66

STA. 539+00

STA. 539+00

605 SHEET TOTAL

SHEET TOTAL

836 240

CROSS SECTIONS STA. 540+00 TO STA. 543+00