PLOT SUBMITTED: 24-JUL-1998 15:11

PLOTTED FROM: i:\users\eforsber\pid08459\dgn\307xs14.dgn

307XS14.DGN

CALC BY _____ DATE _____

CHKD BY _____ DATE _____

CUY-71-0.00

OHIO

FHWA REGION 5

141 / 361

SEEDING		
	END WIDTH	SQ. YDS.
STA. 548+00	28	
	28	311
	28	
	28	311
	28	
	28	311
	28	
	28	311
	28	
SHEET TOTAL	1555	

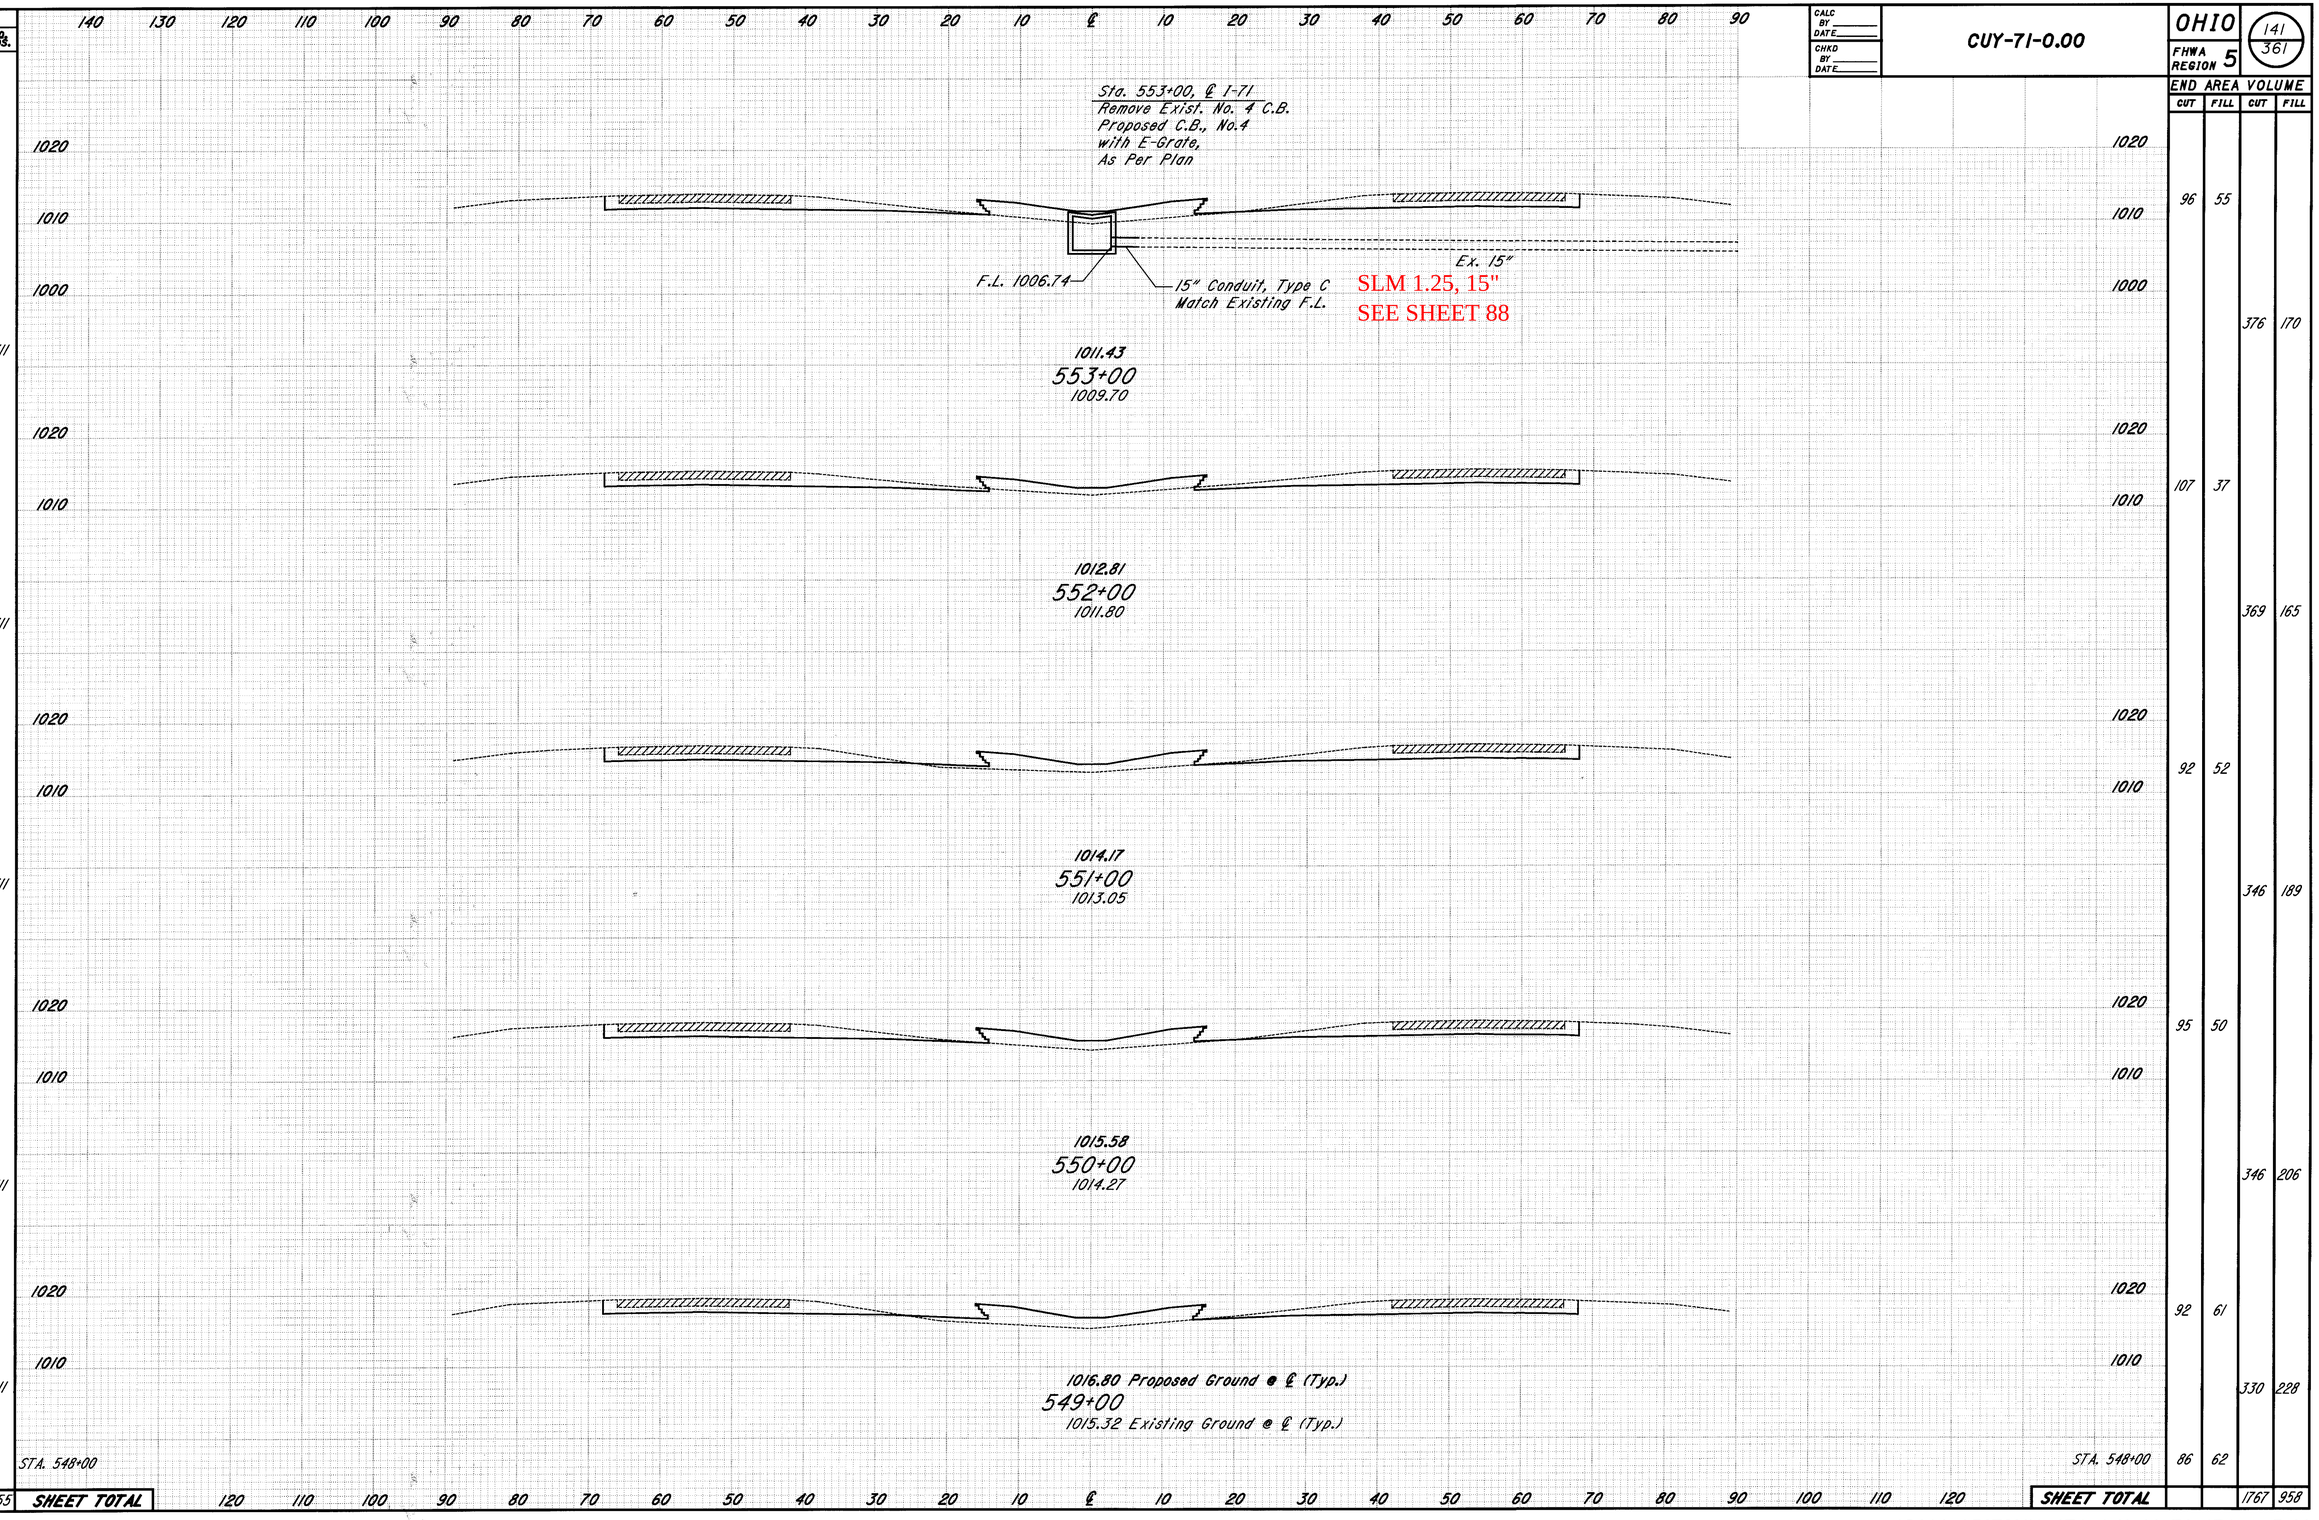

END AREA VOLUME			
CUT	FILL	CUT	FILL
96	55		
		376	170
107	37		
		369	165
92	52		
		346	189
95	50		
		346	206
92	61		
		330	228
86	62		
		1767	958

CROSS SECTIONS STA. 549+00 TO STA. 553+00