


0555
 0556
PLOTTED FROM: sber\p\08459@dgn@307.xls.dgn
 PLOT SUBMITTED: 24-JUL-1998 15:11
 307XS15.DGN

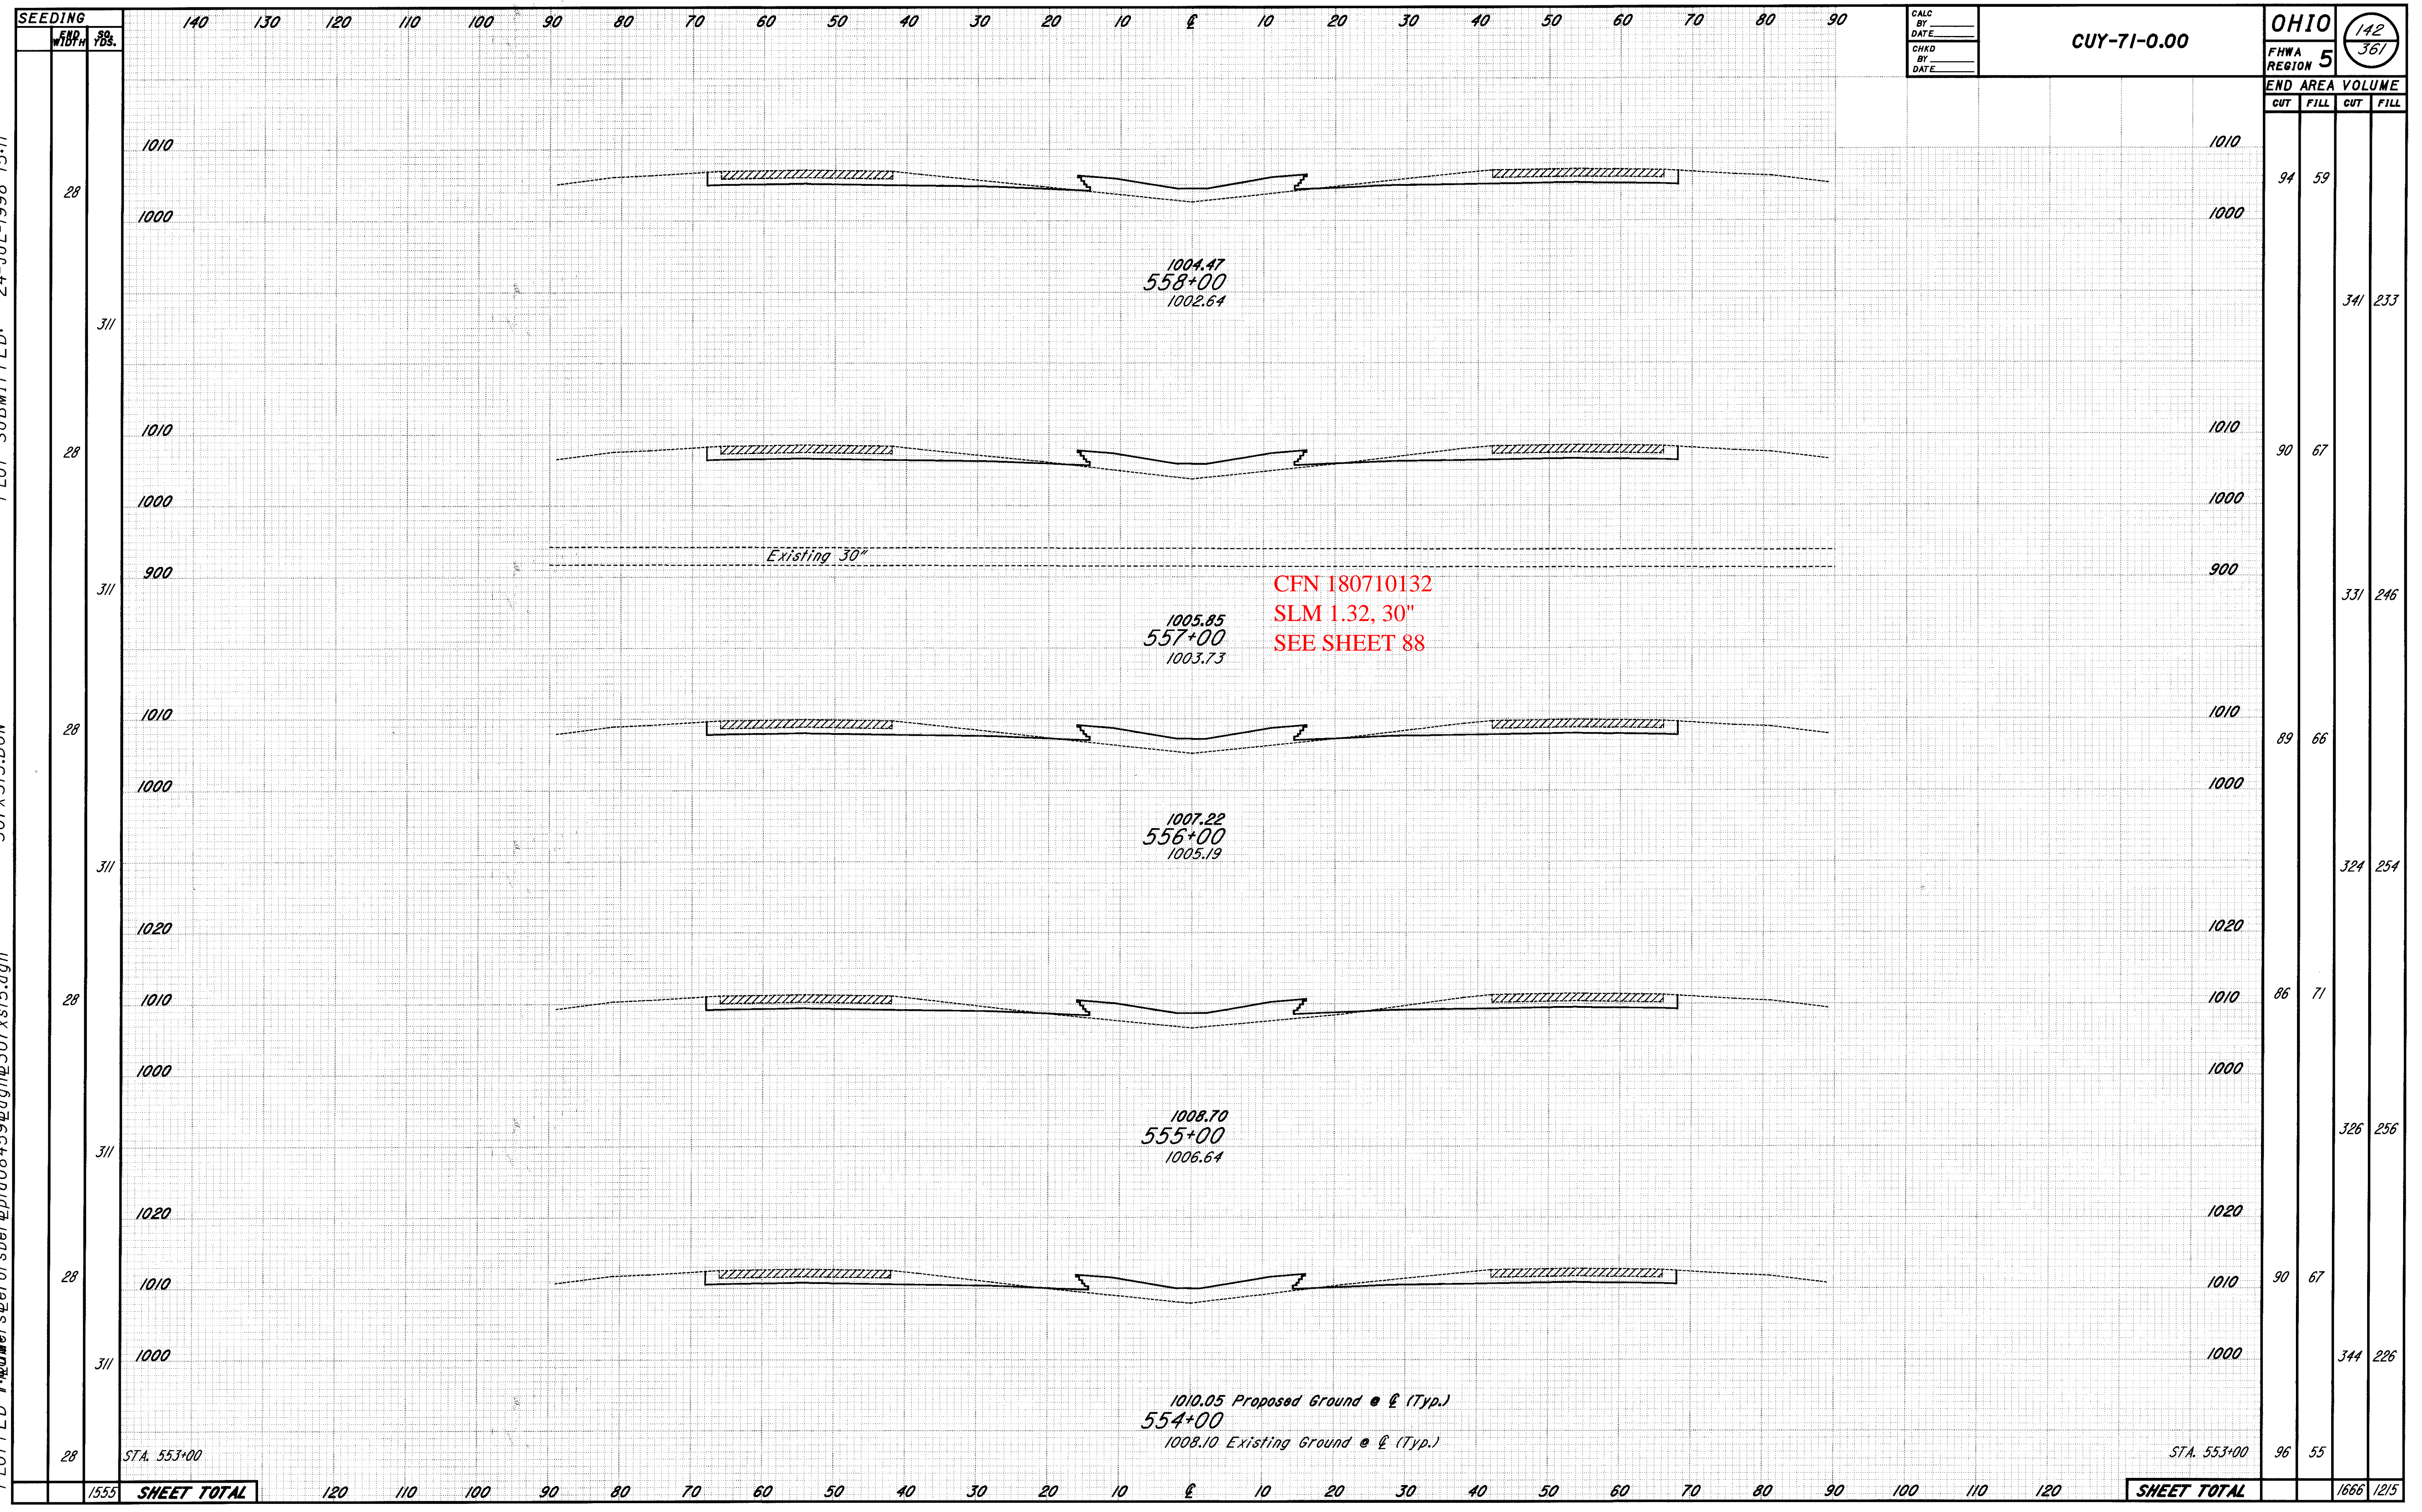

CROSS SECTIONS STA. 554+00 TO STA. 558+00