CALC BY ____ DATE ____
CHKD BY ____ DATE ____

CUY-71-0.00

OHIO
FHWA REGION 5

144
361

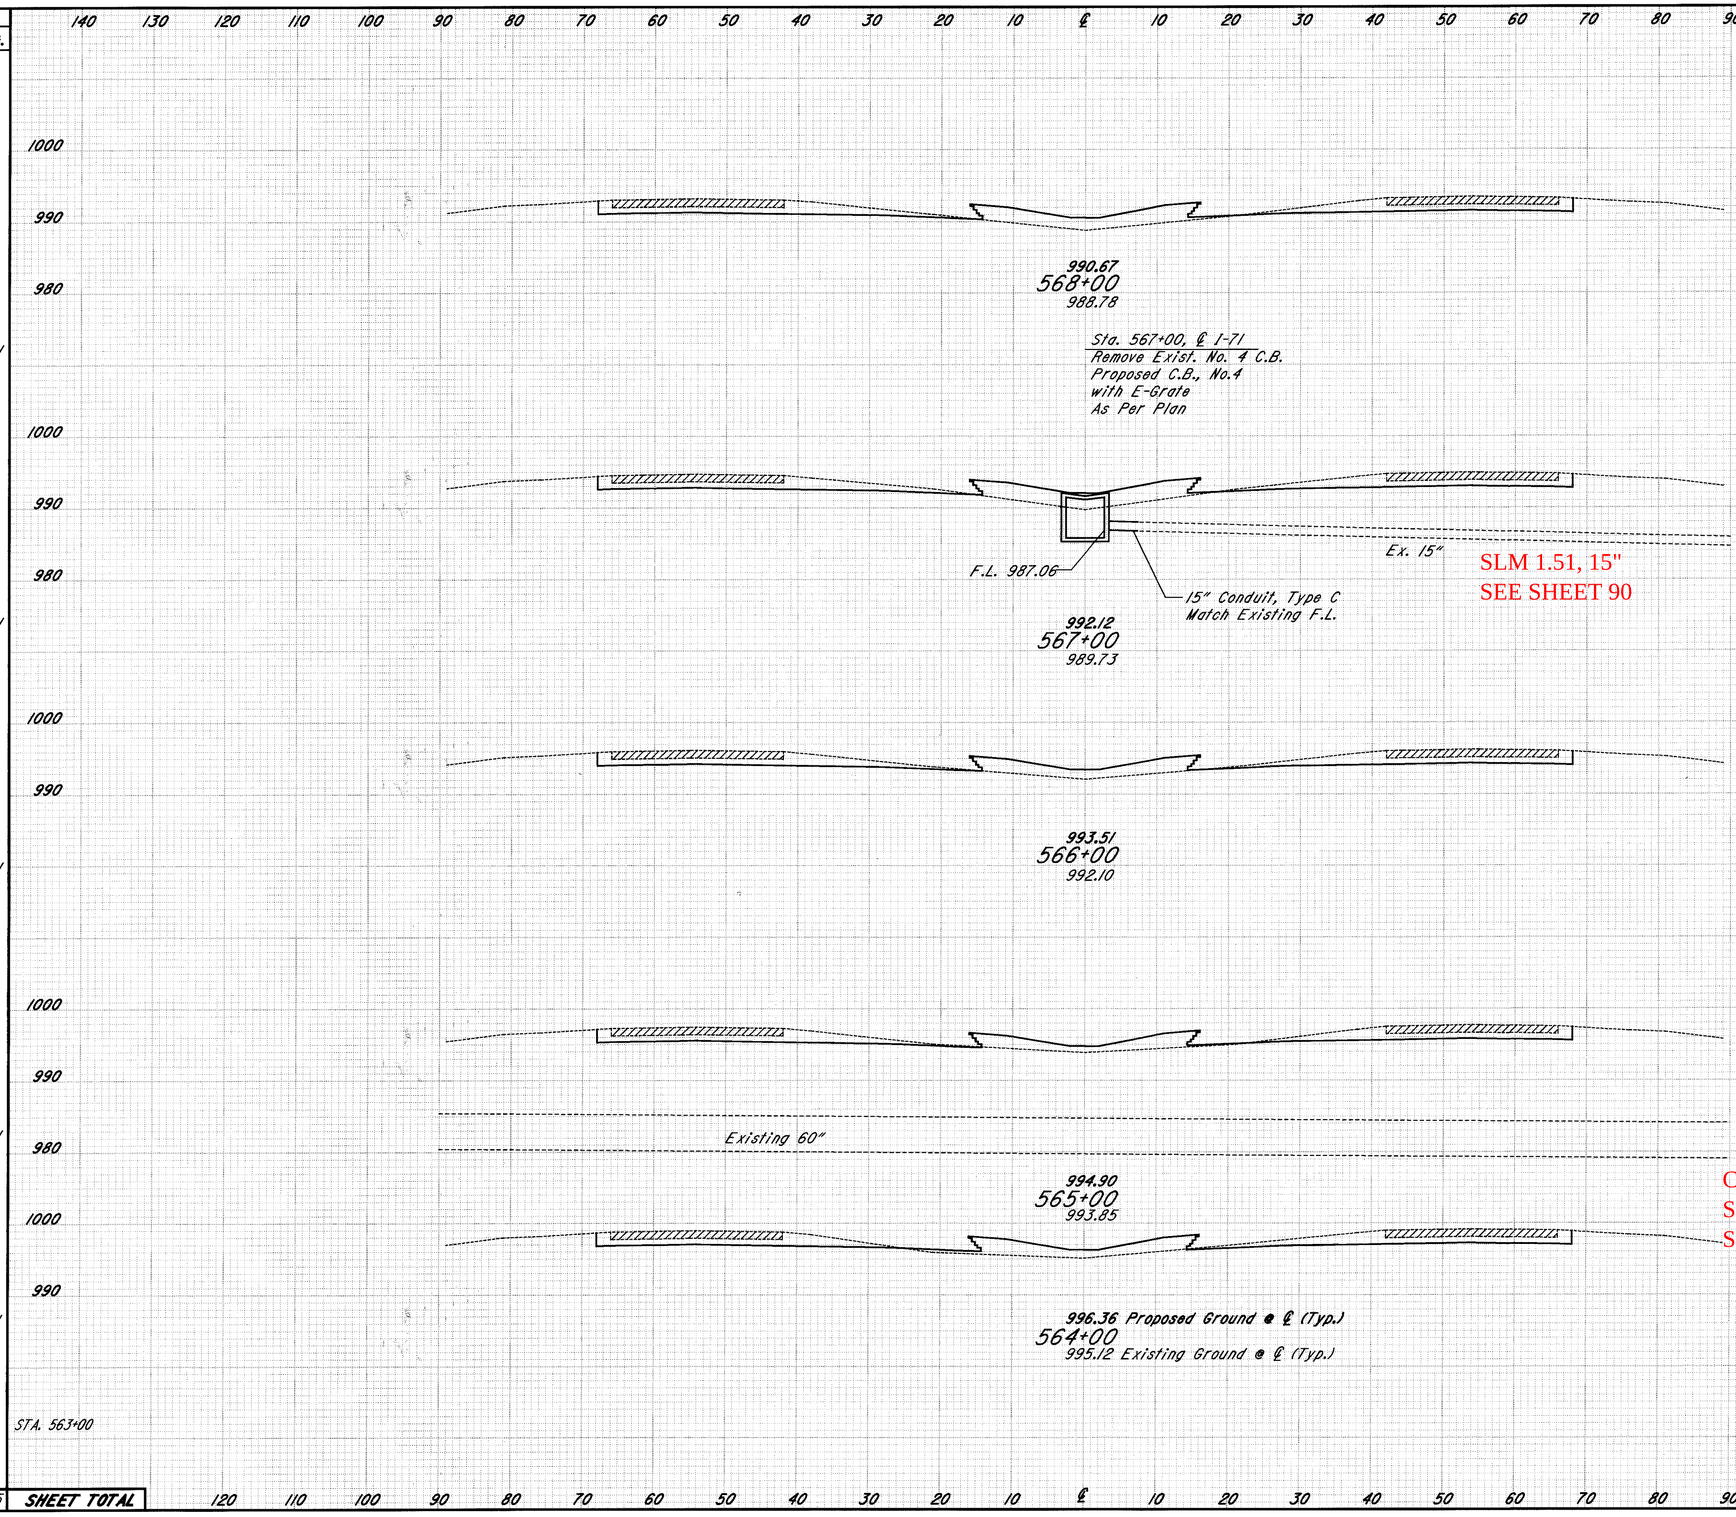

SLM 1.51, 15"
SEE SHEET 90

CFN 180710147
SLM 1.47, 60"
SEE SHEET 90

SEEDING END WIDTH	SEEDING SQ. YDS.		END AREA CUT	END AREA FILL	VOLUME CUT	VOLUME FILL
28		STA. 563+00	93	57		
28	311	564+00	92	53	343	204
28	311	565+00	89	47	337	185
28	311	566+00	95	50	341	180
28	311	567+00	95	68	351	219
28	311	568+00	107	47	374	212
	1555	SHEET TOTAL			1746	1000

CROSS SECTIONS STA. 564+00 TO STA. 568+00

PLOTTED FROM: Beforsber Epid08459Edgn E307xs17.dgn
PLOT SUBMITTED: 24-JUL-1998 15:11
307XS17.DGN