CUY-71-0.00
OHIO
FHWA REGION 5
150
361

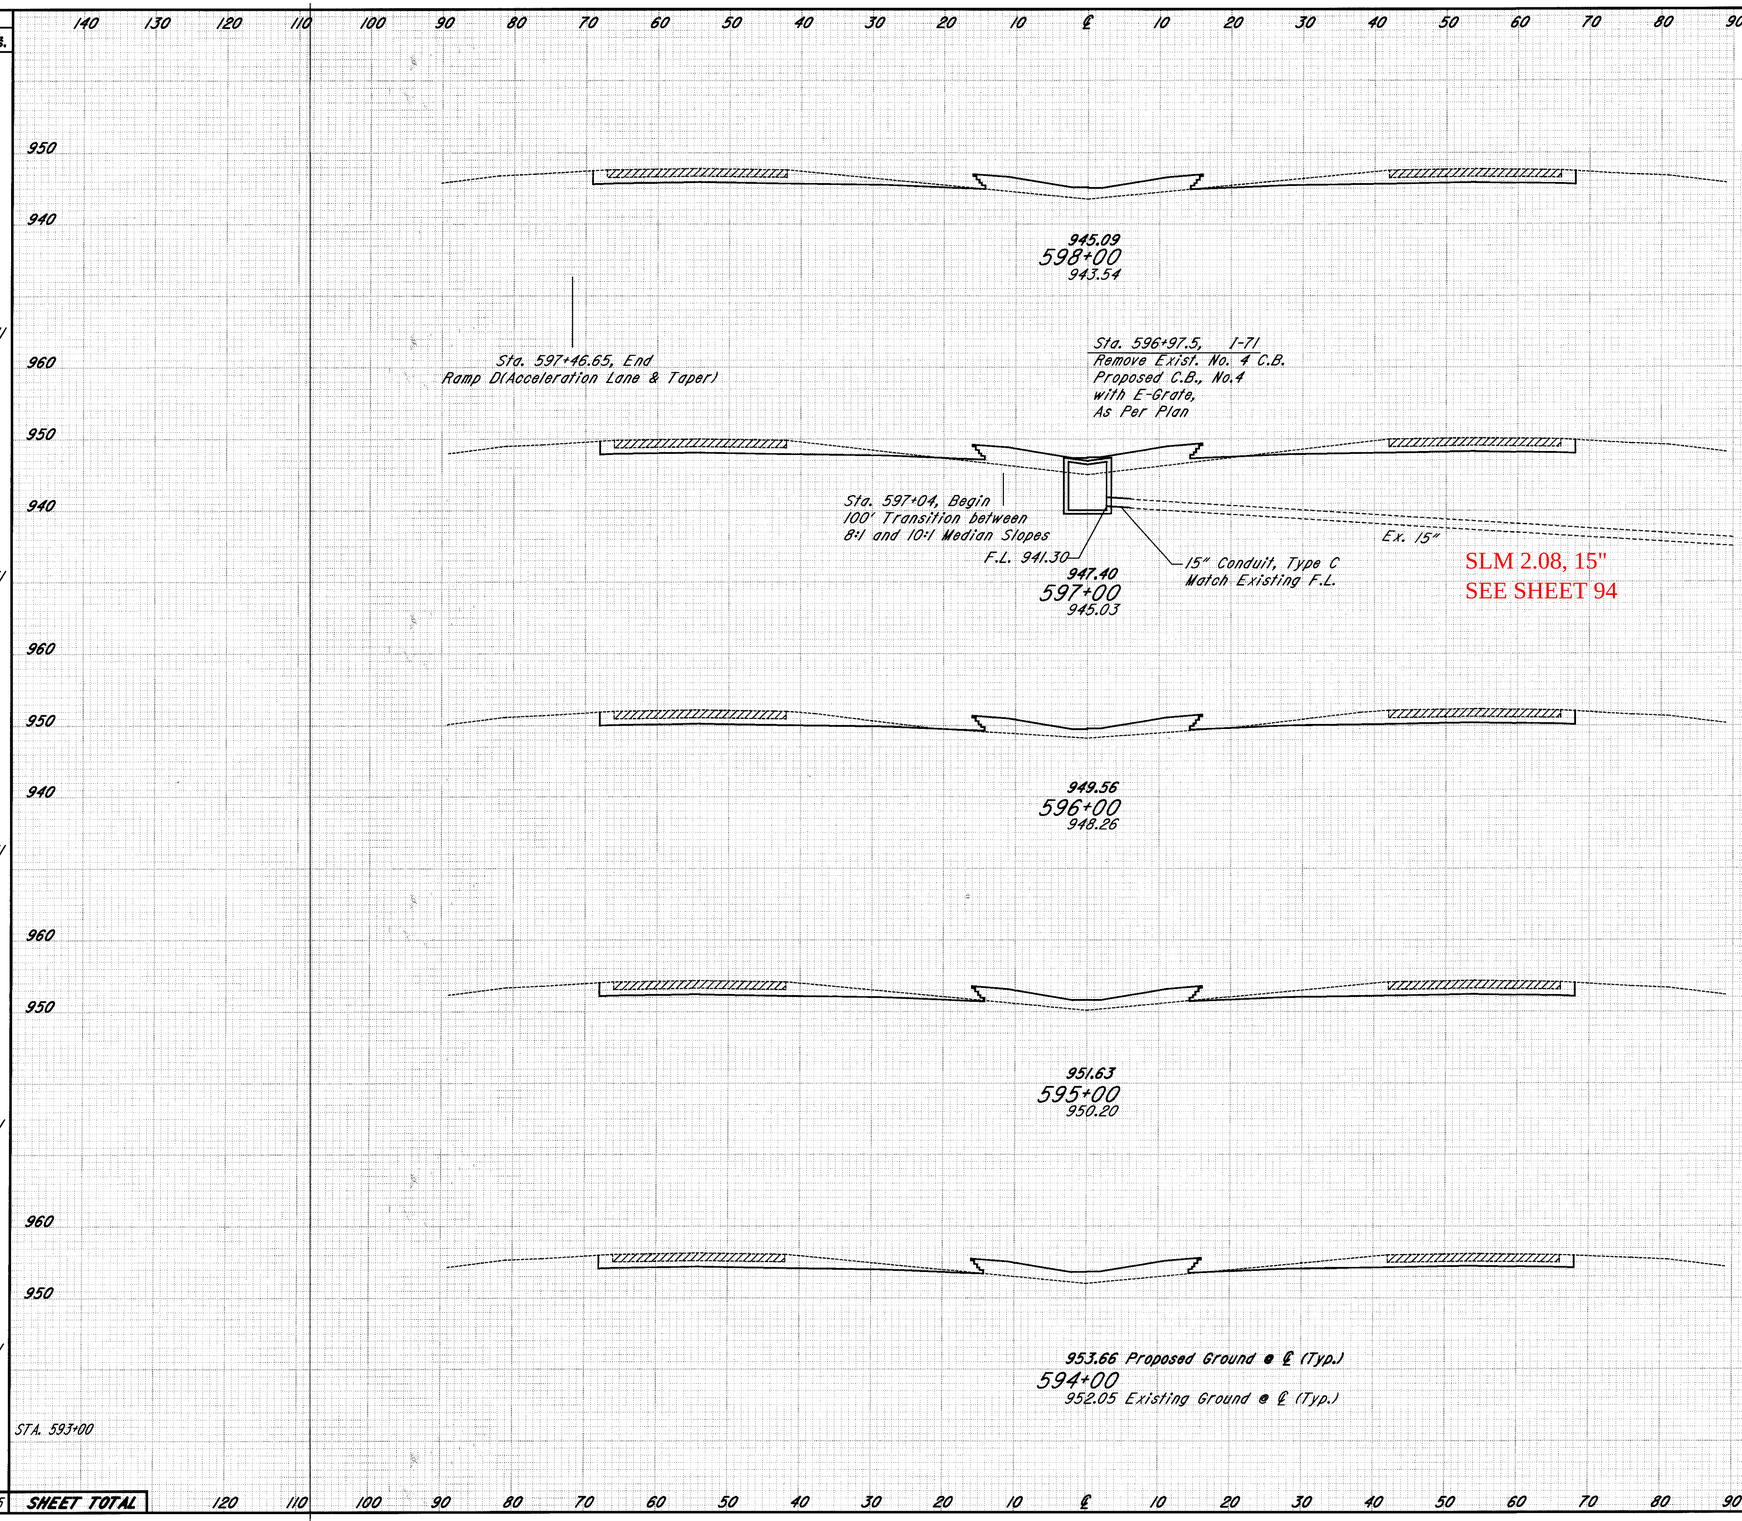

SEEDING END WIDTH	SEEDING SQ. YDS.	END AREA CUT	END AREA FILL	VOLUME CUT	VOLUME FILL
28		97	52		
				180	125
		85	75		
	311				
				149	130
28		85	75		
				322	233
	311				
28		89	51		
				348	187
	311				
28		99	50		
				343	193
	311				
28		86	54		
				346	181
28		101	44		
	1555			1688	1049

SHEET TOTAL

CROSS SECTIONS STA. 594+00 TO STA. 598+00

PLOTTED FROM: Rosers Beforsber Bpid08459 Bdgn B307xs23.dgn

PLOT SUBMITTED: 24-JUL-1998 15:11

307XS23.DGN