CUY-71-0.00
OHIO
FHWA REGION 5
158
361

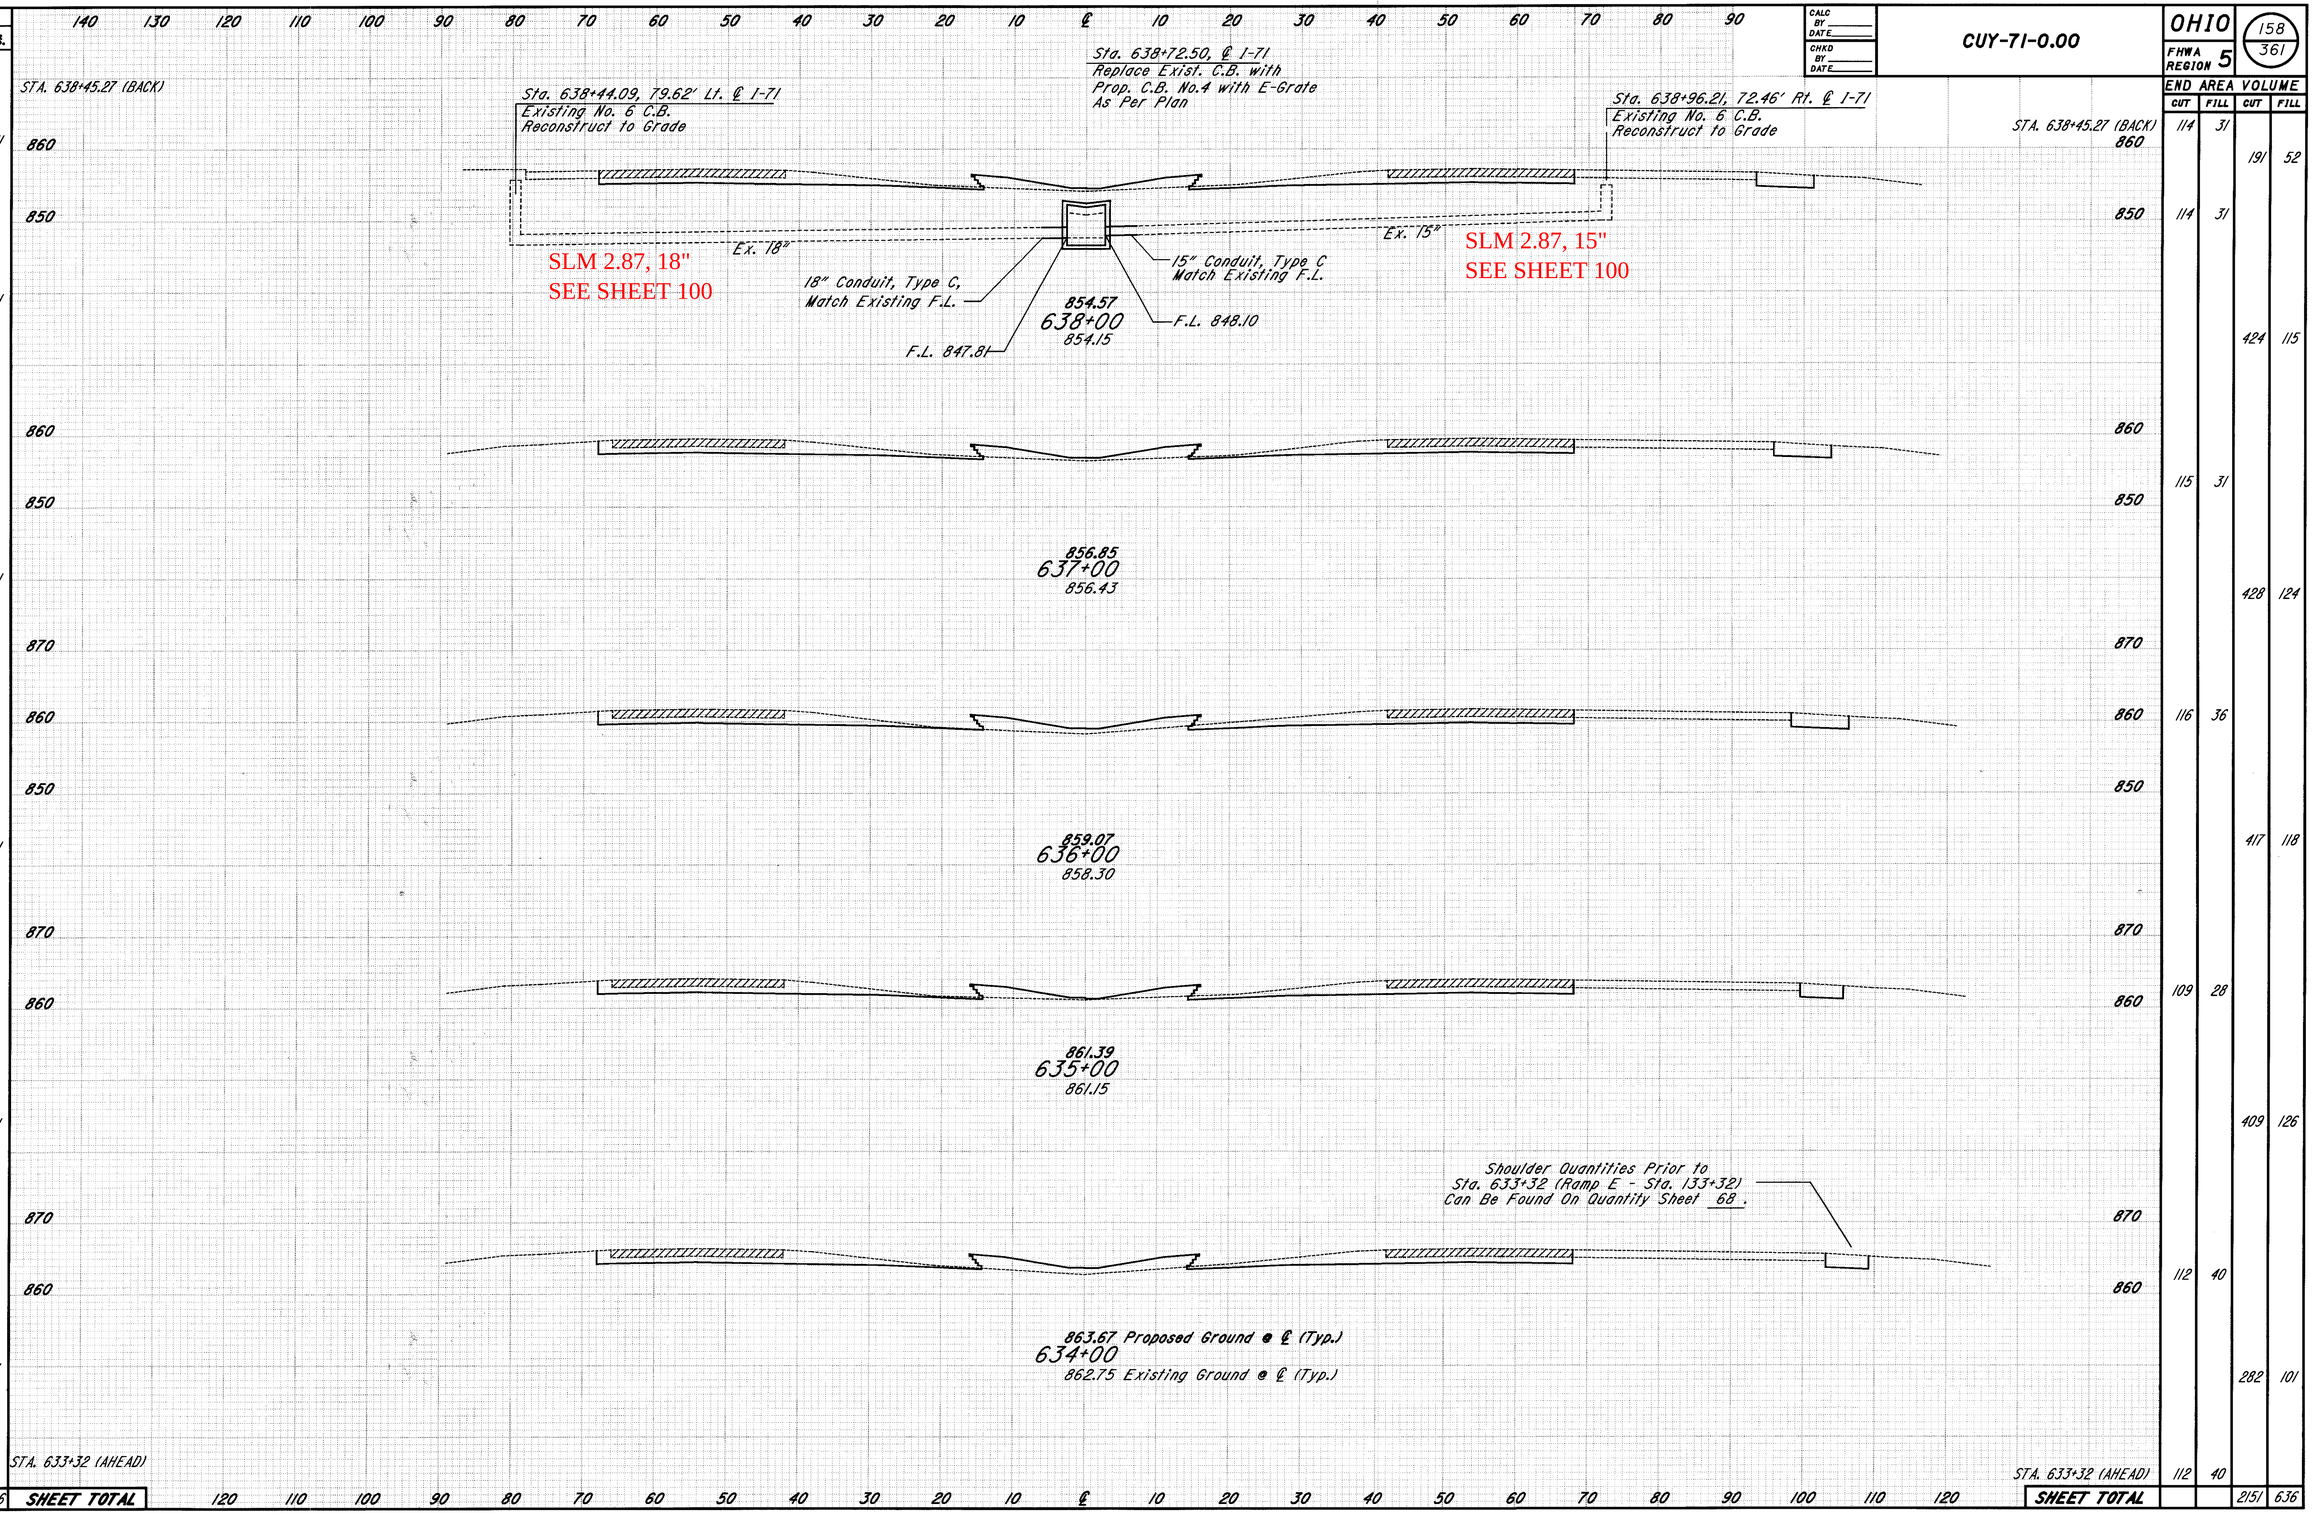

CROSS SECTIONS STA. 634+00 TO STA. 638+00

PLOTTED BY:jgrmovse
PLOTTED F:\Users\Beforsber\Bpid08459\Bdgn\B307xs31.dgn
PLOT SUBMITTED: 24-JUL-1998 15:11
307XS31.DGN