



PLOTTED FROM: Reforsber@p1d08459@dan@307xs33.dgn
 PLOT SUBMITTED: 24-JUL-1998 15:11
 307XS33.DGN

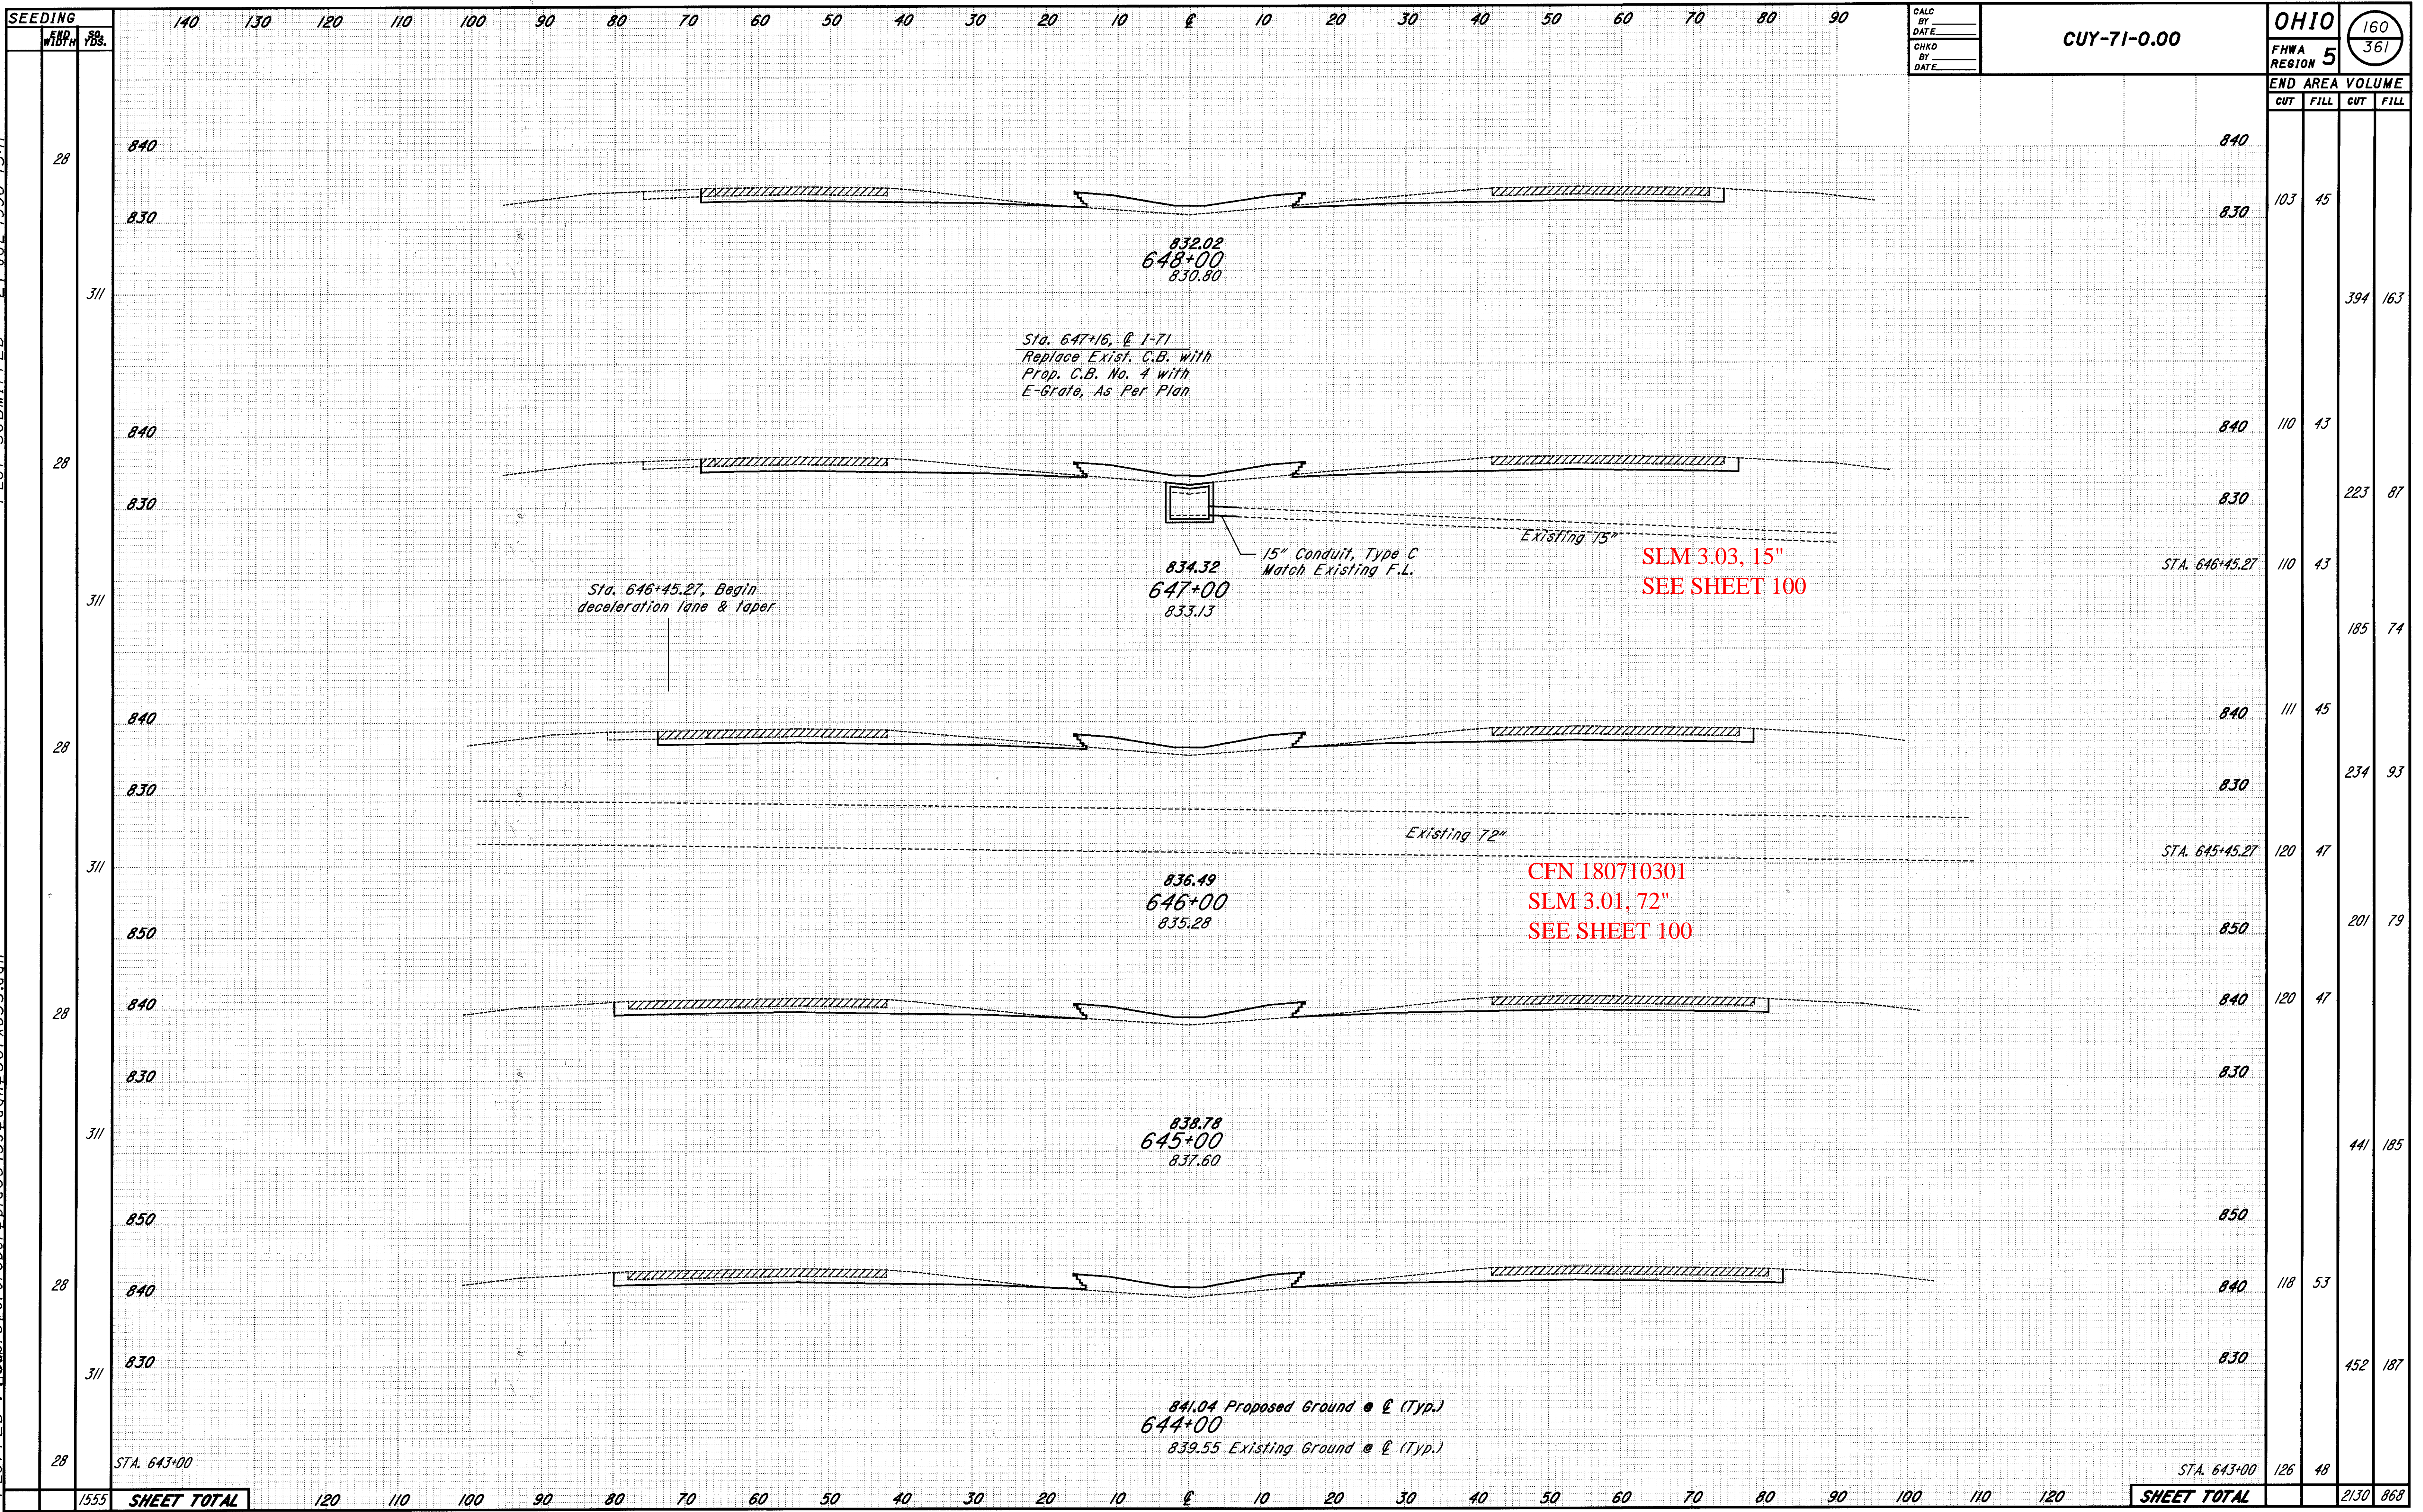

CROSS SECTIONS STA. 644+00 TO STA. 648+00