

SEEDING

140 130 120 110 100 90 80 70 60 50 40 30 20 10 0 10 20 30 40 50 60 70 80 90

CALC BY: \_\_\_\_\_  
DATE: \_\_\_\_\_  
CHKD BY: \_\_\_\_\_  
DATE: \_\_\_\_\_


CUY-71-0.00

OHIO  
FHWA REGION 5  
161  
361

END AREA VOLUME

CUT	FILL	CUT	FILL
100	36		
		372	148
101	44		
		368	176
98	51		
		374	183
104	48		
		370	196
96	58		
		368	191
103	45		
		1852	894

PLOTTED FROM: \\users\eforsber\pid08459\dgn\307xs34.dgn  
PLOT SUBMITTED: 24-JUL-1998 15:11  
307XS34.DGN

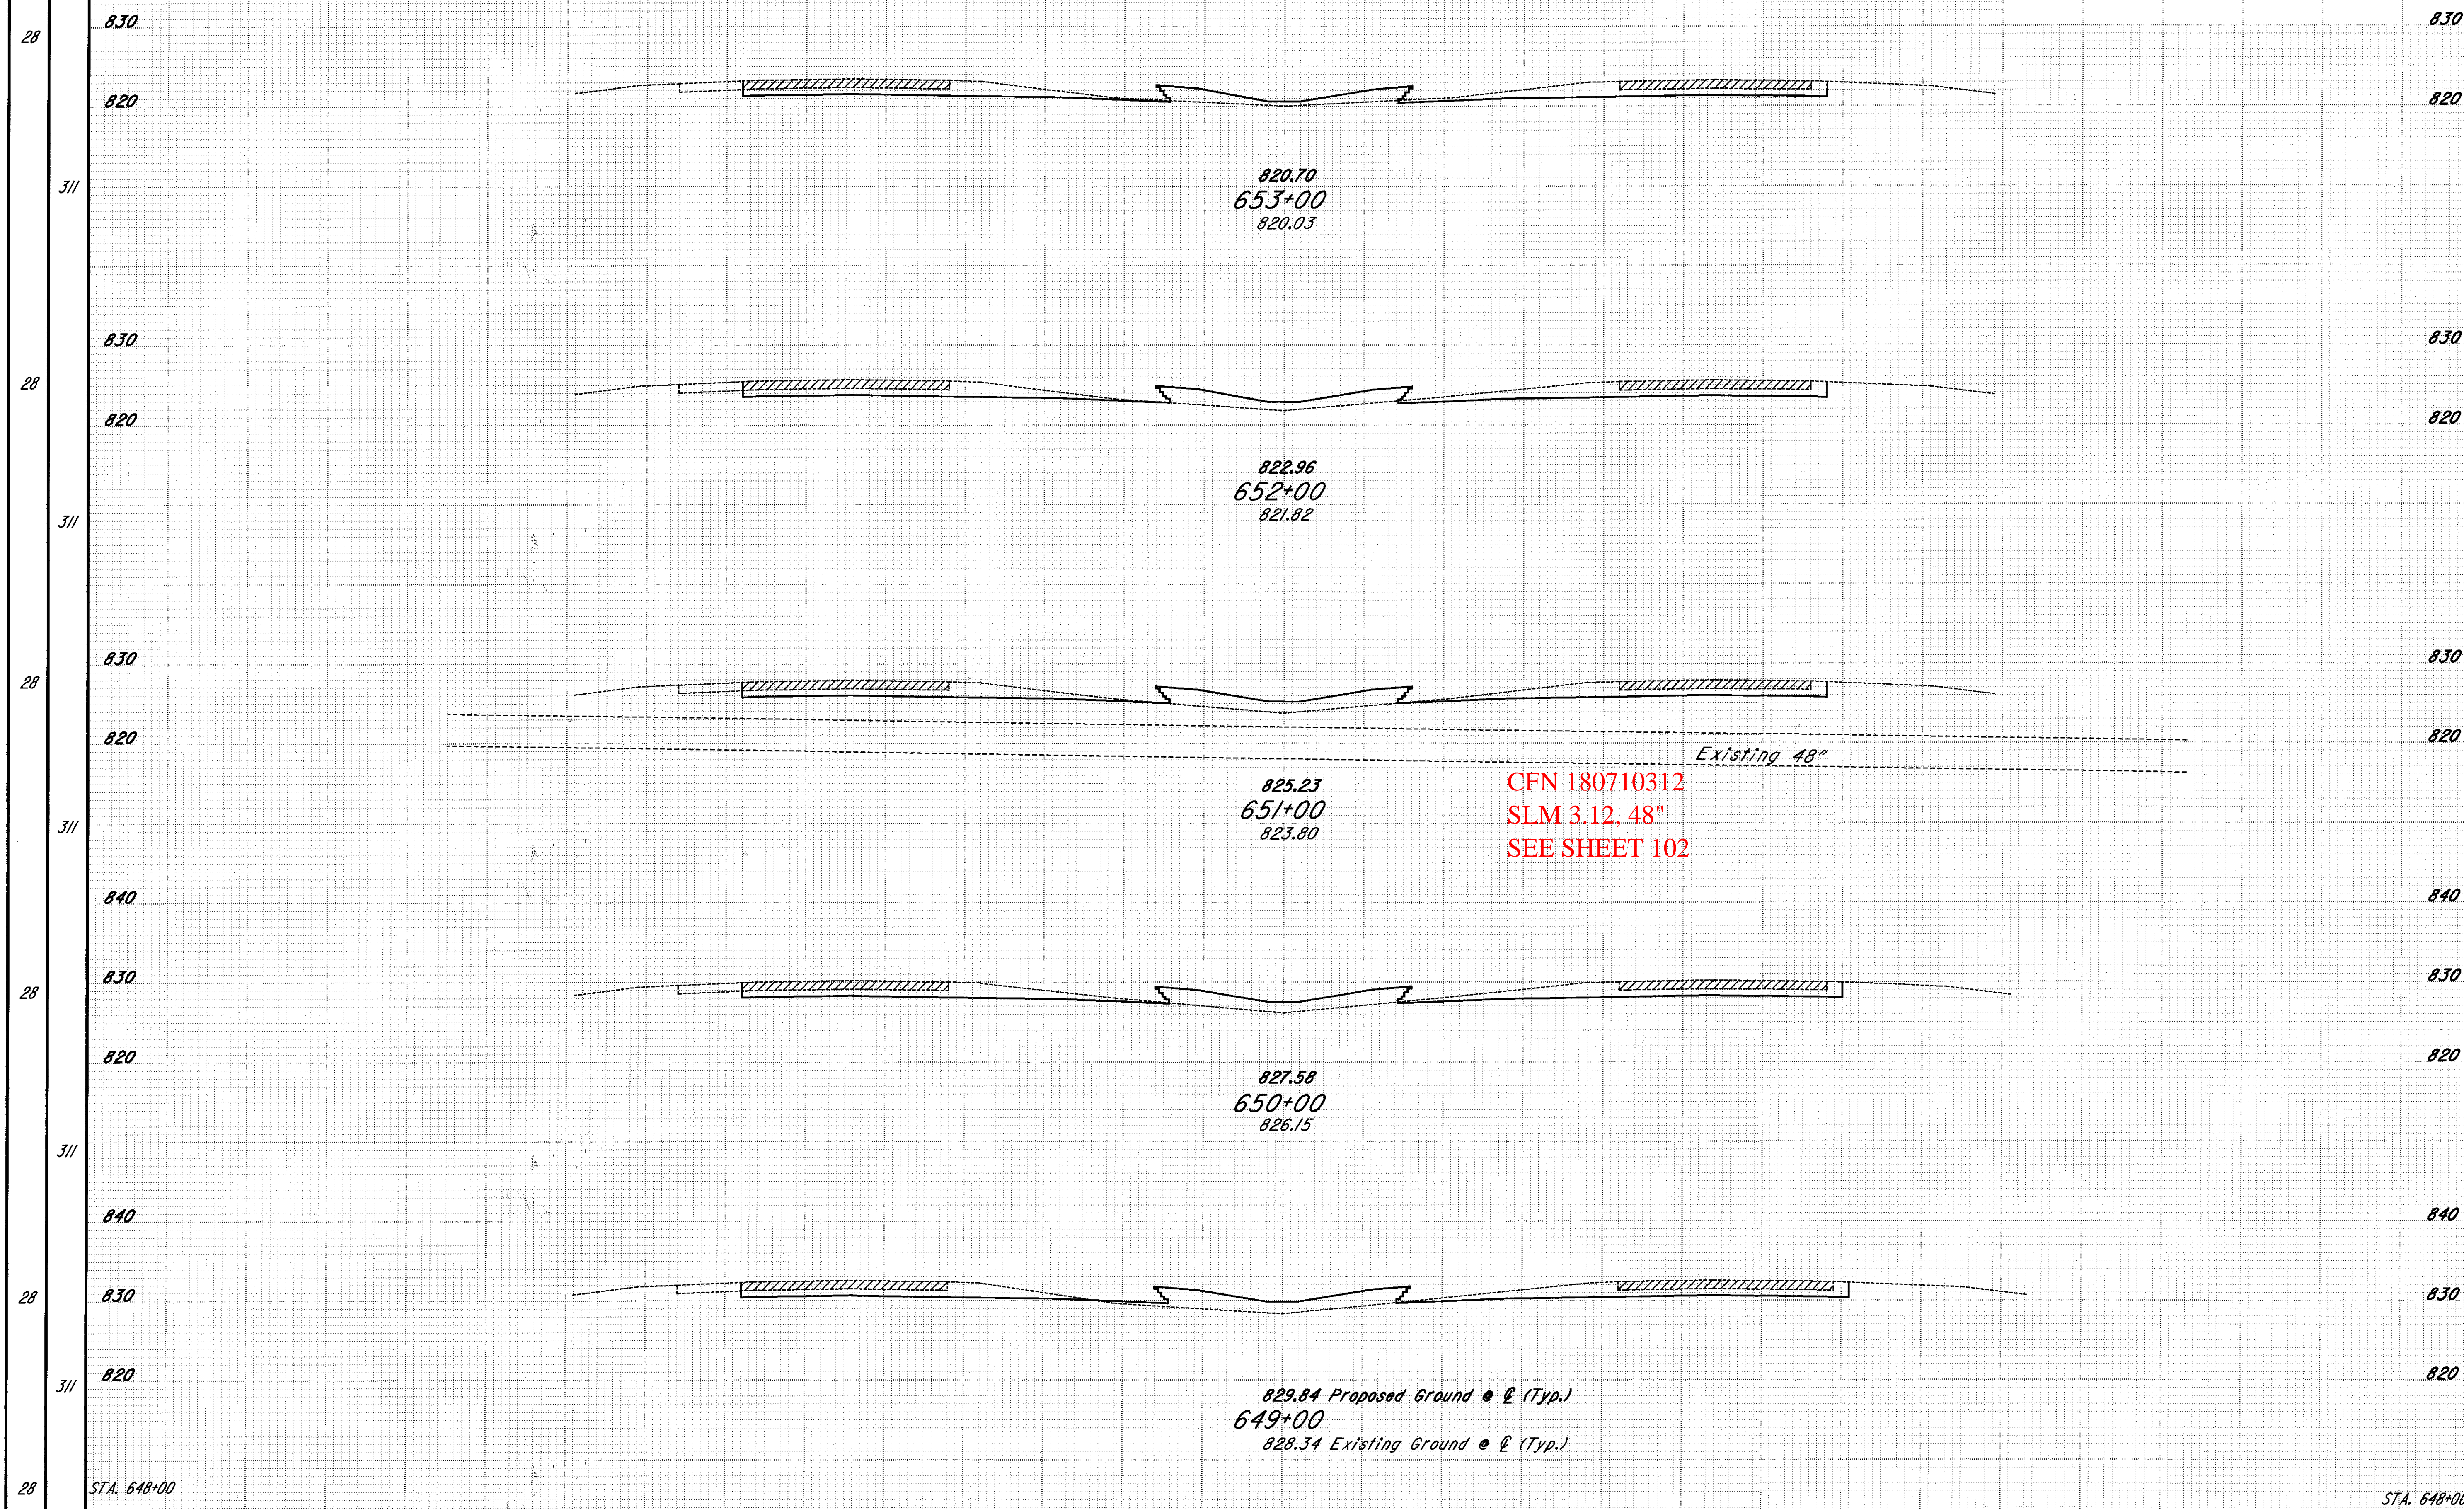

CFN 180710312  
SLM 3.12, 48"  
SEE SHEET 102

829.84 Proposed Ground @ 0' (Typ.)  
649+00  
828.34 Existing Ground @ 0' (Typ.)

STA. 648+00

STA. 648+00

SHEET TOTAL

SHEET TOTAL

CROSS SECTIONS STA. 649+00 TO STA. 653+00