

SEEDING

W/BP %

88%

140 130 120 110 100 90 80 70 60 50 40 30 20 10 0 10 20 30 40 50 60 70 80 90

CALC BY
DATE
CHKD BY
DATE


CUY-71-0.00

OHIO 170
FHWA REGION 5 361

END AREA VOLUME
CUT FILL CUT FILL

PLOTTED FROM: P:\0\mrs\eforsber\p\id08459\dgn\307xs43.dgn PLOT SUBMITTED: 24-JUL-1998 15:11 307XS43.DGN

28
311
28
48
28
48
28

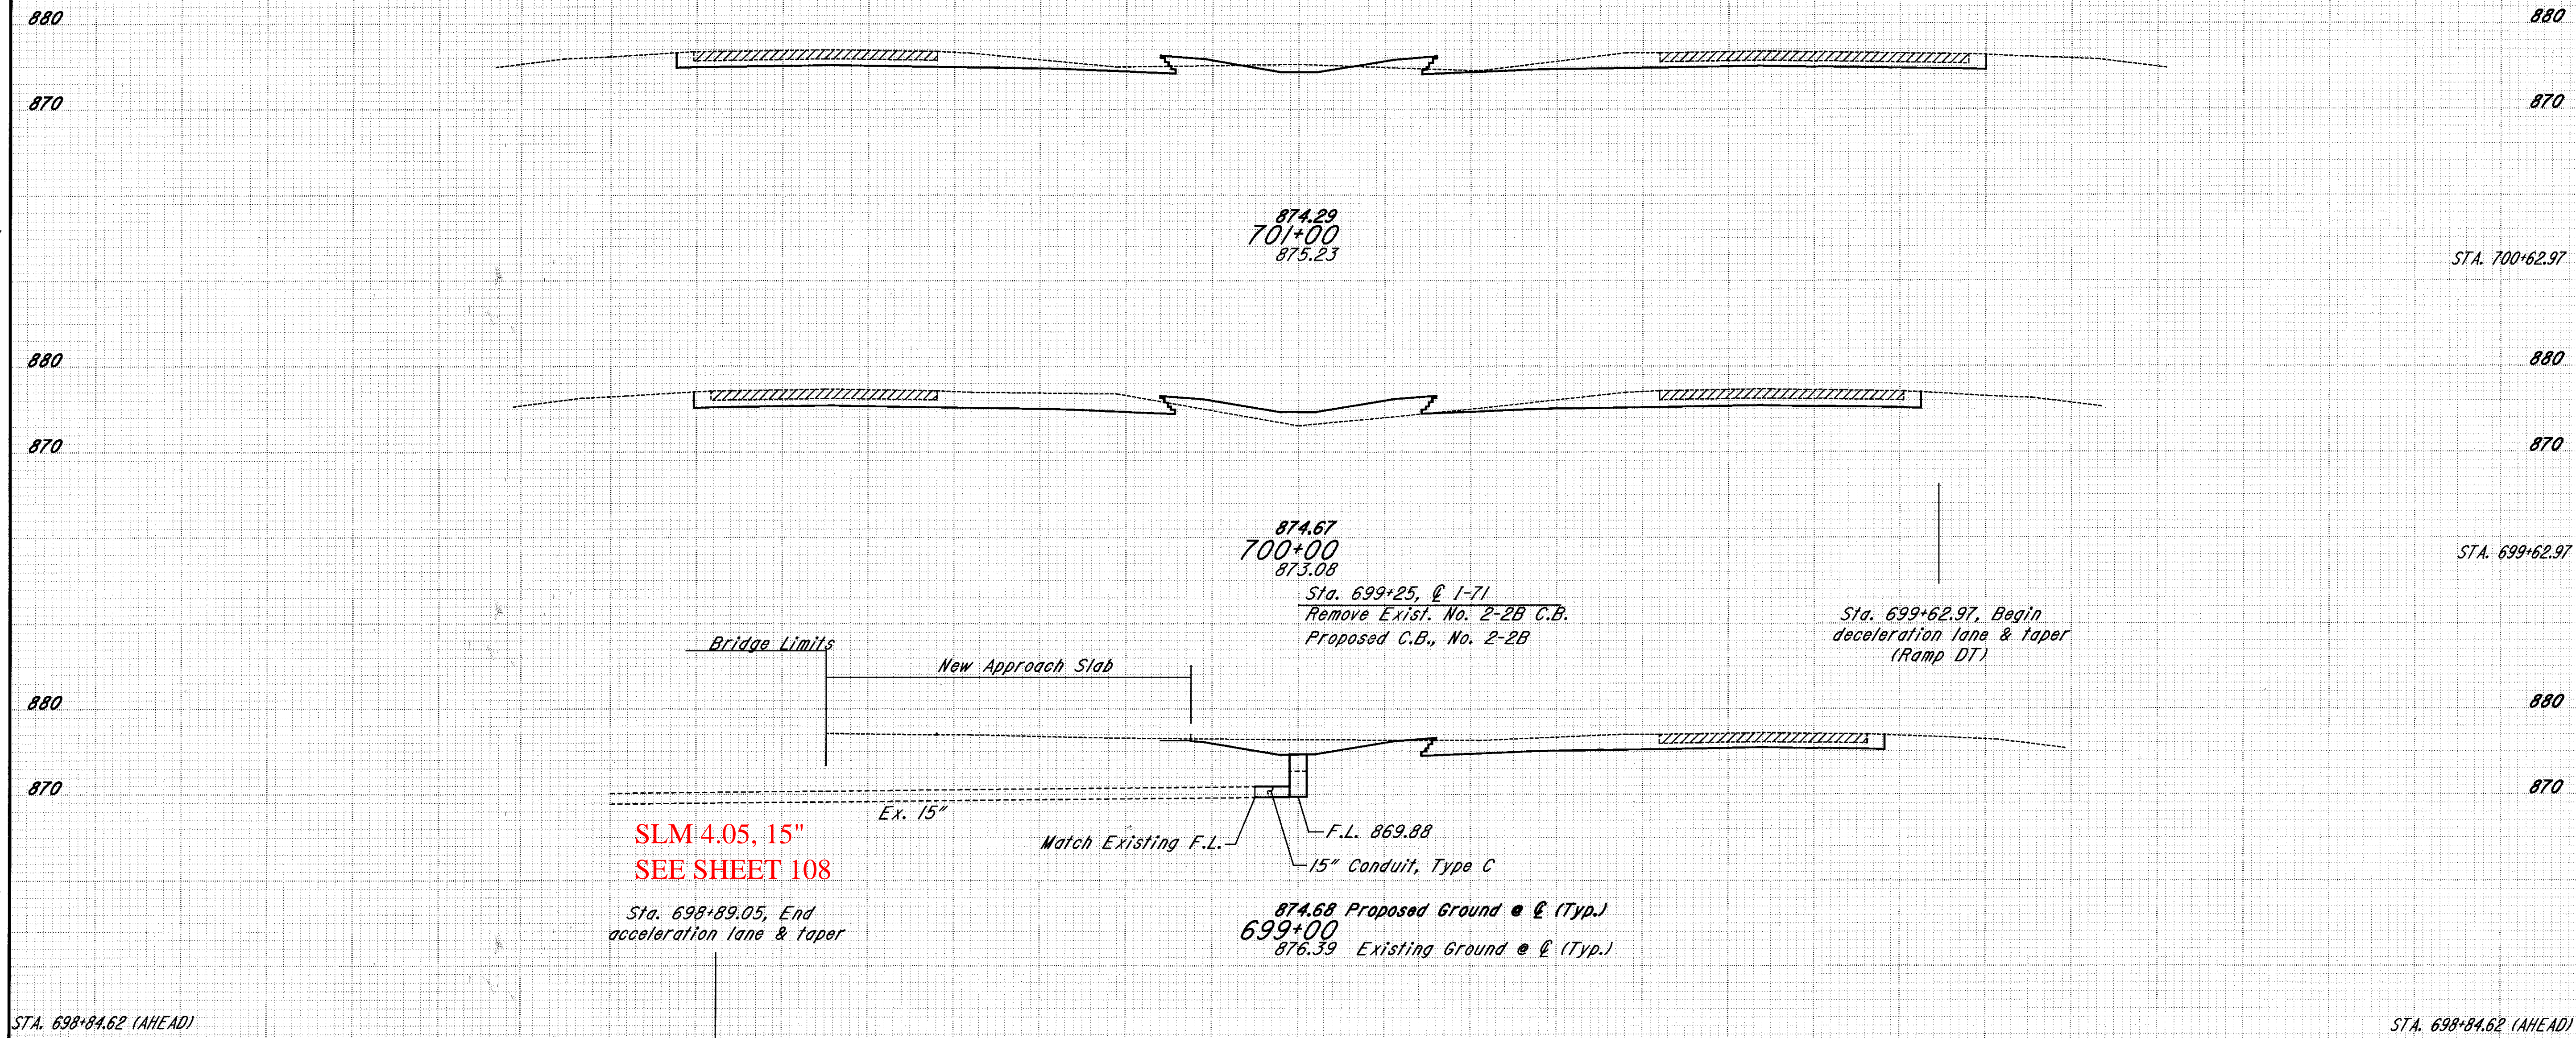

END AREA	VOLUME		
CUT	FILL	CUT	FILL
115	13		
115	13	453	106
130	44	286	66
120	26	71	20
63	26	213	61
63	26	36	15
63	26		

SLM 4.05, 15"
SEE SHEET 108

CUY-71-0395 BRIDGE
Station 698+84.62

407 SHEET TOTAL 120 110 100 90 80 70 60 50 40 30 20 10 0 10 20 30 40 50 60 70 80 90 100 110 120 SHEET TOTAL

1059 268

CROSS SECTIONS STA. 699+00 TO STA. 701+00