


PLOTTED FROM: I:\users\eforsber\p\d08459\dgn\307xs50.dgn
 PLOT SUBMITTED: 24-JUL-1998 15:11
 307XS50.DGN

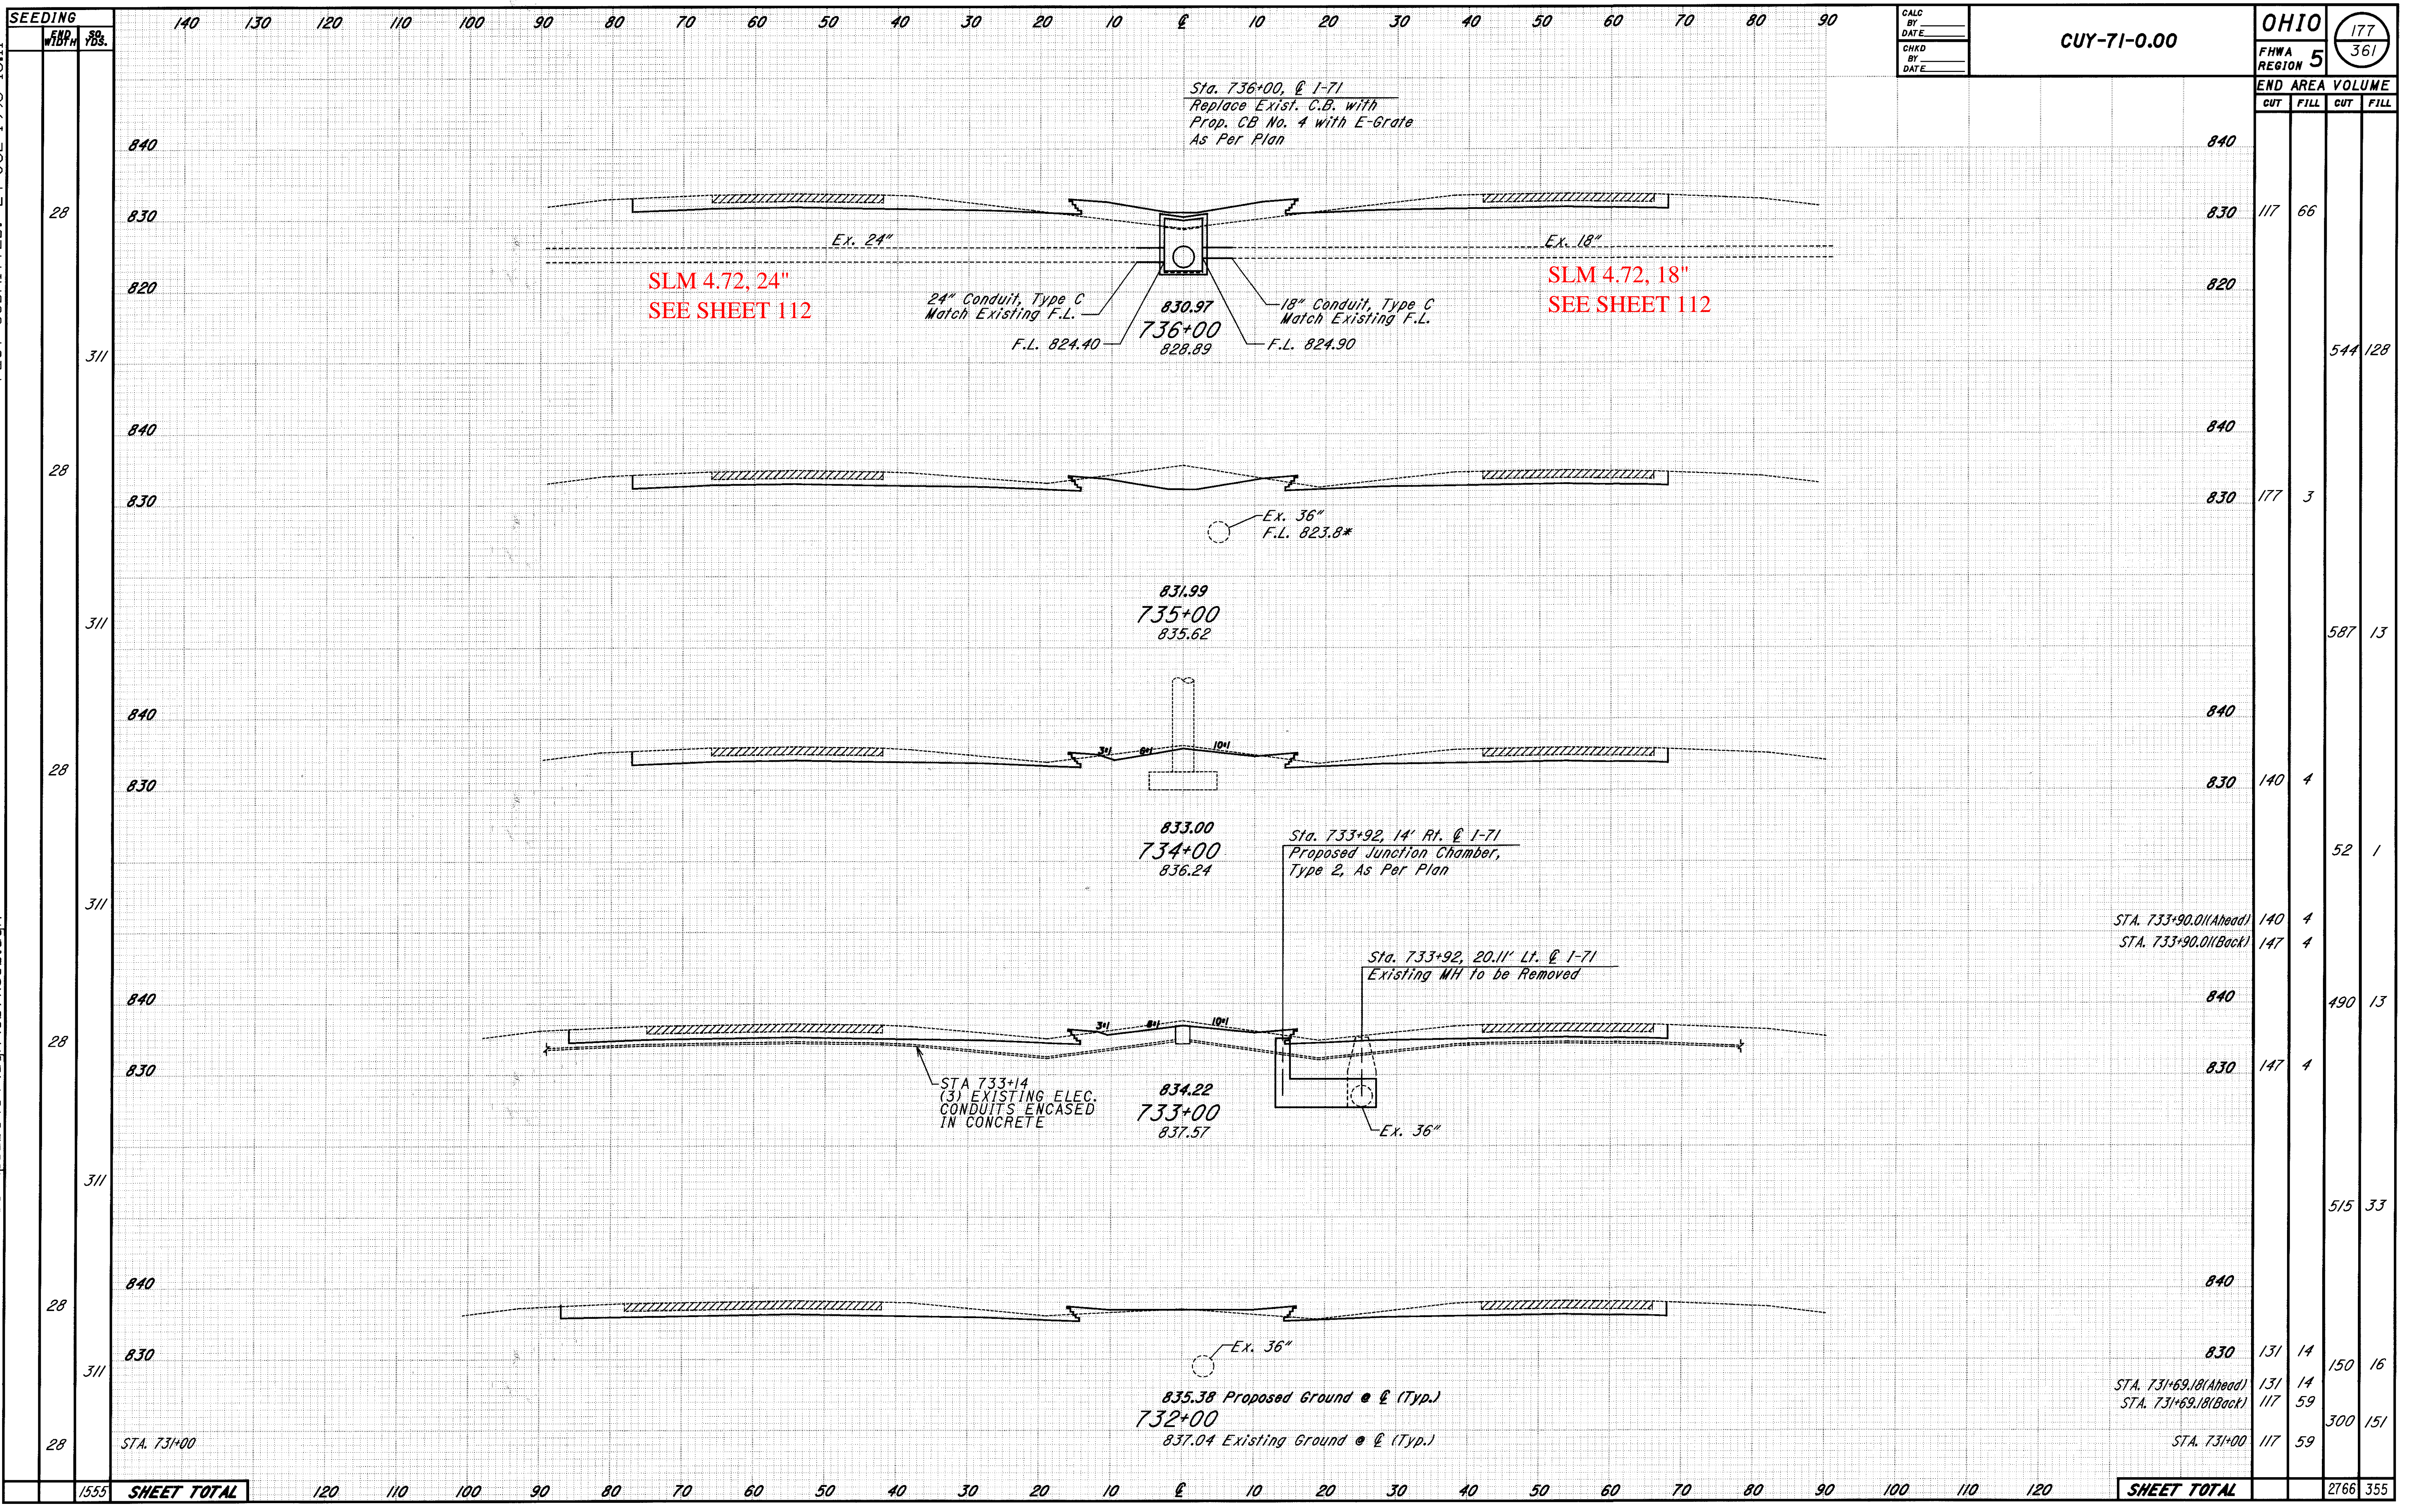

CALC BY		OHIO FHWA REGION 5	177 361
DATE			
CHKD BY			

CUY-71-0.00

END STA	END AREA		VOLUME	
	CUT	FILL	CUT	FILL
840				
830	117	66		
820			544	128
840				
830	177	3		
840			587	13
830	140	4		
840			52	1
840	140	4		
830	147	4		
840			490	13
830	147	4		
840			515	33
830	131	14		
840	131	14	150	16
830	117	59		
840			300	151
830	117	59		
SHEET TOTAL			2766	355

CROSS SECTIONS STA. 732+00 TO STA. 736+00