


SEEDING  
 END  
 WIDTH  
 785.  
 24-JUL-1998 15:11  
 PLOT SUBMITTED: 24-JUL-1998 15:11  
 307XS53.DGN  
 307xs53.dgn

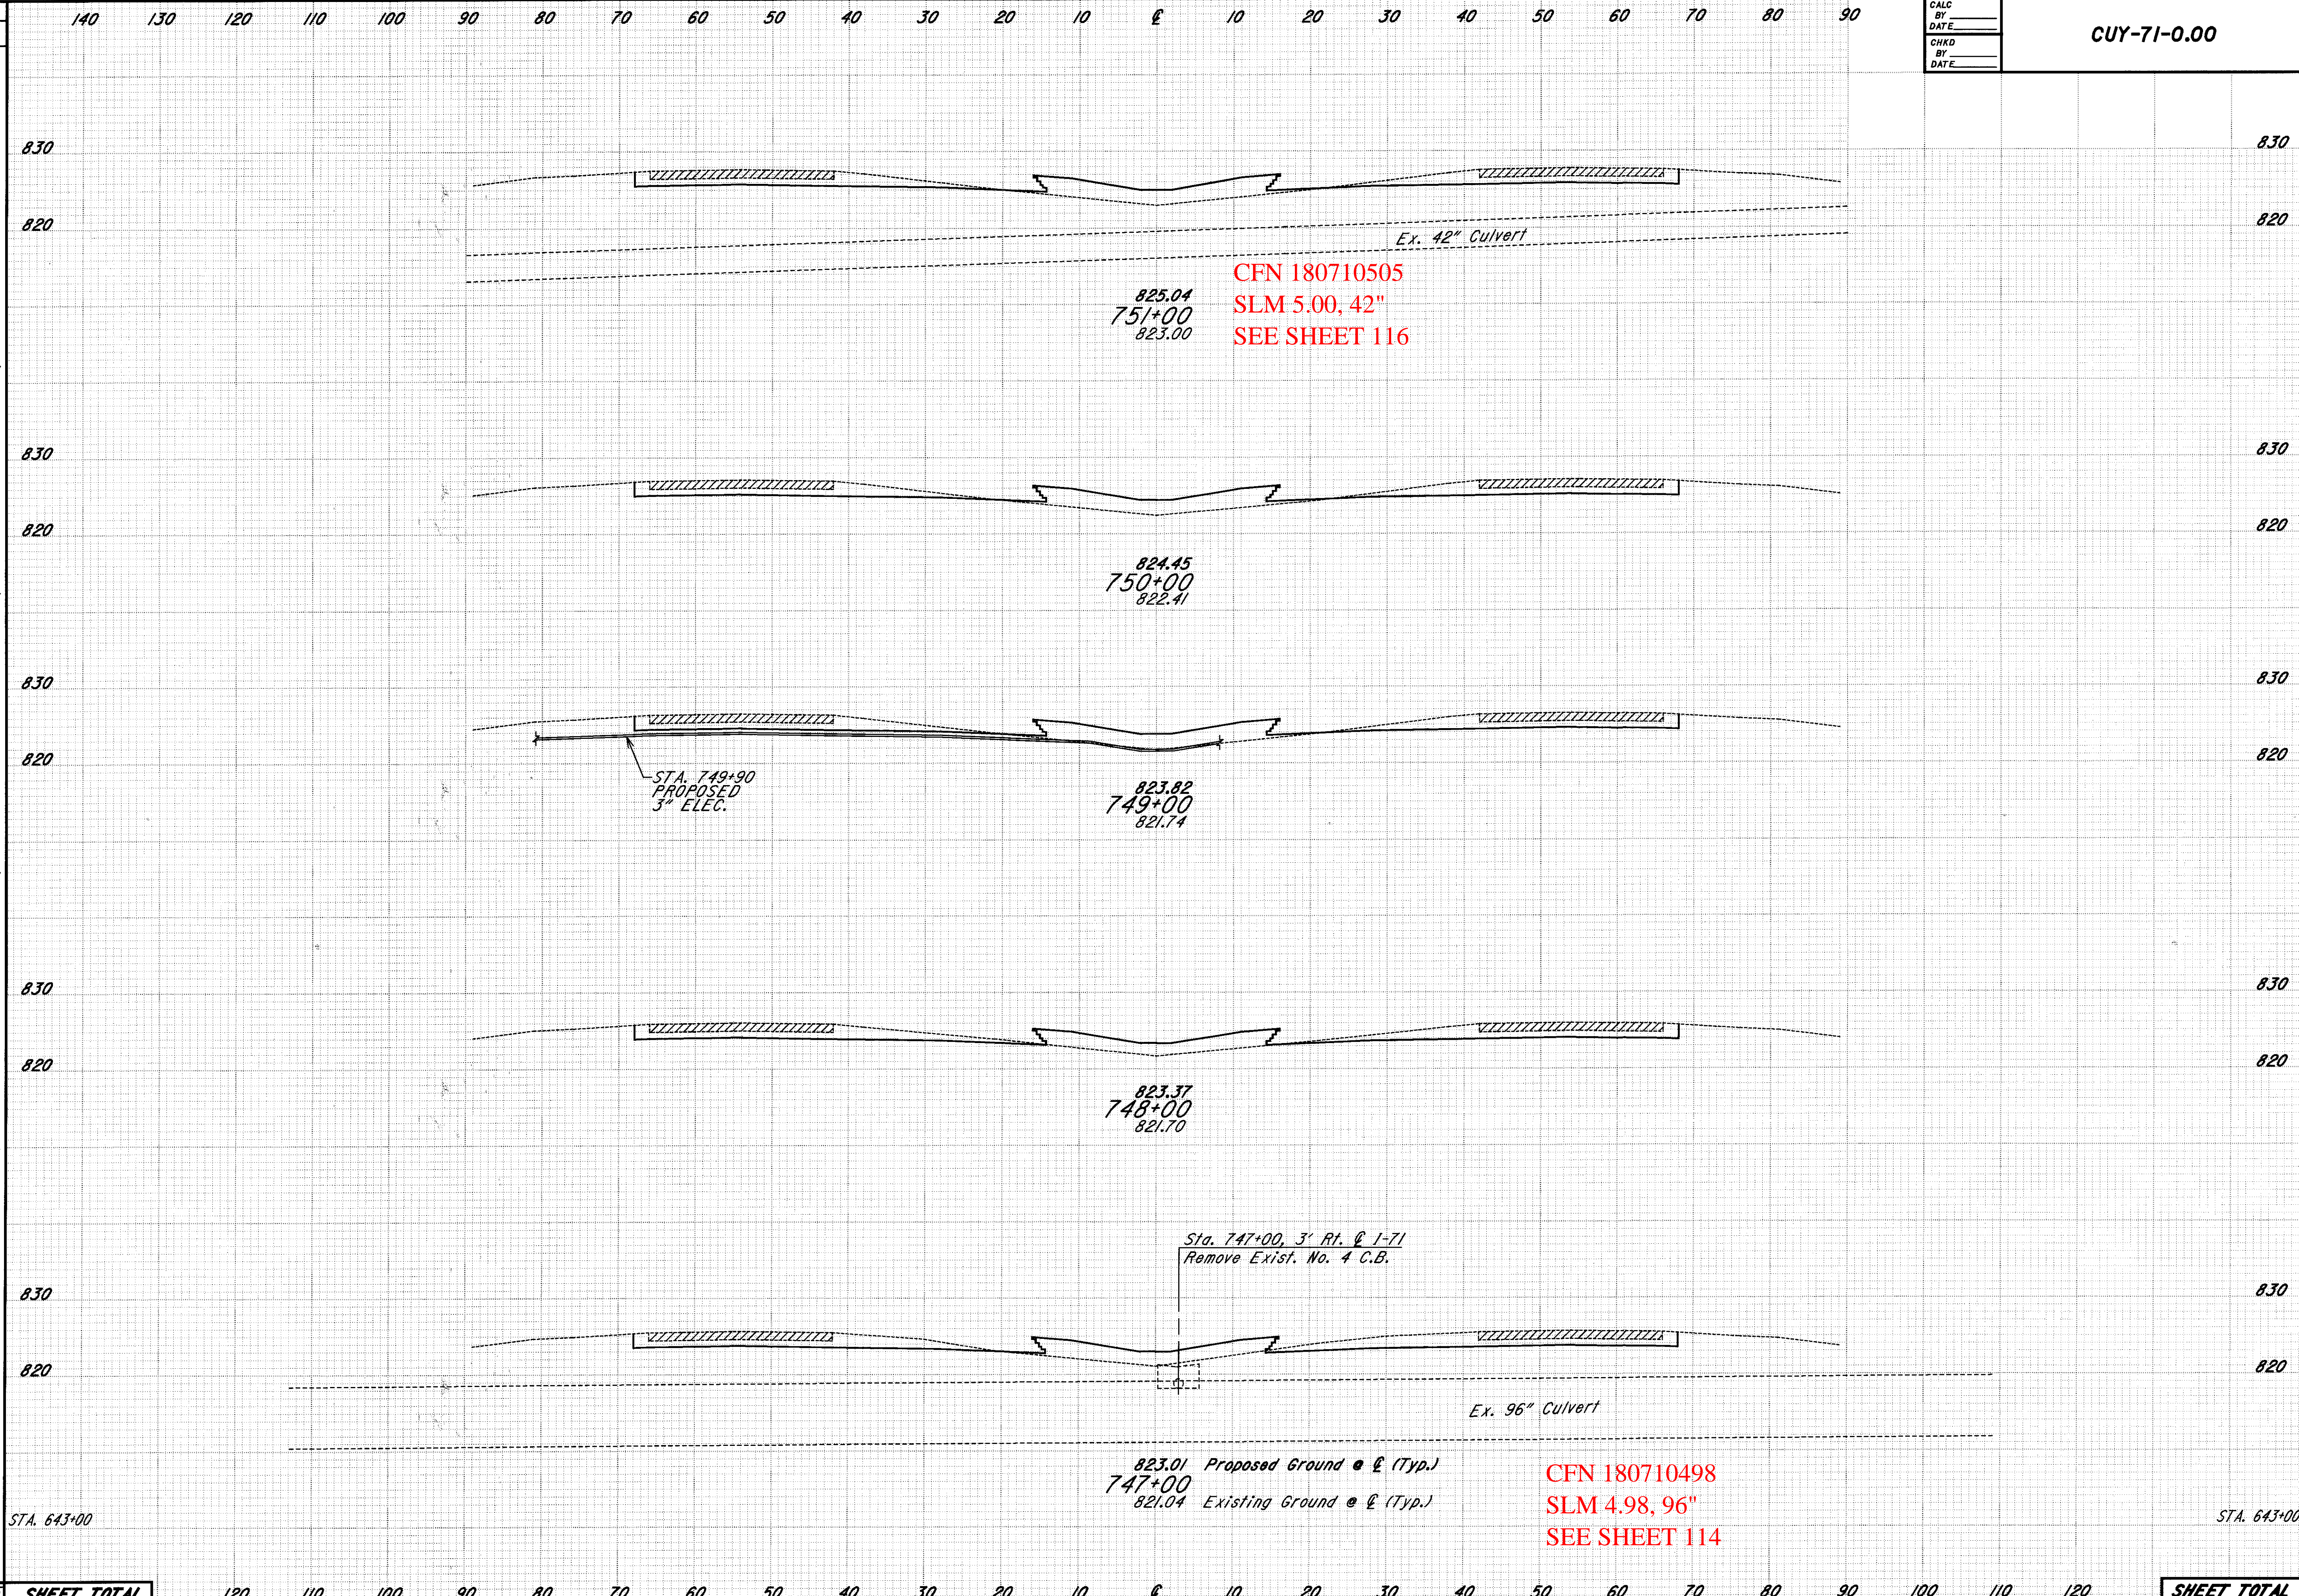

| END AREA           | VOLUME      |             |
|--------------------|-------------|-------------|
|                    | CUT         | FILL        |
| 830                |             |             |
| 820                | 93          | 67          |
| 830                |             |             |
| 820                | 87          | 68          |
| 830                |             |             |
| 820                | 88          | 68          |
| 830                |             |             |
| 820                | 98          | 54          |
| 830                |             |             |
| 820                | 110         | 59          |
| 830                |             |             |
| 820                | 112         | 60          |
| <b>SHEET TOTAL</b> | <b>1797</b> | <b>1157</b> |

| OHIO               |             |
|--------------------|-------------|
| FHWA REGION        | 5           |
| END AREA           | VOLUME      |
| CUT                | FILL        |
| 333                | 250         |
| 324                | 252         |
| 344                | 226         |
| 385                | 209         |
| 411                | 220         |
| <b>SHEET TOTAL</b> | <b>1797</b> |

CROSS SECTIONS STA. 747+00 TO STA. 751+00