


PLOTTED FROM: I:\users\eforsber\proj\08459\dgn\307xs56.dgn
 307XS56.DGN
 PLOT SUBMITTED: 24-JUL-1998 15:11

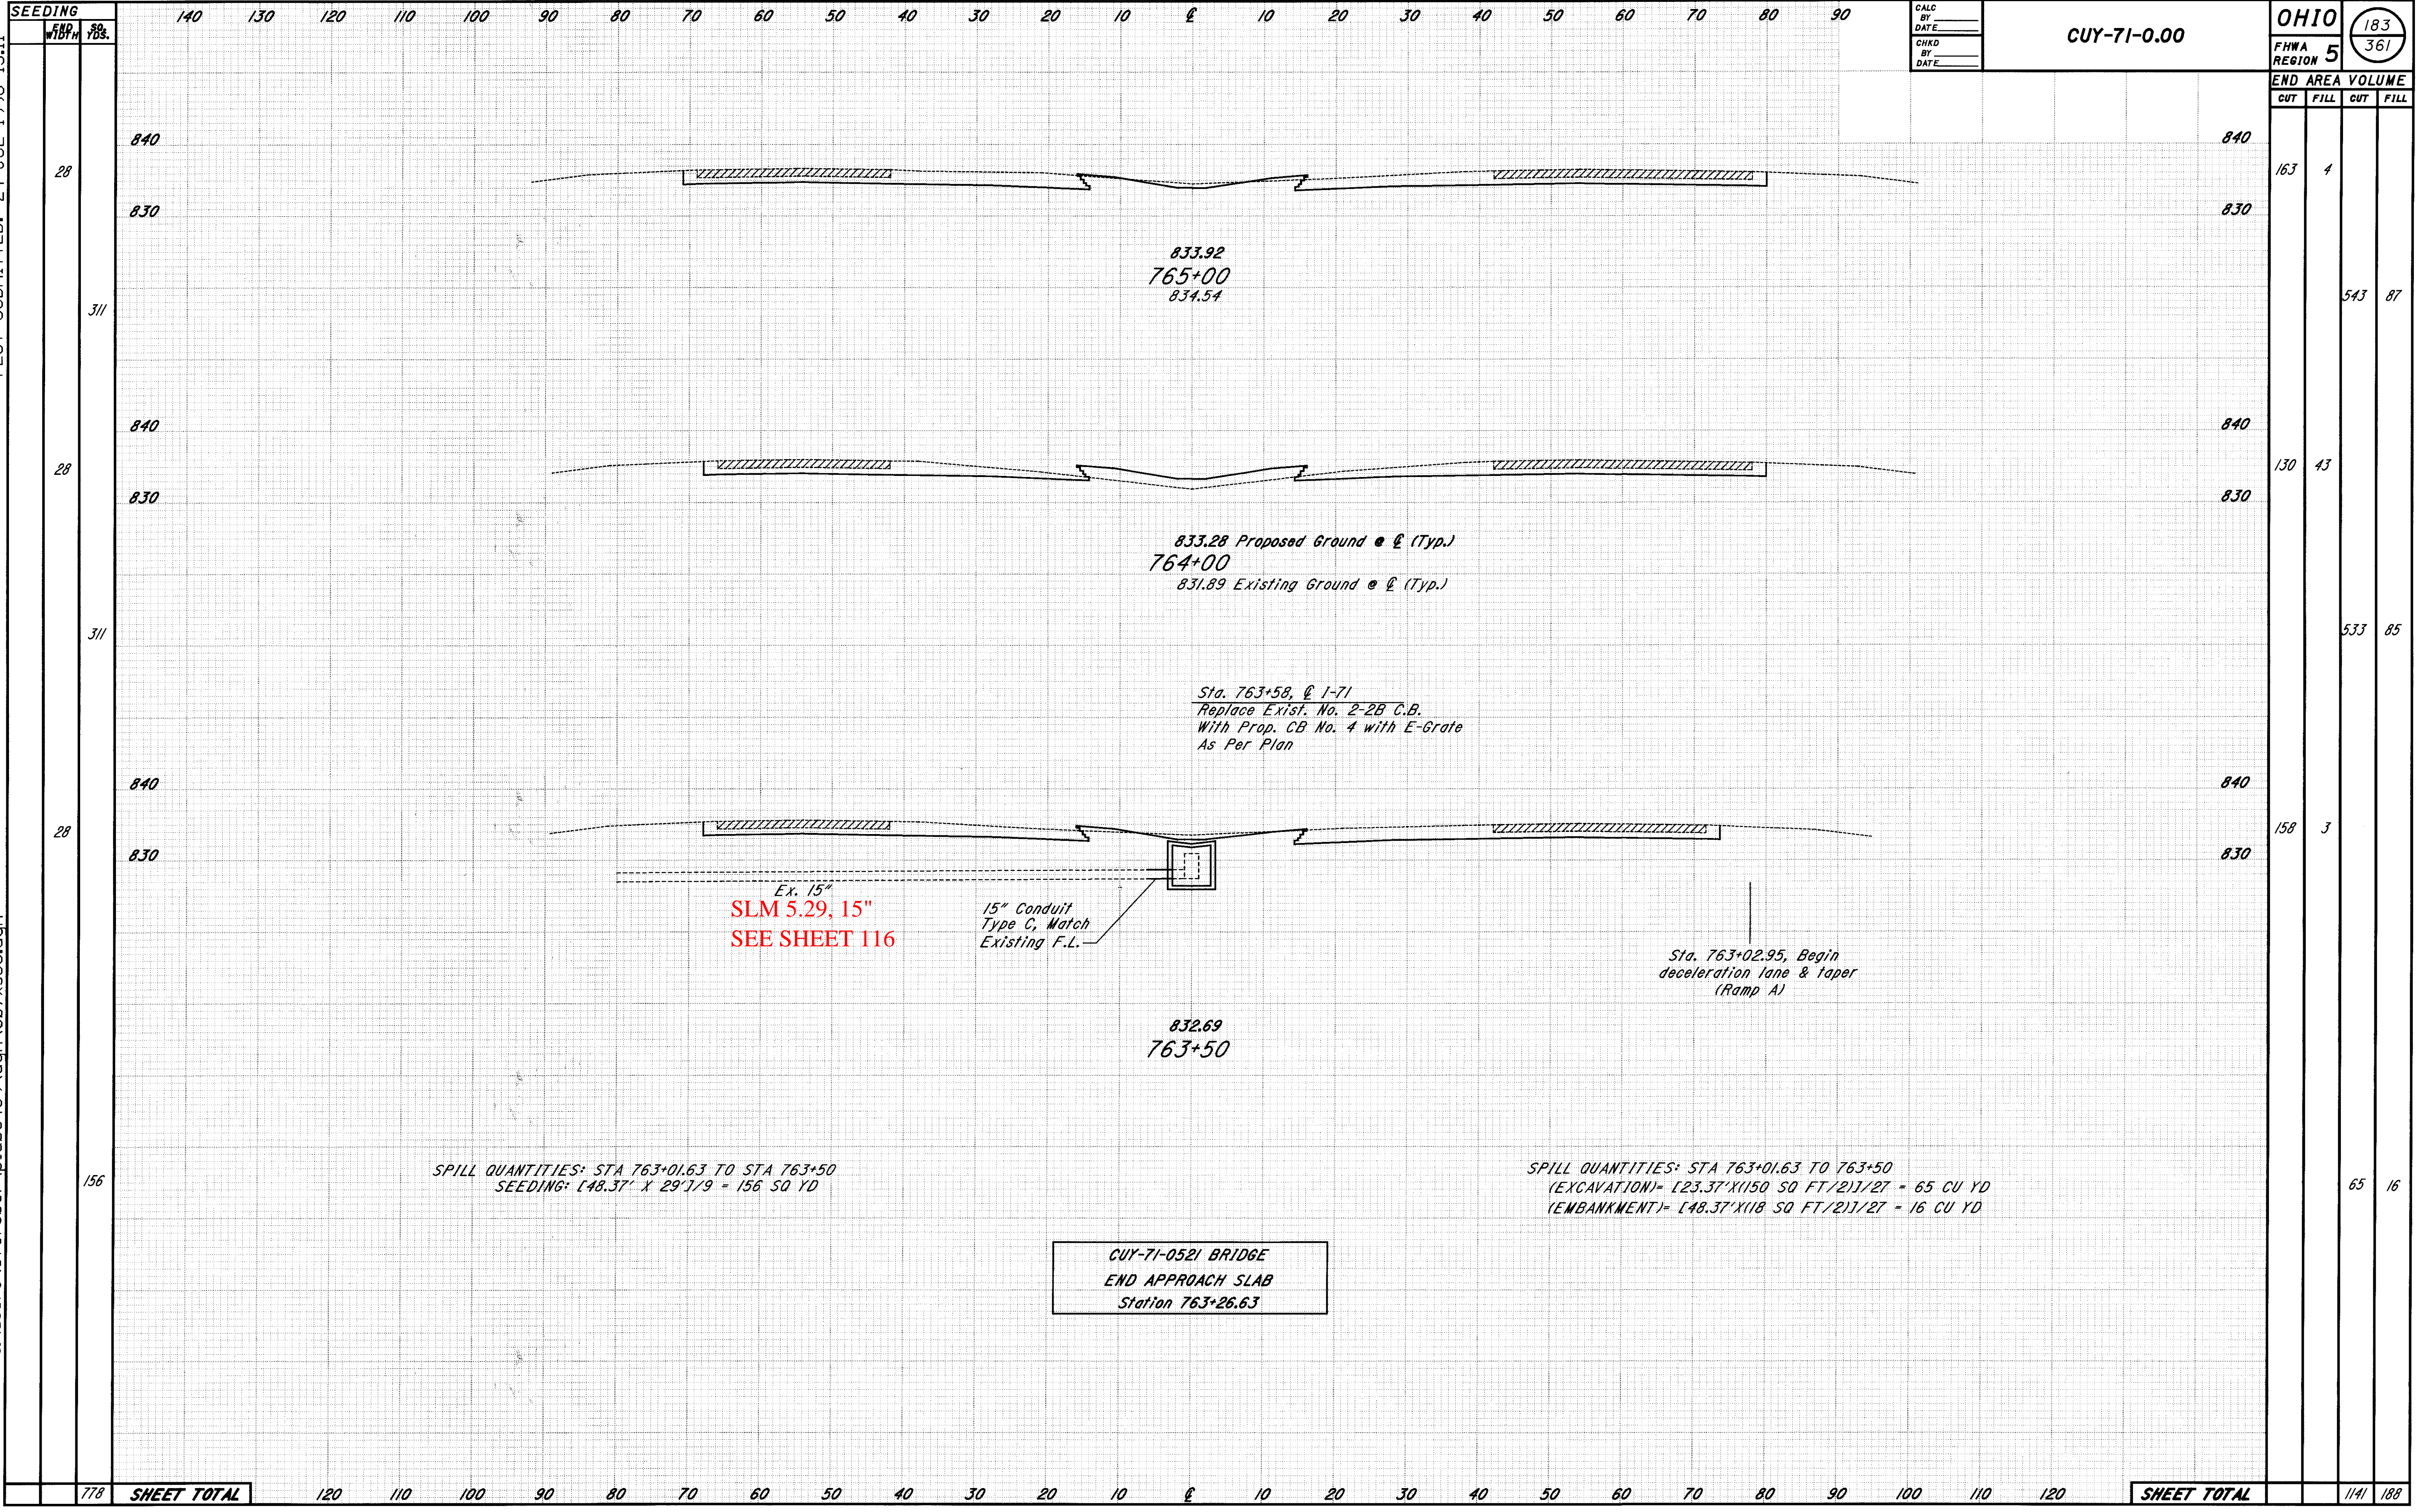

CROSS SECTIONS STA. 763+50 TO STA. 765+00