CUY-71-0.00
OHIO
FHWA REGION 5
184
361

CALC BY ____ DATE ____
CHKD BY ____ DATE ____

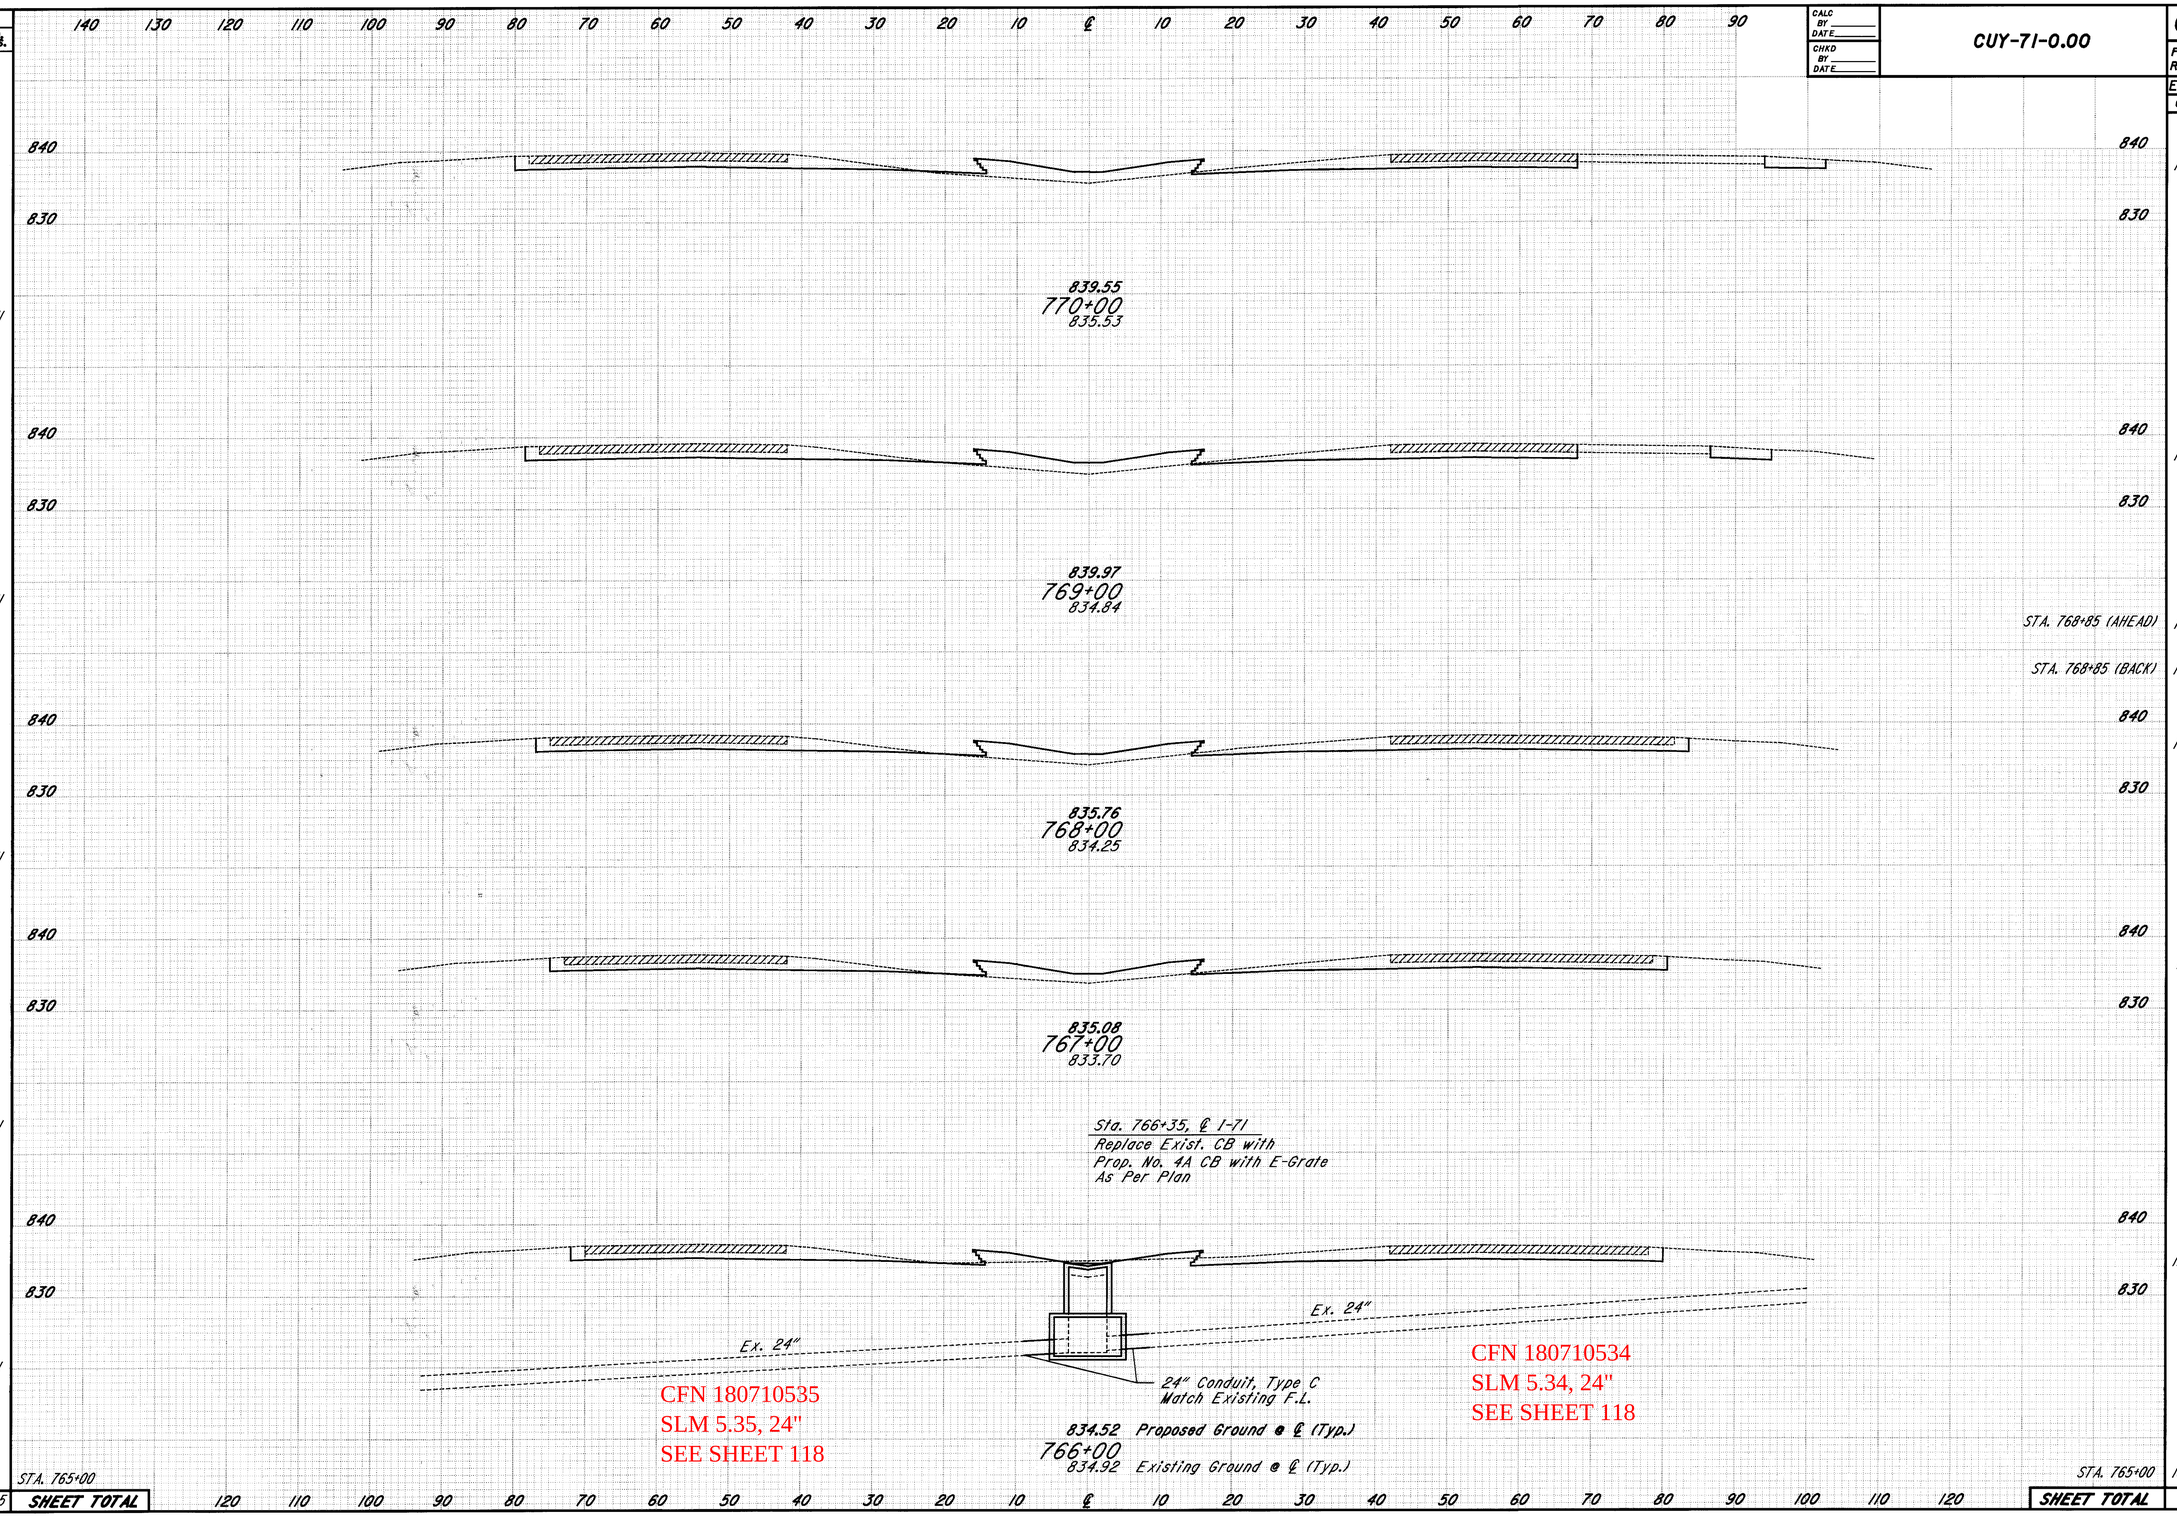

SEEDING	END WIDTH	SQ. YDS.	END AREA VOLUME CUT	FILL	CUT	FILL
	28		105	52		
		311			387	196
	28		104	54		
					58	30
		311				
			STA. 768+85 (AHEAD) 104	54		
			STA. 768+85 (BACK) 122	51		
					384	161
	28		122	51		
		311			433	189
	28		112	51		
		311			433	126
	28		122	17		
		311			528	39
	28		STA. 765+00 163	4		
		1555	SHEET TOTAL		2223	741

CROSS SECTIONS STA. 766+00 TO STA. 770+00

PLOTTED FROM Reforsberg pid08459 dgn B307xs57.dgn PLOT SUBMITTED: 24-JUL-1998 15:11

307XS57.DGN