


PLOTTED FROM: sber@pid08459@dgnw307xs60.dgn  
 307XS60.DGN  
 01/24/2017 10:11:11 AM  

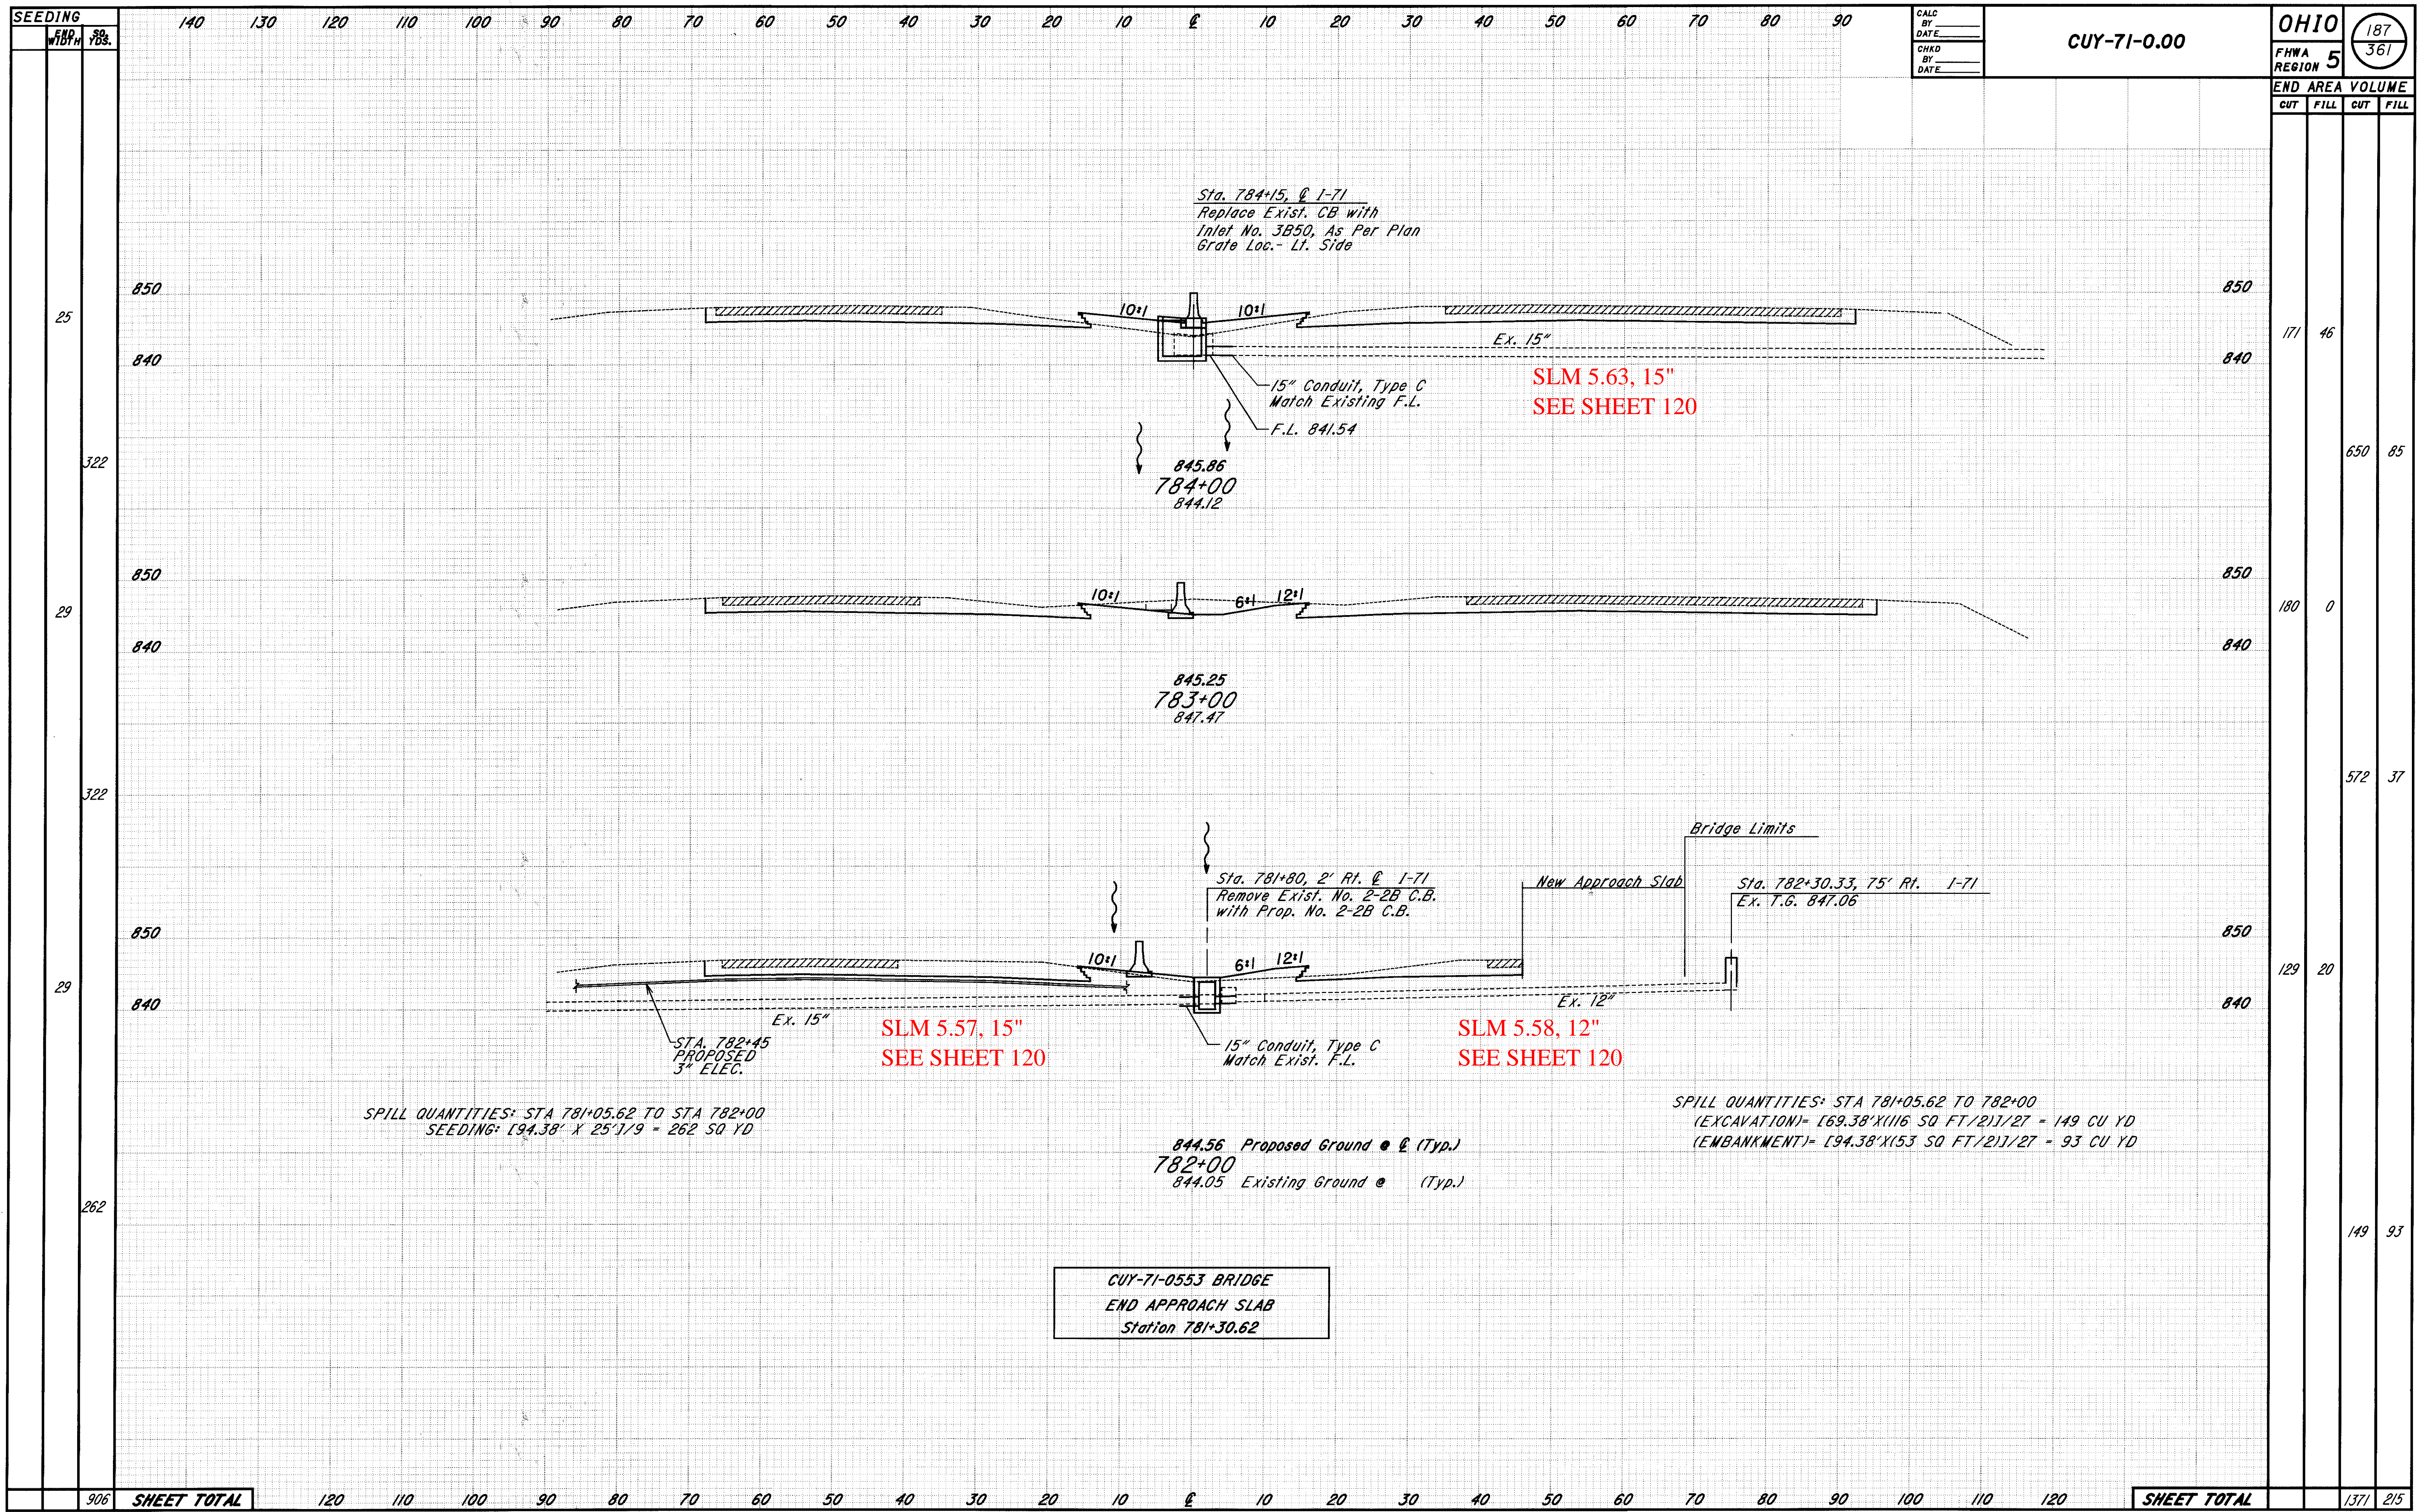

CROSS SECTIONS STA. 782+00 TO STA. 784+00