


SEEDING
END SQ.
WIDTH YDS.

130
263
CUYAHOGA COUNTY
CUY-42-3.38

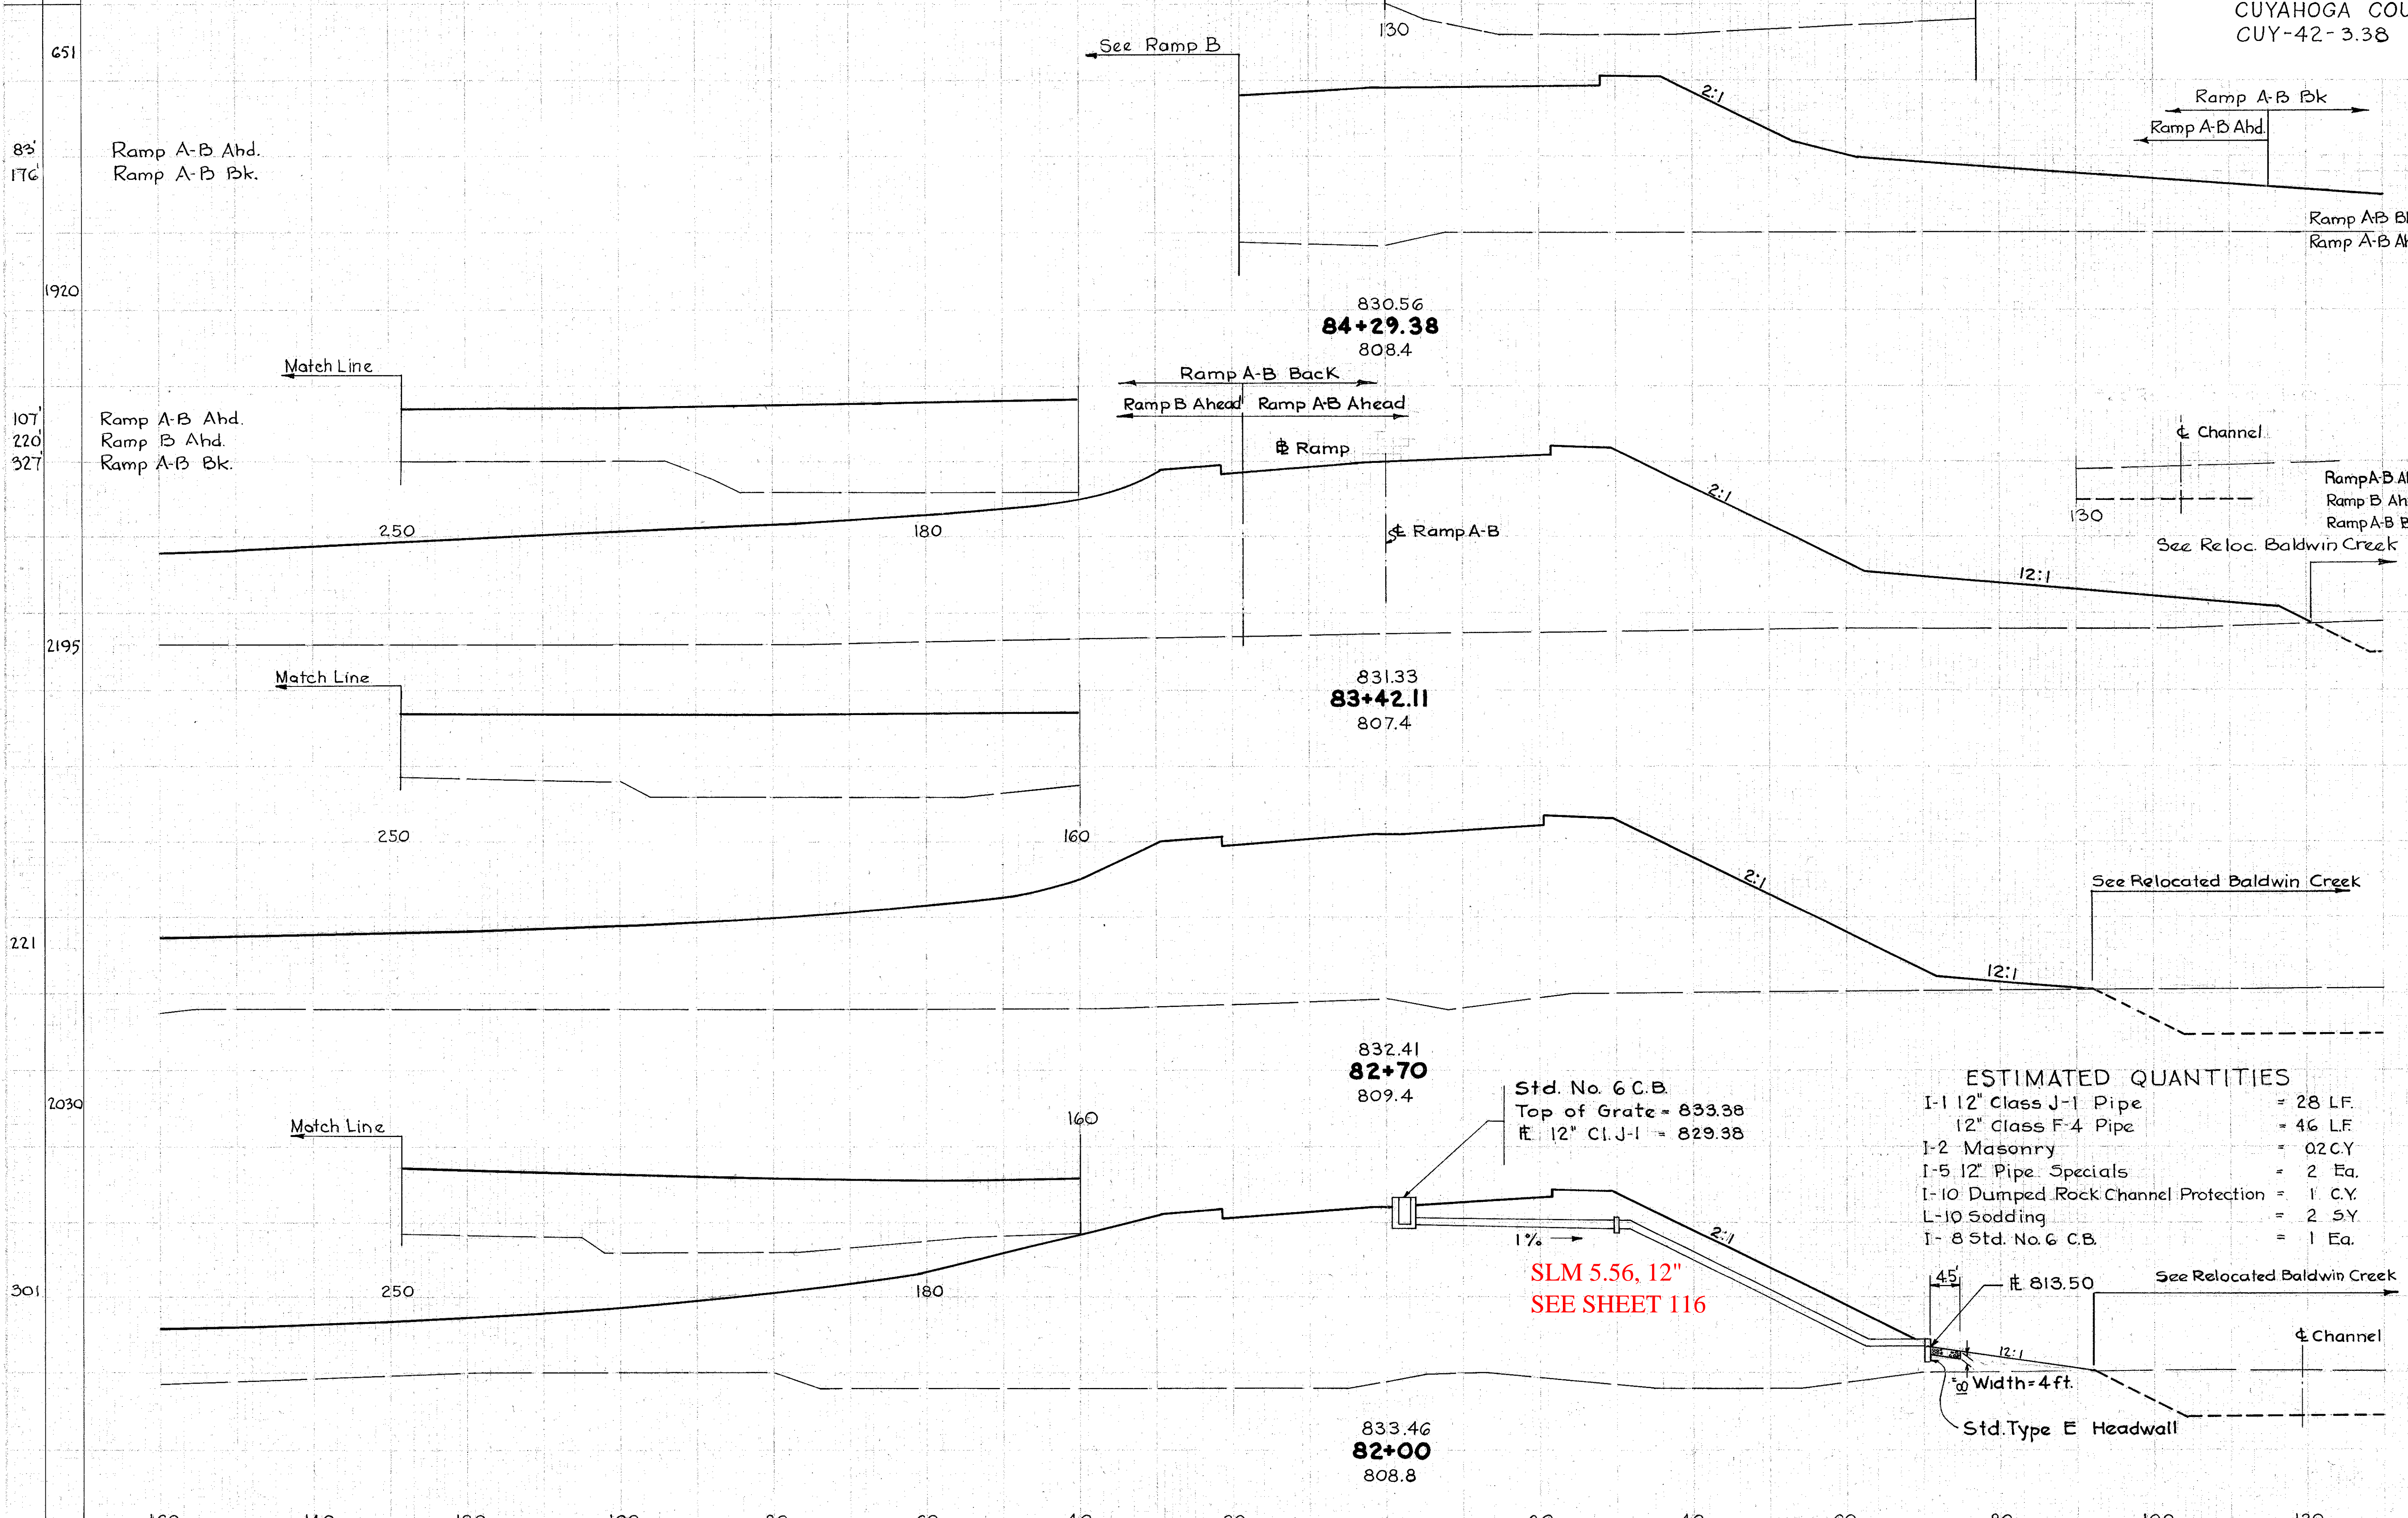

END AREA		Cu. Yds.	
CUT	FILL	CUT	FILL
0	2480	0	3623
0	550	0	
0		0	7289
0	2031	0	
0	3095	0	
0	5126	0	
0		0	12739
0	4414	0	
0		0	11454
0	4423	0	

- ESTIMATED QUANTITIES**
- I-1 12" Class J-1 Pipe = 28 LF.
 - I-2 12" Class F-4 Pipe = 46 LF.
 - I-2 Masonry = 02 CY
 - I-5 12" Pipe Specials = 2 Ea.
 - I-10 Dumped Rock Channel Protection = 1 CY.
 - L-10 Sodding = 2 SY.
 - I-8 Std. No. 6 C.B. = 1 Ea.

Std. No. 6 C.B.
Top of Grate = 833.38
E 12" Cl. J-1 = 829.38

SLM 5.56, 12"
SEE SHEET 116