CUYAHOGA COUNTY
CUY - 42 - 3.38

				26 / 263
2	0410	I-71-5(11)236		

CFN 180710468
SLM 4.68, 36"
SEE BELOW

SLM 4.64, 36"
SEE BELOW

WHITNEY ROAD
SLM 4.67 = MM 233.38

SLM 4.80, 42"
SEE BELOW

SLM 4.58, 30"
SEE SHEET 55

SLM 4.72, 24"
SEE SHEET 56

SLM 4.58, 30"
SEE SHEET 55

SLM 4.72, 24"
SEE SHEET 56

SLM 4.58, 18"
SEE SHEET 55

SLM 4.72, 18"
SEE SHEET 56

CFN 180710474
SLM 4.72, 36"
SEE BELOW

SEE 2001 CUY-71-0.00 PLANS FOR
MODIFICATIONS TO STORM SEWERS

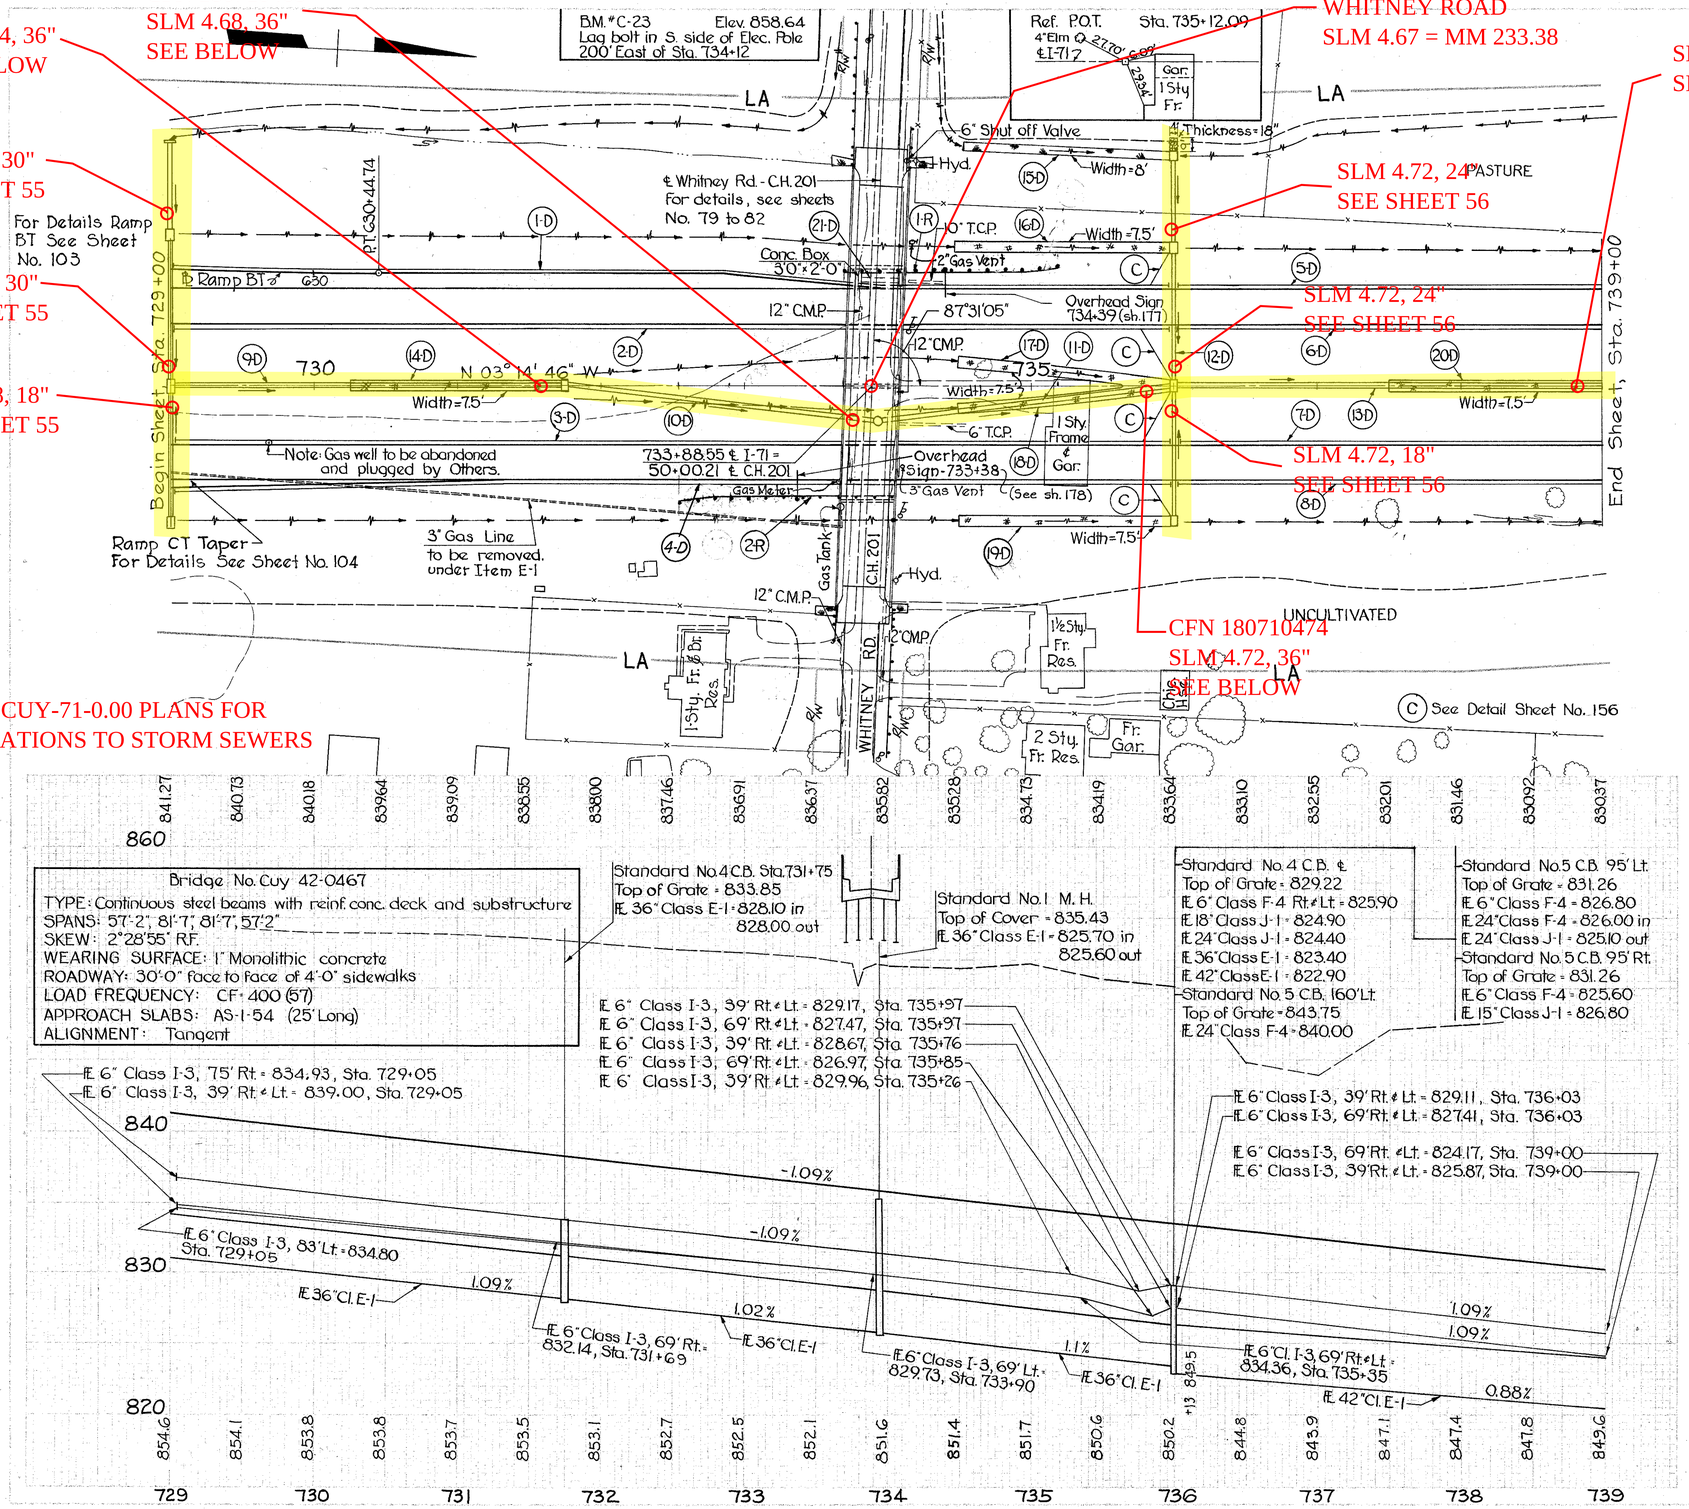

Sta. 729+00 to Sta. 739+00

ESTIMATED QUANTITIES

REF NO.	STATION TO STATION	SIDE	Class J-1 Pipe 18" Lin.Ft.	Class J-1 Pipe 24" Lin.Ft.	Class E-1 Pipe 36" Lin.Ft.	Class E-1 Pipe 42" Lin.Ft.	Class I-3 Pipe 6" Shallow Lin.Ft.	Class I-3 Pipe 6" Deep Lin.Ft.	Class F-4 Pipe 6" Lin.Ft.	Class F-4 Pipe 24" Lin.Ft.	Pipe Special Class I-3 Wye 6-60° Each	Std. No. 1 M.H. Each	Std. No. 4 C.B. Each	Std. No. 5 C.B. Each	Dumped Rock Channel Prot. Cu. Yd.	Guard Rail Lin.Ft.	Sodding Sq. Yd.	Jute Matting Sq. Yd.	Removal of Existing Structure Lump	SEE SHEET NO.
1-D	729+05 to 735+97	Lt.					710		10		1									
2-D	729+05 to 735+97	Lt.					726		10		1									
3-D	729+05 to 735+97	Rt.					726		10		1									
4-D	729+05 to 735+97	Rt.						710	10		1									
5-D	736+03 to 739+00	Lt.						297												
6-D	736+03 to 739+00	Lt.					297													
7-D	736+03 to 739+00	Rt.					297													
8-D	736+03 to 739+00	Rt.					297													
9-D	729+00 to 731+75	Med.			275															
10-D	731+75 to 733+93	Med.			218								1							
11-D	733+93 to 736+00	Med.			207															
12-D	736+00 to 739+00	Lt. & Rt.	92	92						64										56
13-D	736+00 to 739+00	Med.				300														
14-D	730+25 to 731+75	Med.															133			
15-D	734+50 to 736+00	Lt.															133			
16-D	734+50 to 736+00	Lt.															133			
17-D	734+50 to 736+00	Med.															133			
18-D	734+50 to 736+00	Med.															133			
19-D	734+50 to 736+00	Rt.															133			
20-D	737+50 to 739+00	Med.															133			
21-D	734+00	Lt.																	Lump	
1-R	733+69 to 735+19	Lt.													150					183
2-R	732+54 to 734+04	Rt.													150					183
TOTALS			92	92	700	300	2046	2014	40	64	4	1	2	3	2	300	133	798	Lump	