


SEEDING  
END Sq.  
Width Yds.

ESTIMATED QUANTITIES  
 I-1 15" Cl. J-1 Pipe = 116 LF  
 I-1 18" Cl. J-1 Pipe = 108 LF  
 I-8 Std. No. 4 C.B. = 1 Ea.  
 I-8 Std. No. 5 C.B. = 2 Ea.

Sta. 722+75 -  $\pm$  Median  
 Std. No. 4 C.B. = 843.71  
 Top of Grate = 838.84  
 # 15" Cl. J-1 = 838.59  
 # 18" Cl. J-1 = 838.09

Sta. 722+75 - 116' Rt  
 Std. No. 5 C.B. = 843.00  
 Top of Grate = 840.00  
 # 15" Cl. J-1 = 840.00

CUYAHOGA COUNTY  

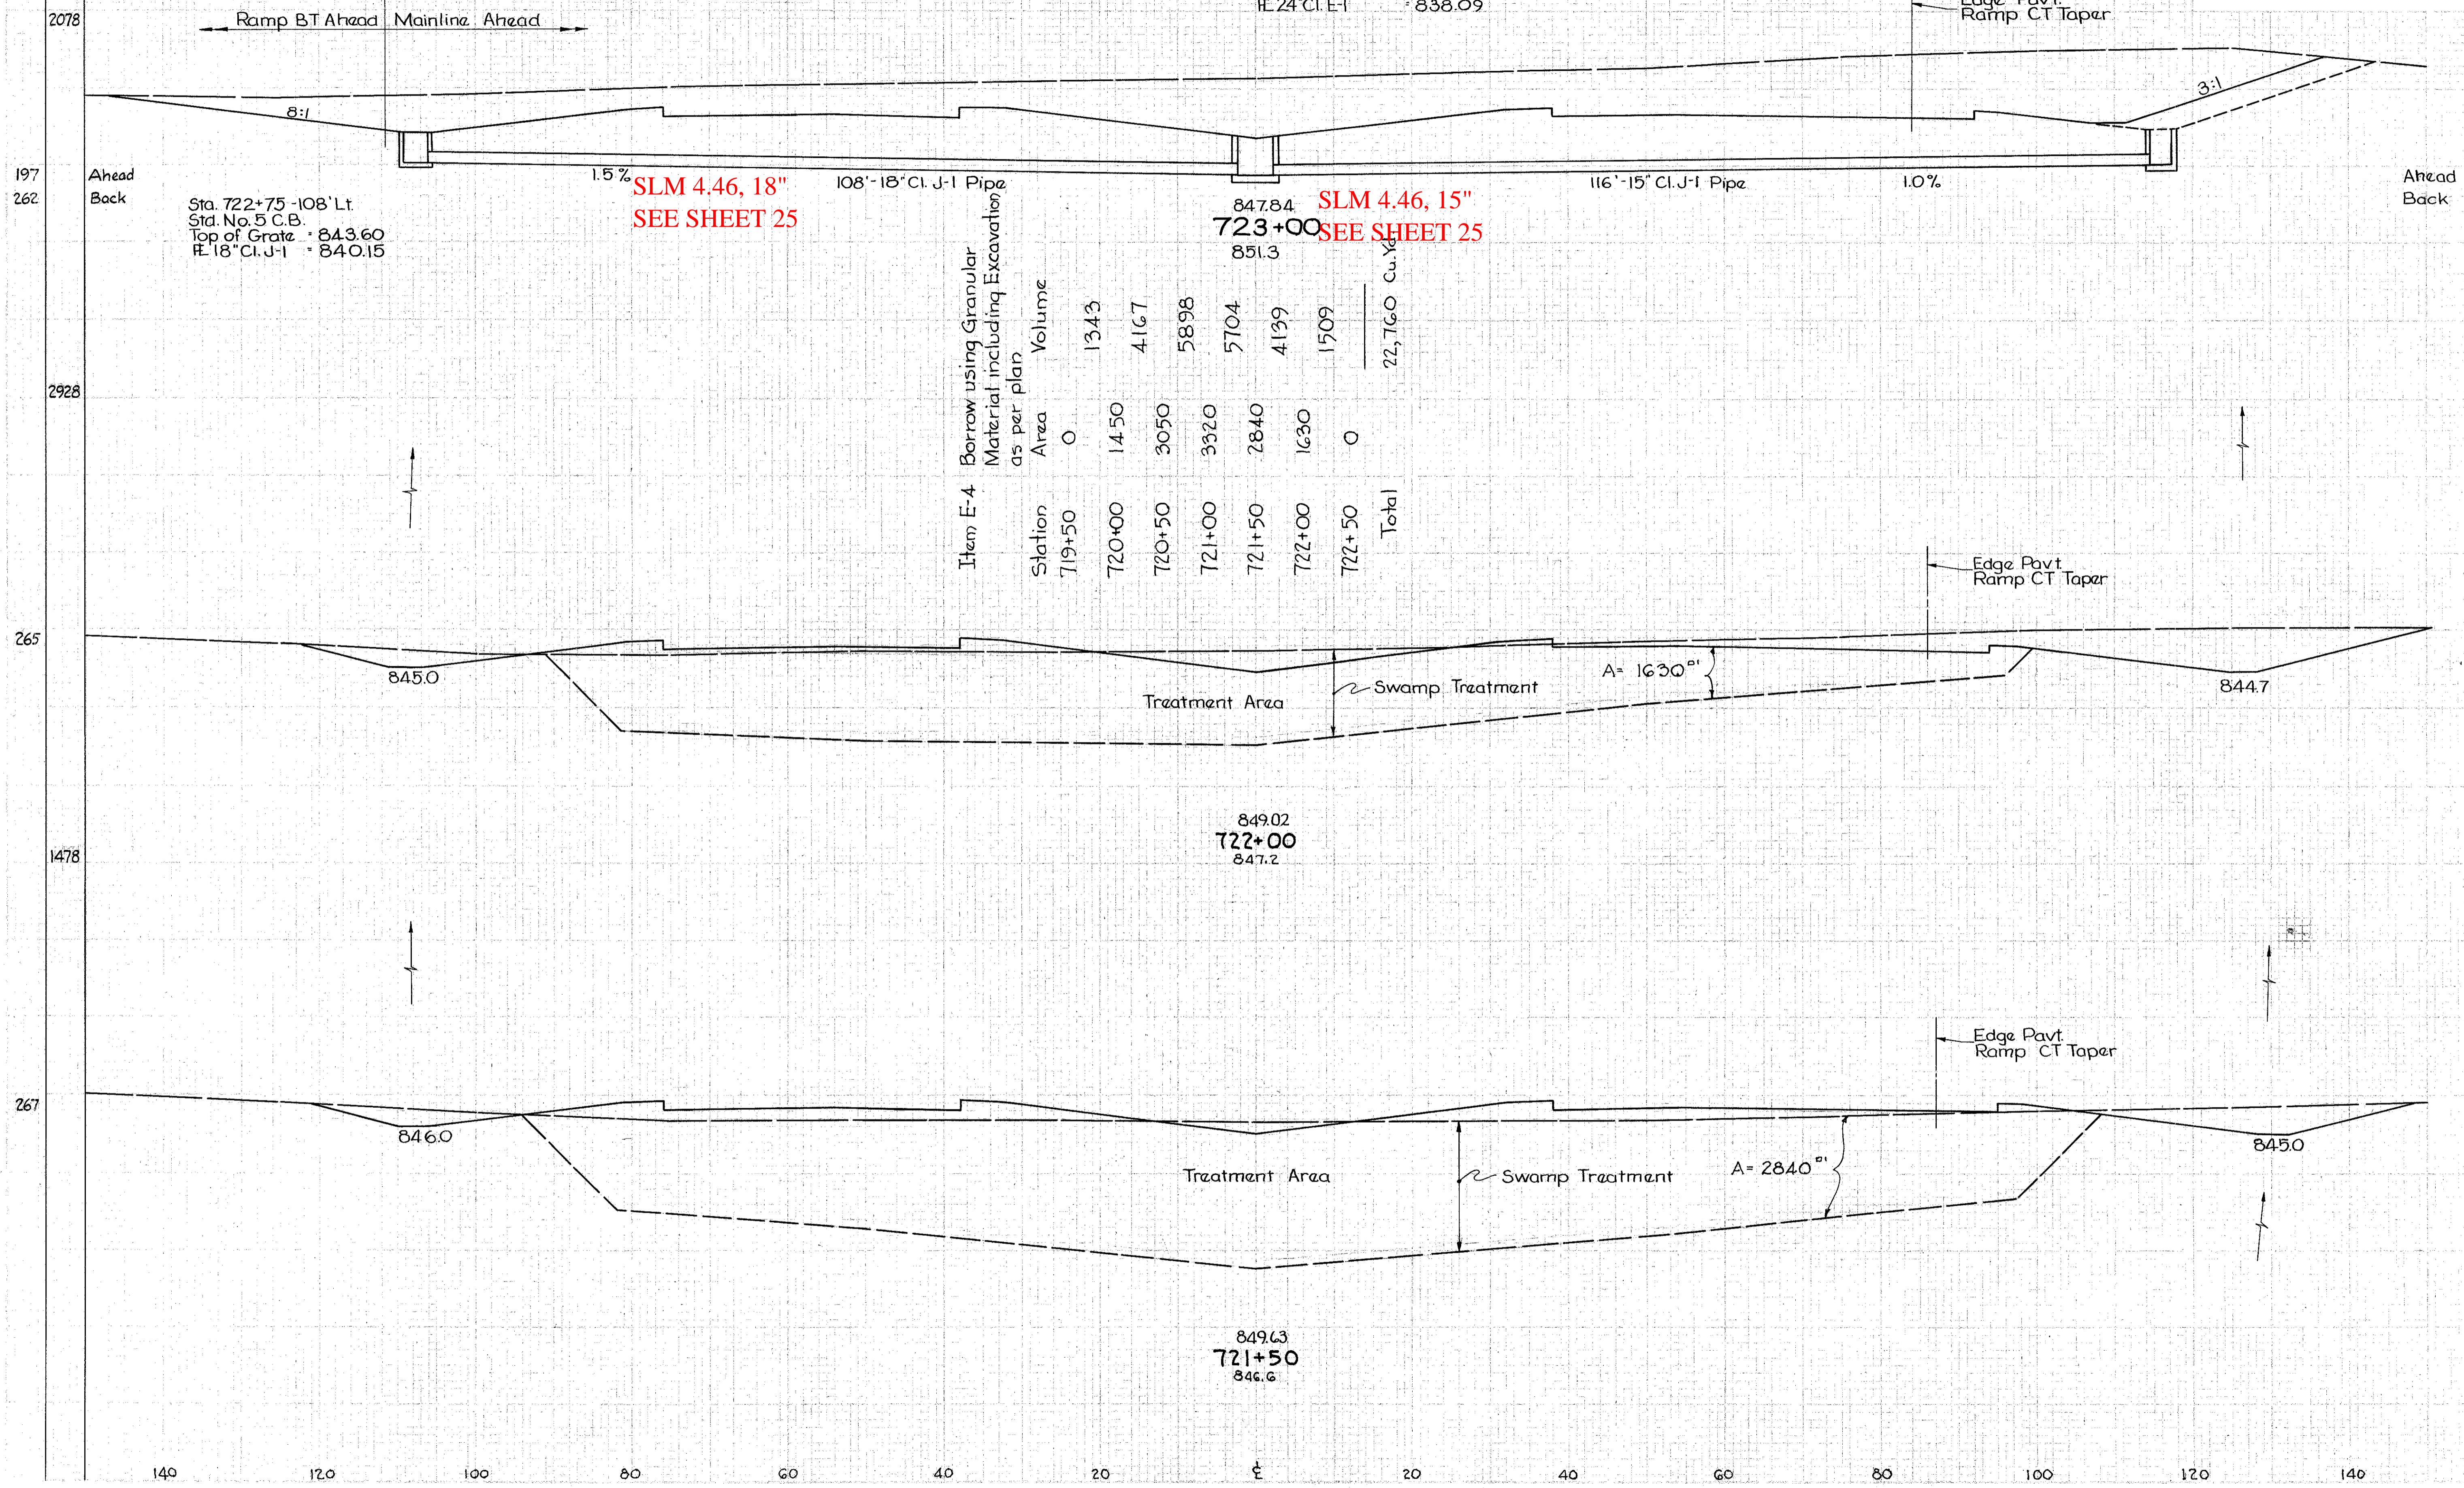

END AREA	Cu. Yds.	
	CUT	FILL
		72.78 0
Ahead 1399	0	
Back 1484	0	
		3409 131
		356 70
		463 274
		144 226