End Area		Cu. Yds.	
Cut	Fill	Cut	Fill
2.5	0		
		3.5	4.2
5	9		
		7.8	21.3
3.5	14		
		4.1	29.6
1	18		
		7.4	49.1
3	8.5		
		5.6	13.9
3	6.5		
		5.1	18.9
2.5	15		
		11.1	39.8

Embd. 292.6 Cu. Yds.

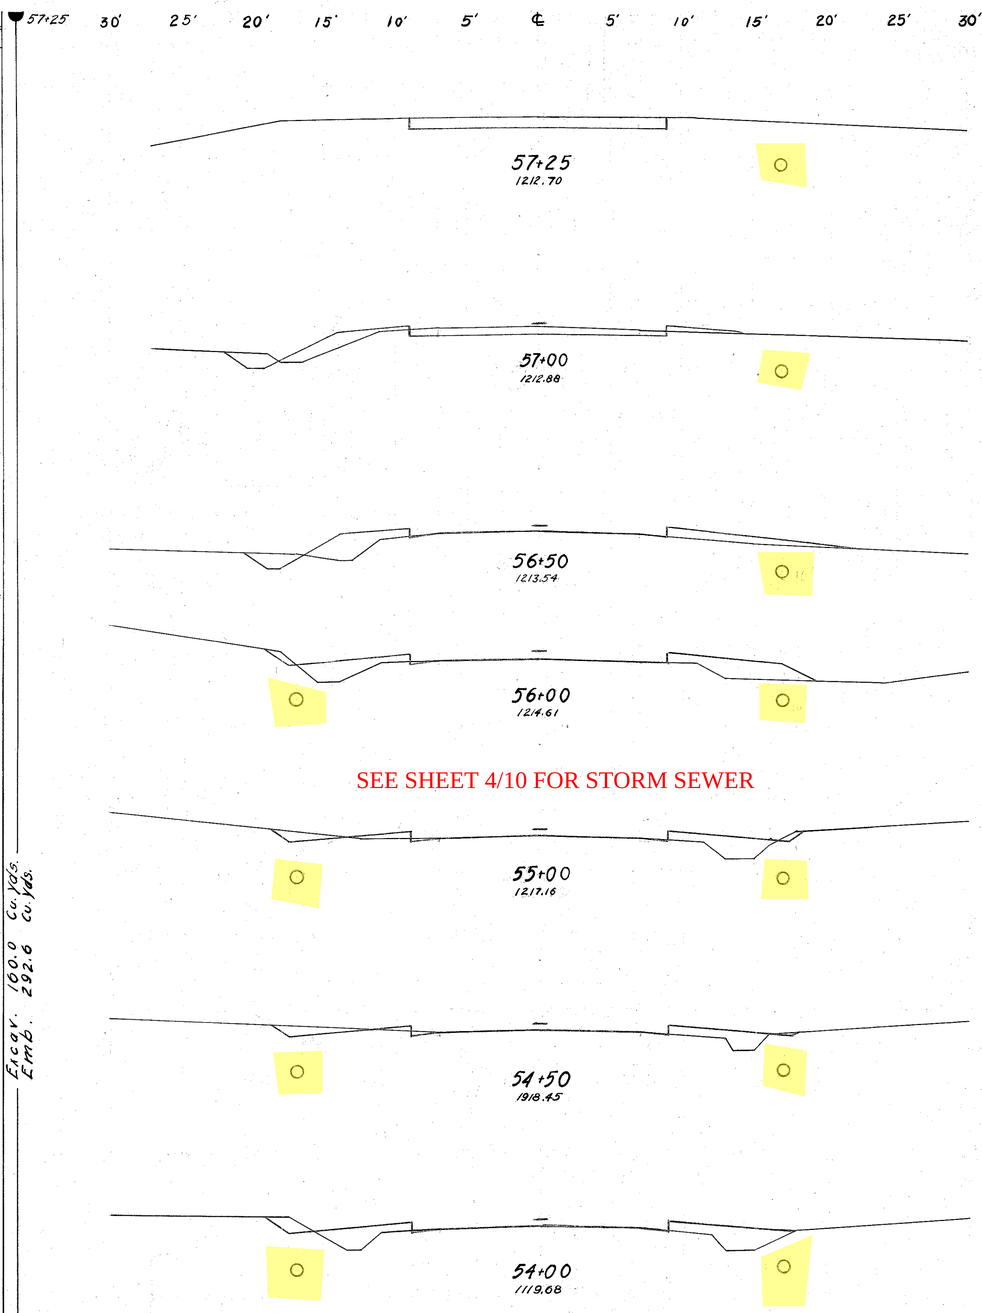

SEE SHEET 4/10 FOR STORM SEWER

End Area		Cu. Yds.	
Cut	Fill	Cut	Fill

30' 25' 20' 15' 10' 5' ℄ 5' 10' 15' 20' 25' 30'

9/10

I·C·H· 15 SEC. E
GEAUGA COUNTY