


SEEDING	SEEDING
WIDTH	AREA
Lin. Ft.	Sq. Yds.

2	OHIO			27 83
---	------	--	--	----------

GEAUGA COUNTY
GEA. 322-17.82

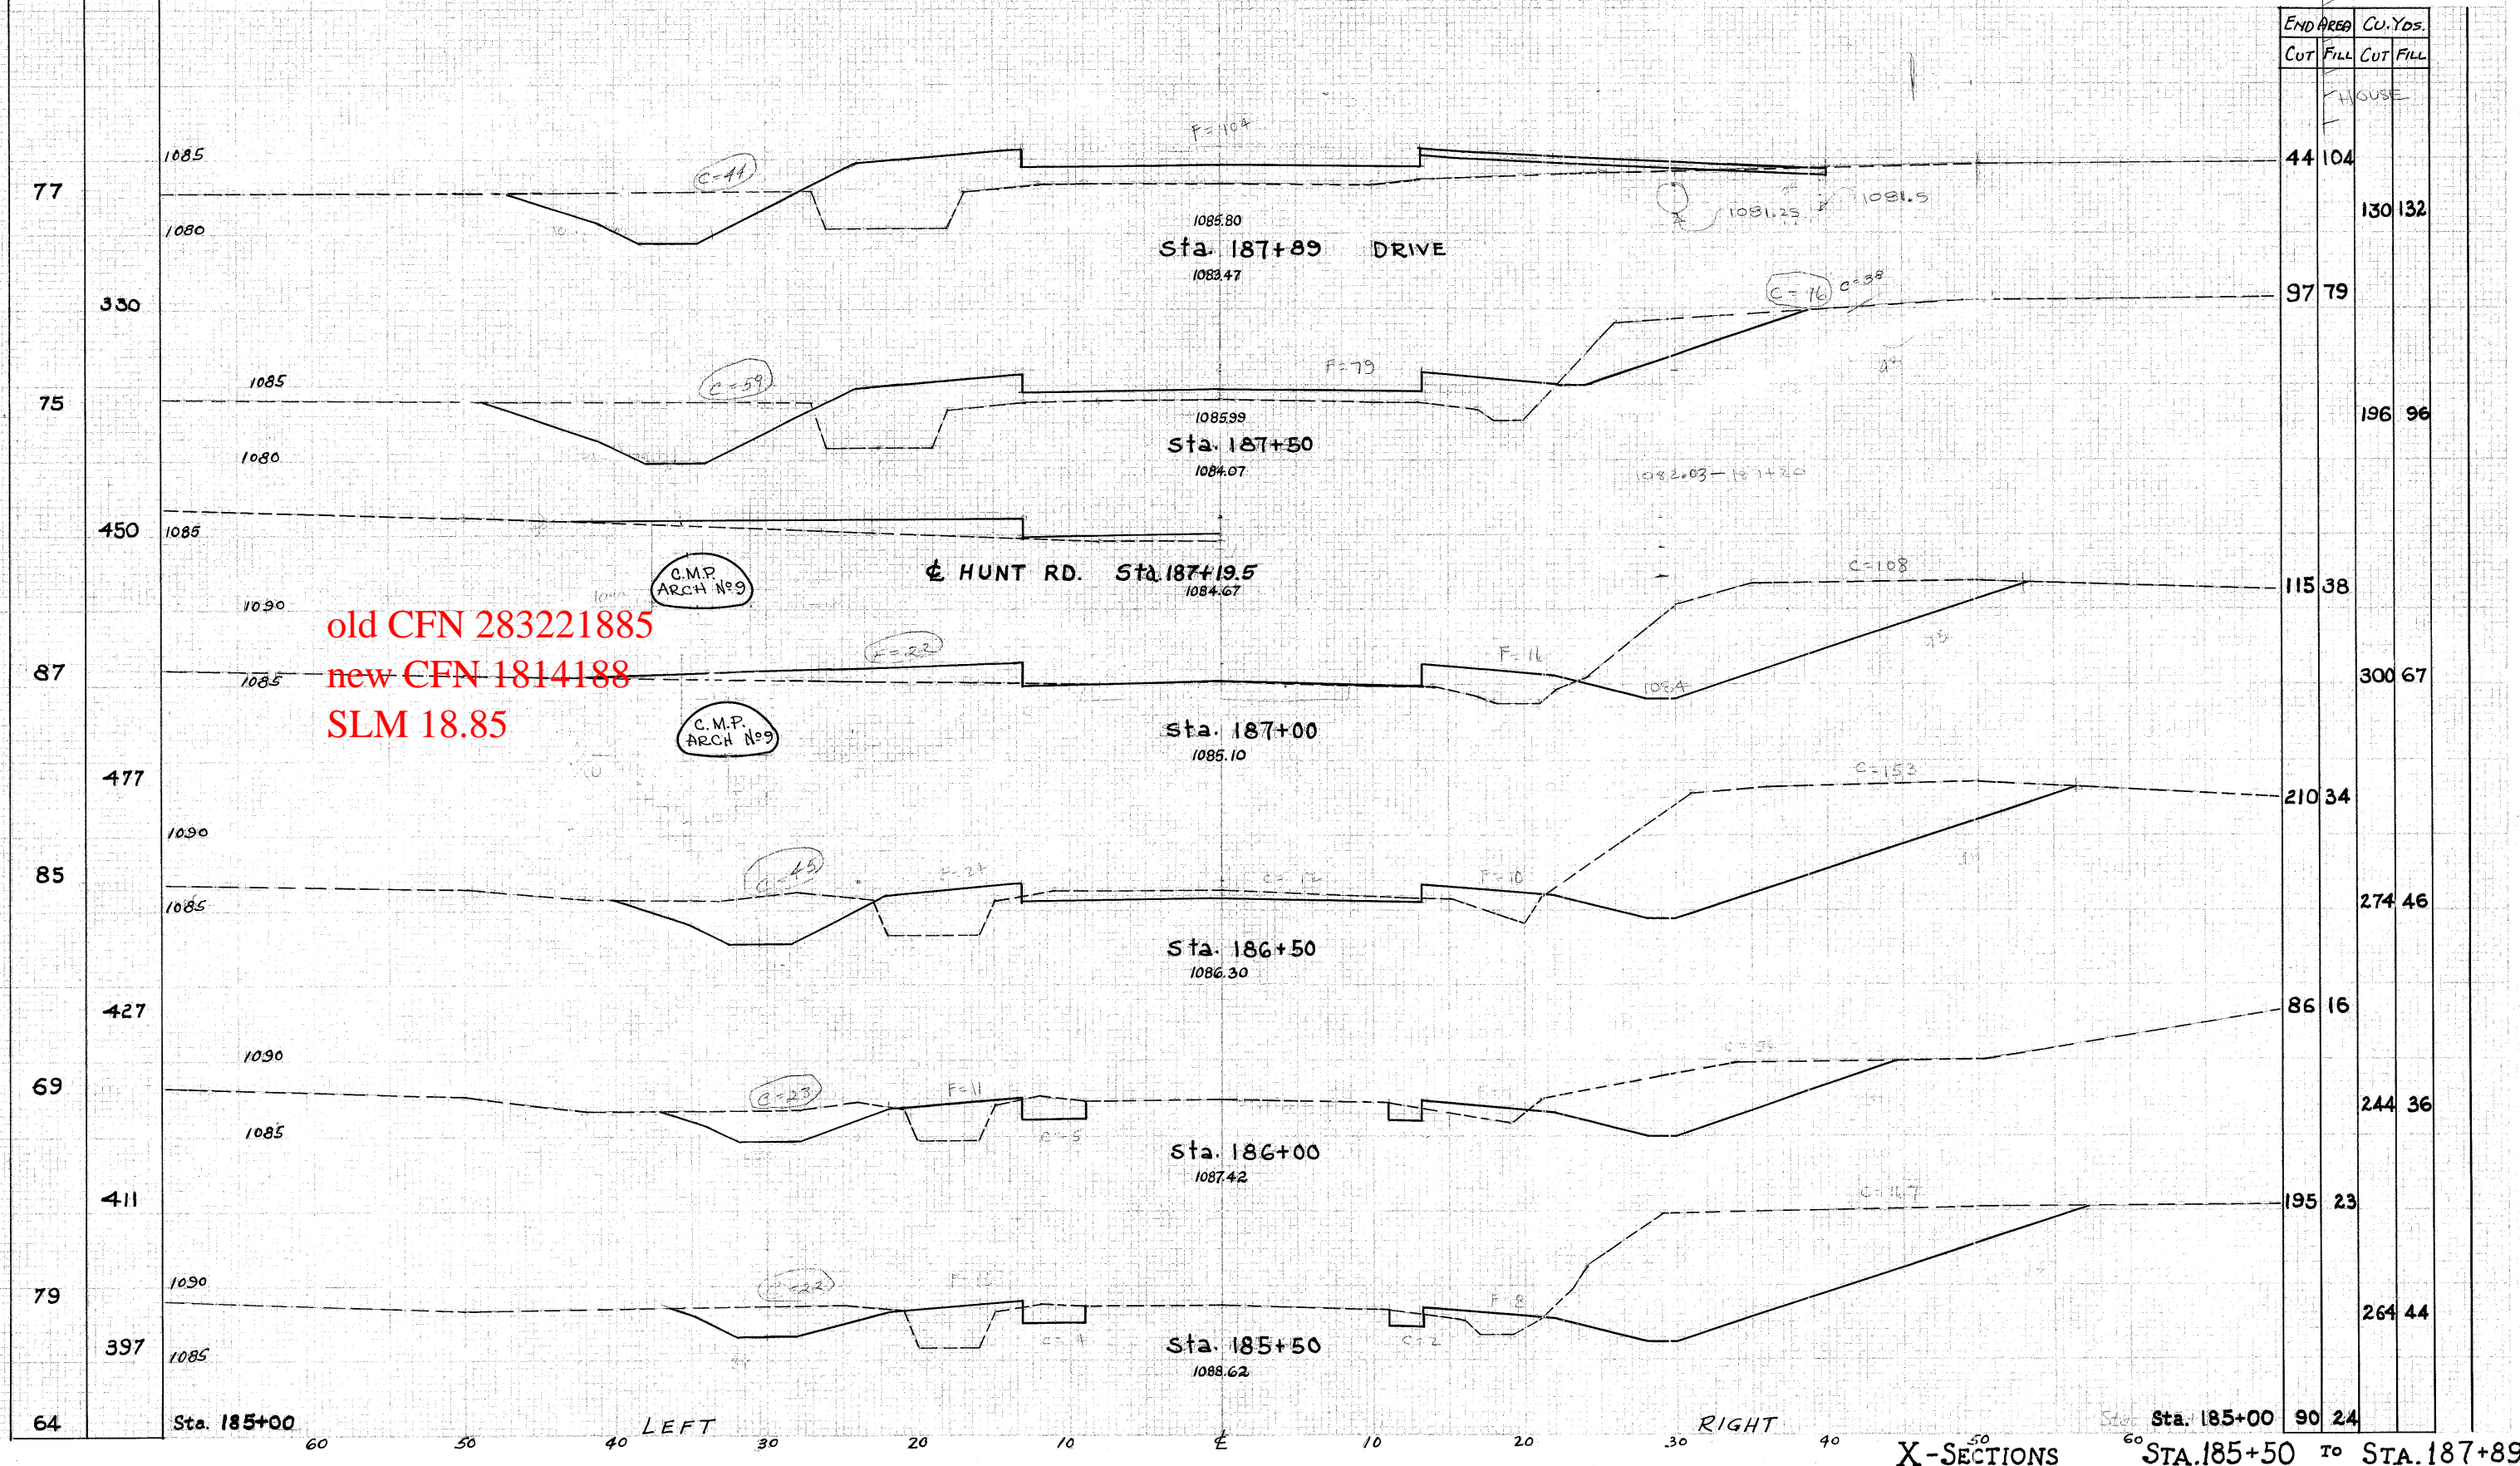

END AREA	Cu. Yds.	
	CUT	FILL
44	104	
		130 132
97	79	
		196 96
115	38	
		300 67
210	34	
		274 46
86	16	
		244 36
195	23	
		264 44
90	24	

X-SECTIONS STA. 185+50 TO STA. 187+89