


Left	+	Right
Edge of Pav't	Station	Grade Elev.
1034.58	10.00	49+33.36 1034.83
1034.94	10.01	50+00 1035.19
1036.03	10.11	+18.36 1036.28
1037.70	10.44	+43.36 1037.95
1038.17	10.55	+50 1038.42
1039.57	10.99	+68.36 1039.82
1041.66	11.81	+93.36 1041.91
1042.25	12.05	51+00 1042.50
1043.84	12.54	+18.36 1044.09
1045.83	12.83	+43.36 1046.08
1046.32	12.83	+50 1046.57
1048.04	12.83	+75 1048.29
1049.55	12.83	52+00 1049.80
1050.84	12.83	+25 1051.09
1051.96	12.83	+50.89 1052.21
1052.82	12.54	+75.89 1053.07
1053.45	11.81	53+00 1053.70
Extra Pavement 73.25 Sq. Yds.		
Widening for 18" Pav't. used.		

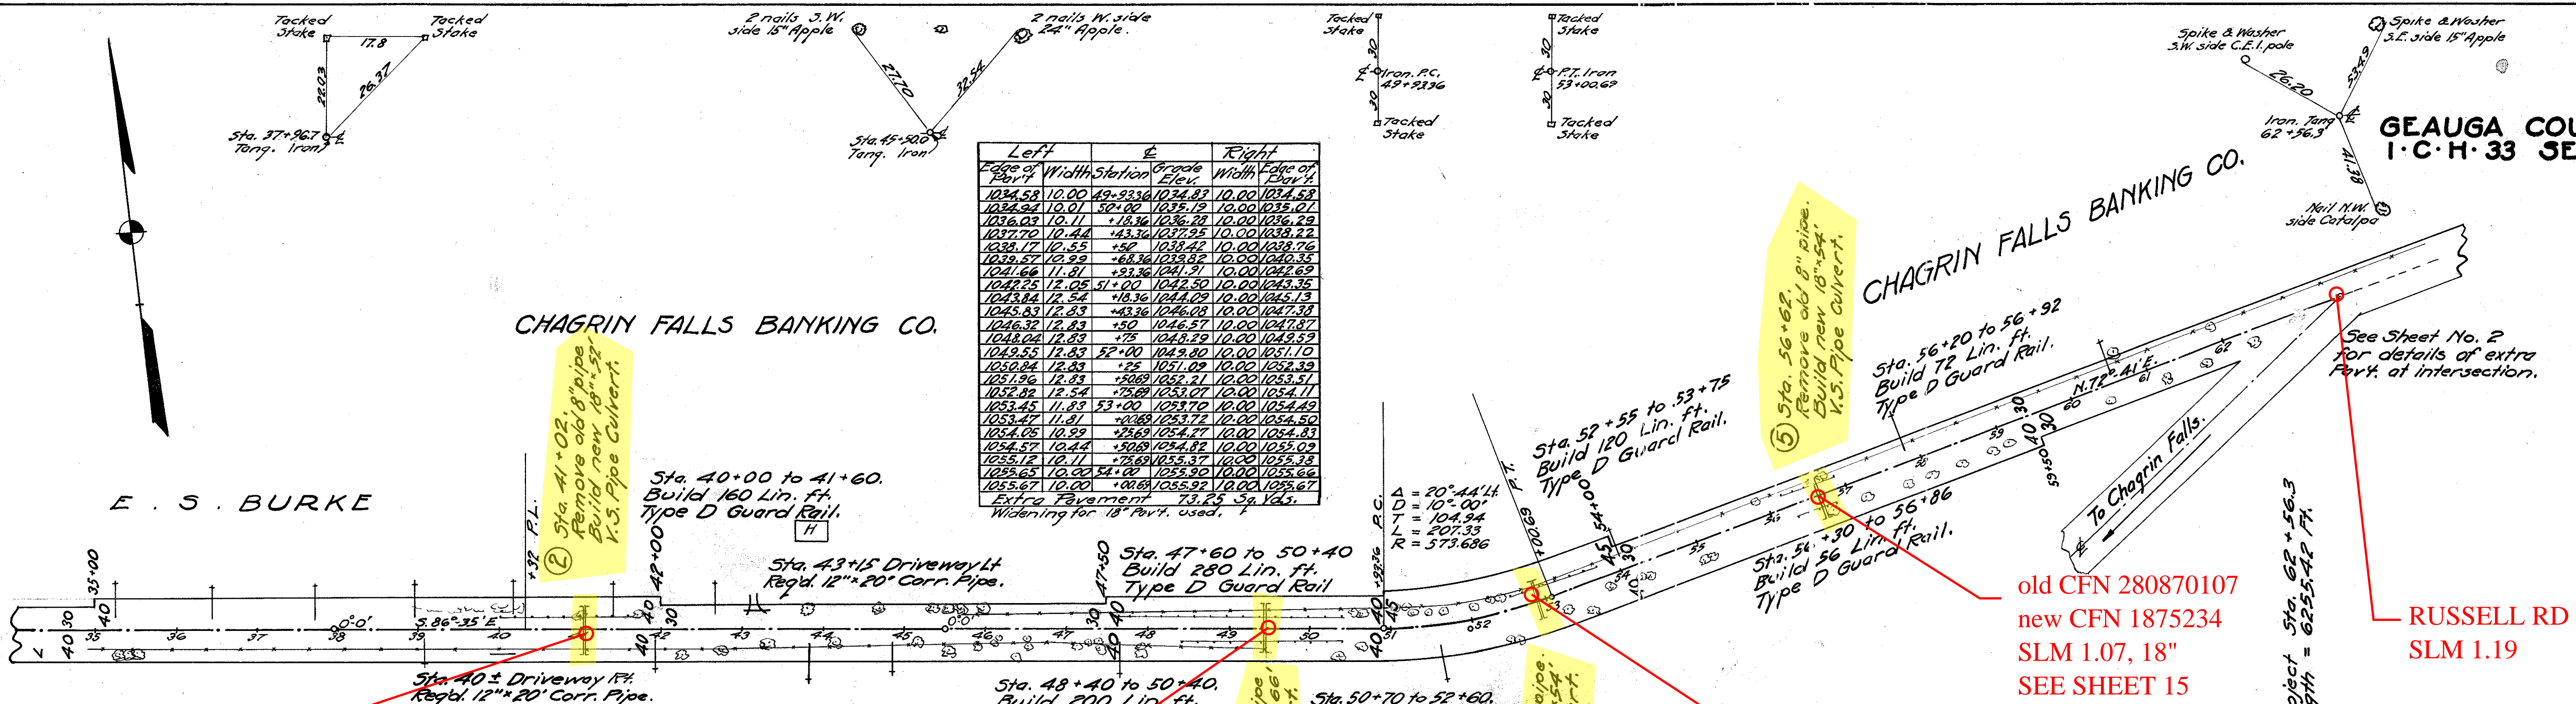


old CFN 280870078  
new CFN 1846135  
SLM 0.78, 18"  
SEE SHEET 15

old CFN 280870094  
new CFN 1875232  
SLM 0.94, 18"  
SEE SHEET 15

old CFN 280870100  
new CFN 1875233  
SLM 1.00, 18"  
SEE SHEET 15

old CFN 280870107  
new CFN 1875234  
SLM 1.07, 18"  
SEE SHEET 15

RUSSELL RD  
SLM 1.19

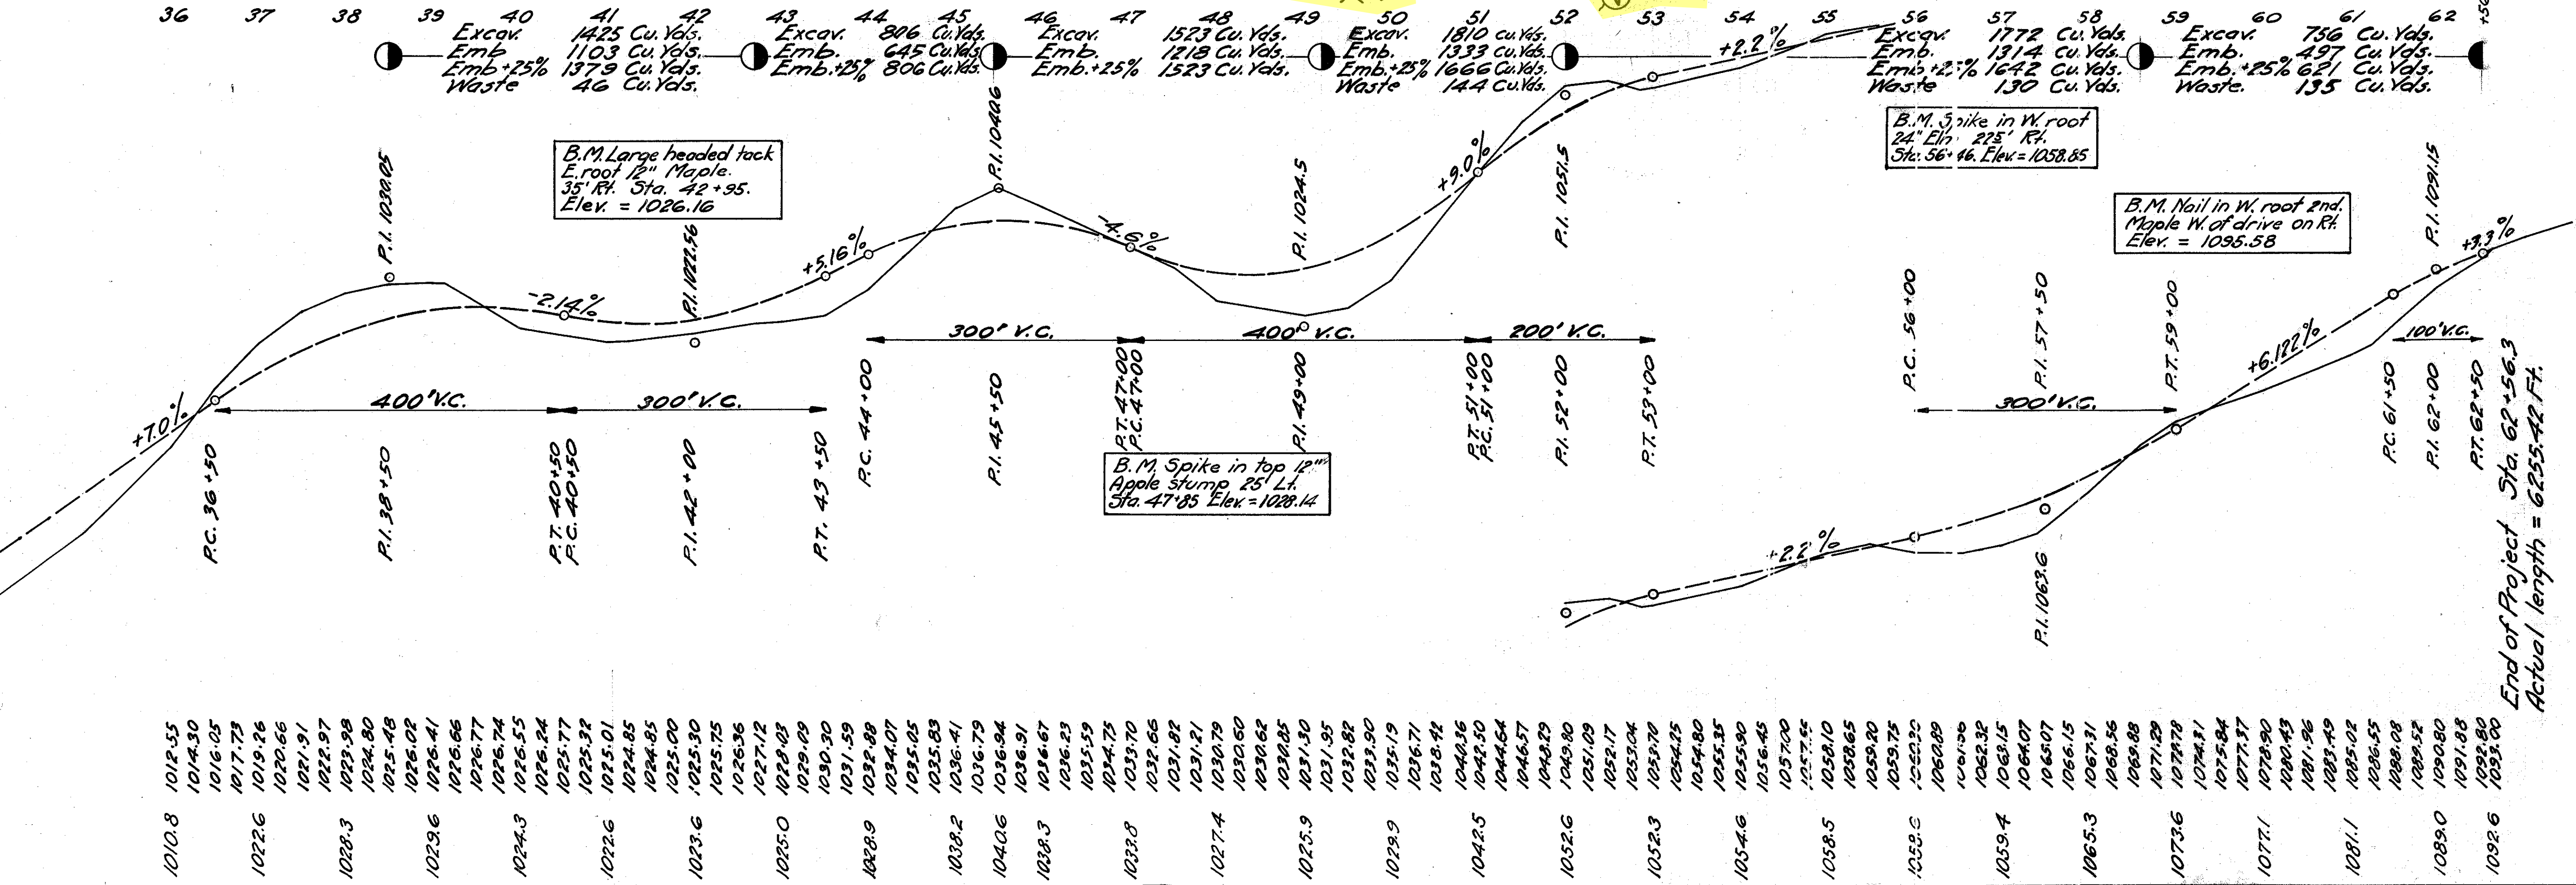

1010.8	1012.55
1014.30	1014.30
1016.05	1016.05
1017.79	1017.79
1019.26	1019.26
1020.66	1020.66
1021.91	1021.91
1022.97	1022.97
1024.80	1024.80
1025.48	1025.48
1026.09	1026.09
1026.41	1026.41
1026.66	1026.66
1026.77	1026.77
1026.55	1026.55
1026.24	1026.24
1025.77	1025.77
1025.32	1025.32
1025.01	1025.01
1024.85	1024.85
1024.00	1024.00
1023.30	1023.30
1023.75	1023.75
1026.96	1026.96
1027.12	1027.12
1028.03	1028.03
1029.09	1029.09
1030.50	1030.50
1031.59	1031.59
1032.88	1032.88
1034.07	1034.07
1035.05	1035.05
1035.89	1035.89
1036.41	1036.41
1036.79	1036.79
1036.94	1036.94
1036.91	1036.91
1036.67	1036.67
1036.23	1036.23
1035.59	1035.59
1034.75	1034.75
1033.70	1033.70
1032.66	1032.66
1031.82	1031.82
1031.21	1031.21
1030.79	1030.79
1030.60	1030.60
1030.62	1030.62
1030.85	1030.85
1031.30	1031.30
1031.95	1031.95
1032.89	1032.89
1033.90	1033.90
1035.19	1035.19
1036.71	1036.71
1038.44	1038.44
1040.36	1040.36
1042.50	1042.50
1044.64	1044.64
1046.57	1046.57
1048.29	1048.29
1049.80	1049.80
1051.09	1051.09
1052.17	1052.17
1053.04	1053.04
1053.70	1053.70
1054.45	1054.45
1054.80	1054.80
1055.35	1055.35
1055.90	1055.90
1056.45	1056.45
1057.00	1057.00
1057.55	1057.55
1058.10	1058.10
1058.65	1058.65
1059.20	1059.20
1059.75	1059.75
1060.30	1060.30

End of Project Sta. 62+56.3  
Actual length = 6255.42 Ft.