


Transition & Superelevation Curve Data

Stations	Grade Elev. E	Lt. & Outside Dist. ft.	Elev.	Rt. & Inside Dist. ft.	Elev.	Extra Cur. Sq. Yds.	
584+15.68	P.T.C.	1202.67	8.0	1202.59	8.00	1202.59	0.0
+44.68	+25	1202.82	8.0	1202.91	8.31	1202.74	0.4
+65.68	P.C.	1202.97	8.0	1203.27	8.86	1202.89	1.6
+94.68	+25	1203.12	8.0	1203.59	9.38	1203.04	3.1
585+15.68	E.T.C.	1203.27	8.0	1203.93	9.60	1203.19	4.1
+25.00		1203.30	8.0	1203.96	9.60	1203.22	1.6
+50.00		1203.36	8.0	1204.02	9.60	1203.28	4.4
586+00.00		1203.30	8.0	1203.96	9.60	1203.22	8.9
+50.00		1203.01	8.0	1203.67	9.60	1202.93	8.9
+78.18	E.C.C.	1202.74	8.0	1203.40	9.60	1202.66	5.0
587+03.18	+25	1202.44	8.0	1202.91	9.38	1202.36	4.1
+28.18	P.T.	1202.11	8.0	1202.41	8.86	1202.03	3.1
+53.18	+25	1201.79	8.0	1201.88	8.31	1201.71	1.6
+78.18	P.T.T.	1201.46	8.0	1201.38	8.00	1201.38	0.4
Total = 47.2							

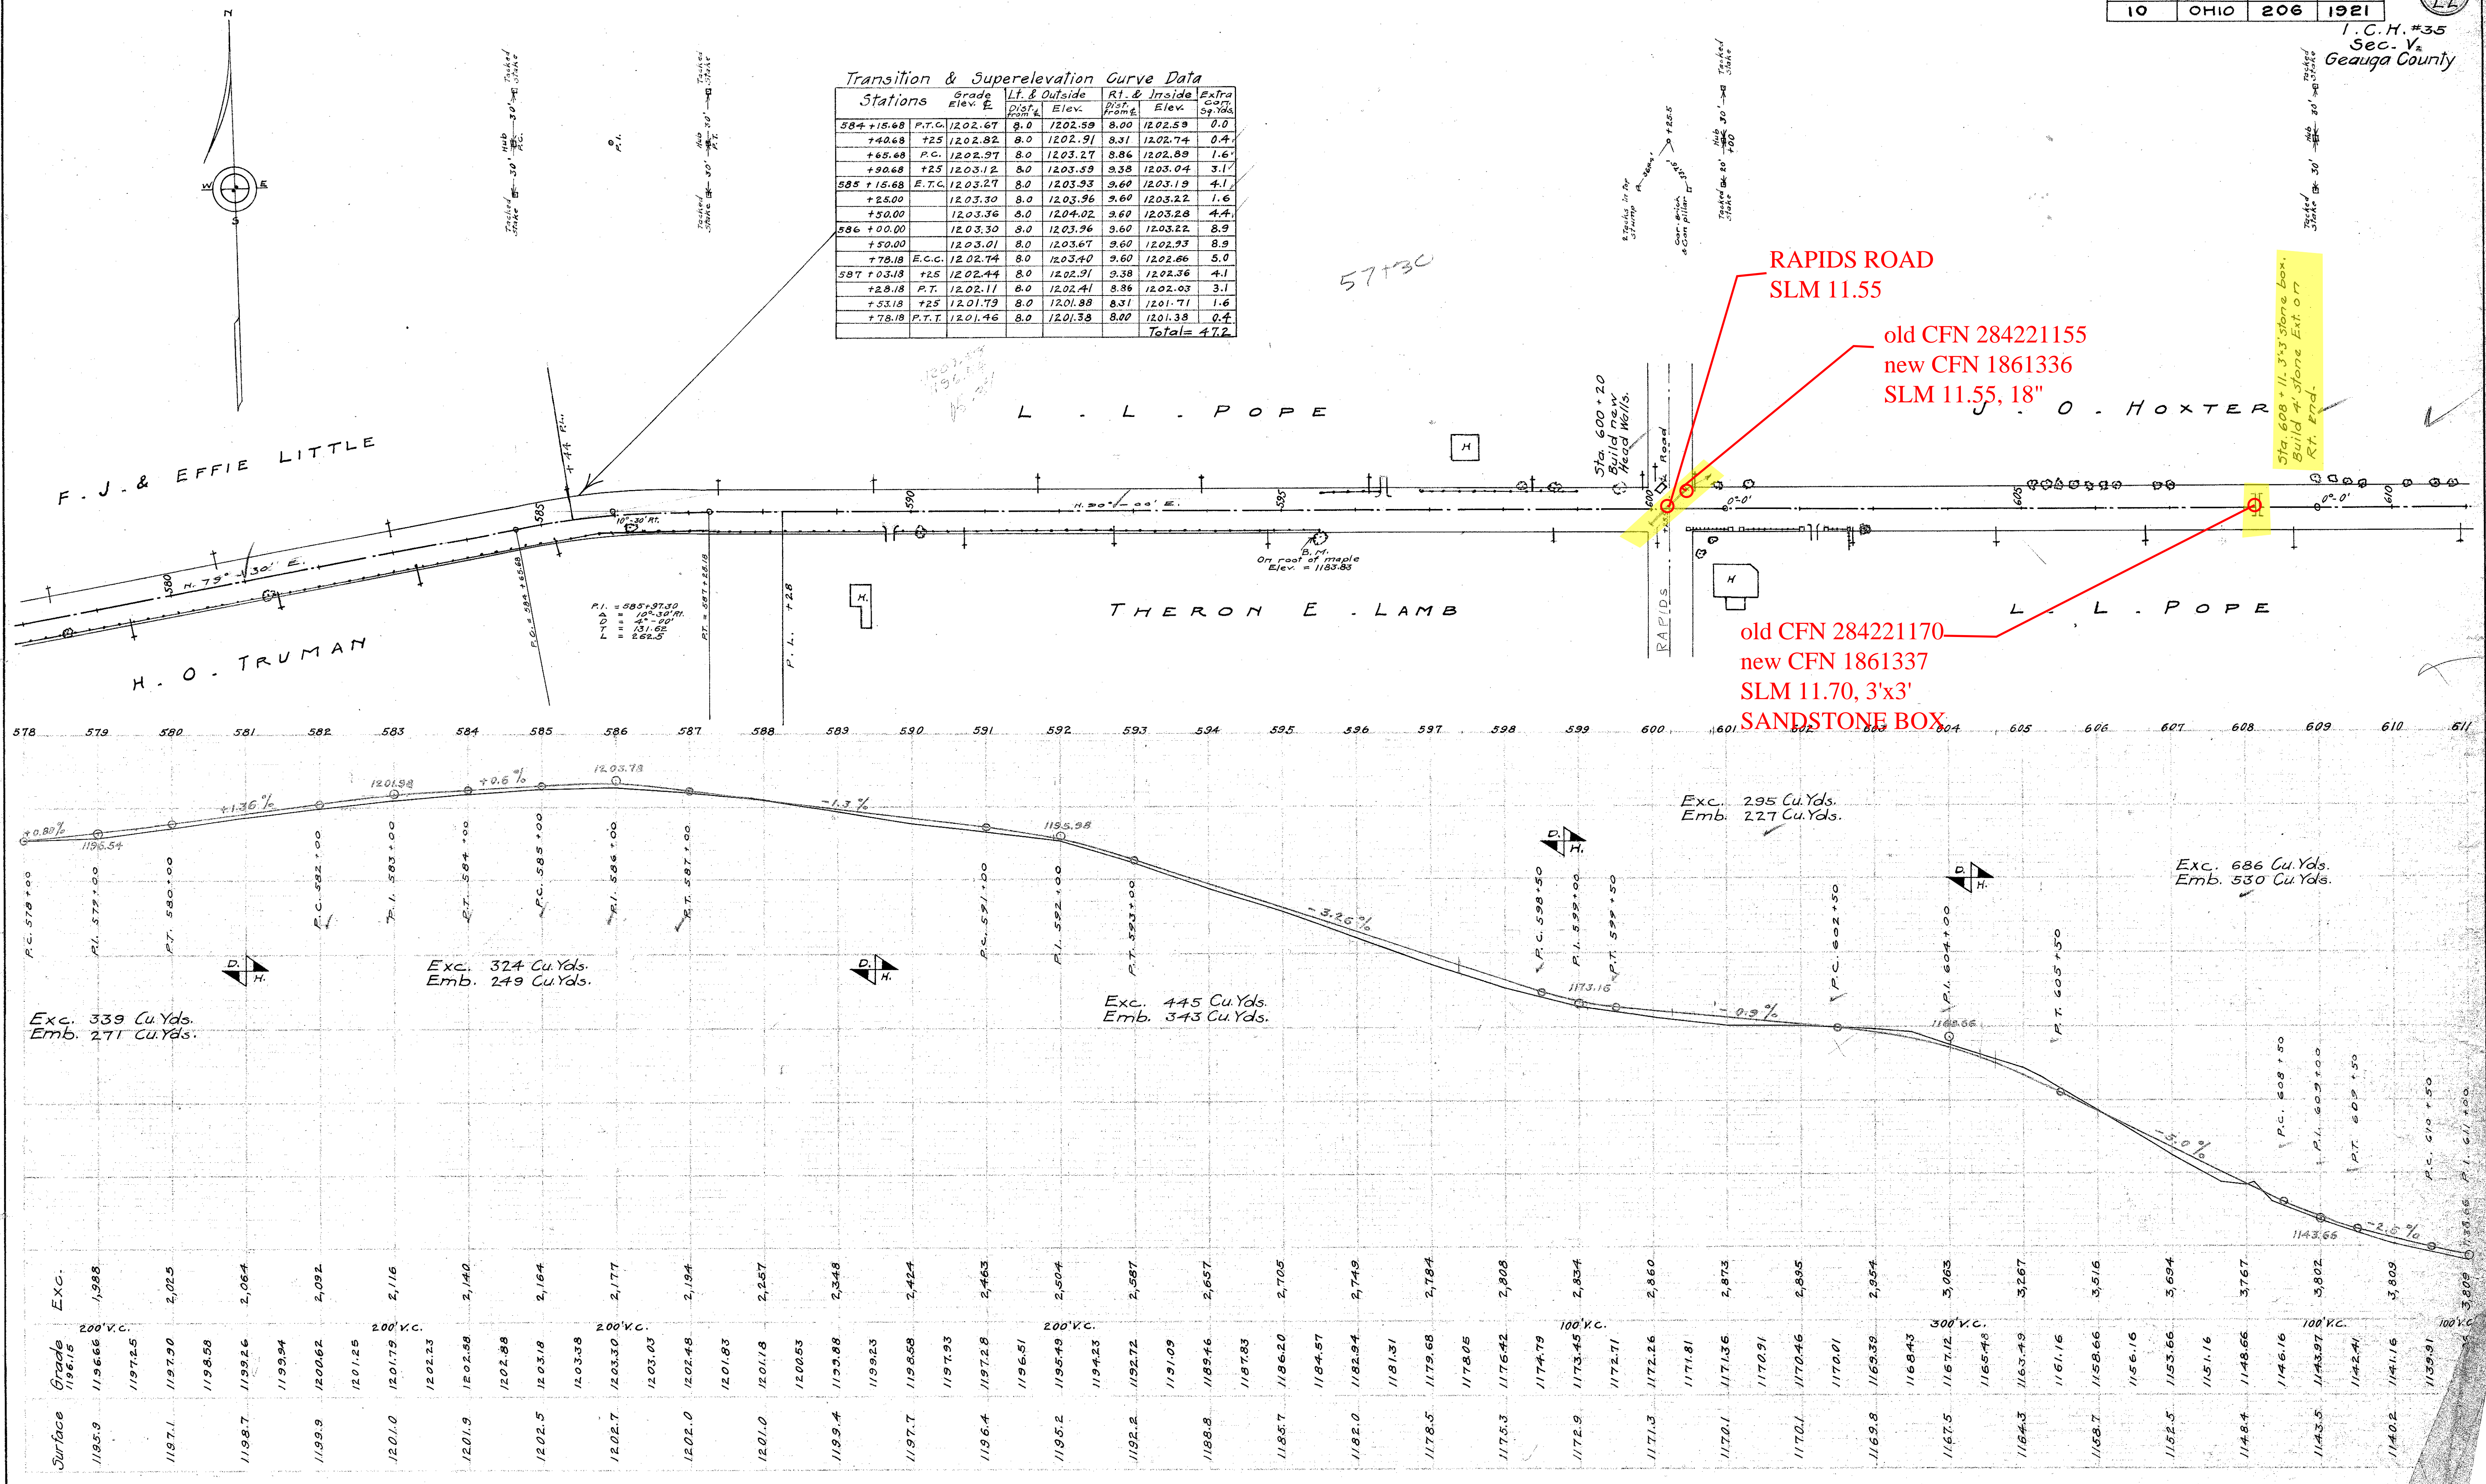

F. J. & EFFIE LITTLE
H. O. TRUMAN

L. L. POPE

Theron E. Lamb

J. O. HOXTER

Exc. 339 Cu. Yds.
Emb. 271 Cu. Yds.

Exc. 324 Cu. Yds.
Emb. 249 Cu. Yds.

Exc. 445 Cu. Yds.
Emb. 343 Cu. Yds.

Exc. 295 Cu. Yds.
Emb. 227 Cu. Yds.

Exc. 686 Cu. Yds.
Emb. 530 Cu. Yds.

Surface	Grade	Exc.
1185.9	1196.15	1,988
1197.1	1197.25	2,025
1199.7	1198.58	2,064
1199.9	1199.94	2,092
1201.0	1201.25	2,116
1201.9	1202.58	2,140
1202.5	1202.88	2,164
1202.7	1203.18	2,177
1202.0	1203.38	2,194
1201.0	1203.03	2,257
1199.4	1202.48	2,348
1197.7	1201.83	2,424
1196.4	1201.18	2,463
1195.2	1199.23	2,504
1192.2	1197.93	2,587
1189.8	1196.51	2,657
1185.7	1195.49	2,705
1182.0	1194.23	2,749
1178.5	1192.72	2,784
1175.3	1191.09	2,808
1172.9	1189.46	2,834
1171.3	1187.83	2,860
1170.1	1186.20	2,873
1170.1	1184.57	2,895
1169.8	1182.94	2,954
1167.5	1181.31	3,003
1164.3	1179.68	3,267
1158.7	1178.05	3,516
1152.5	1176.42	3,694
1148.4	1174.79	3,767
1143.5	1173.16	3,802
1140.2	1171.53	3,809
	1169.90	3,809